

S35 S36


S2 S1

T20S R10E

T21S R10E


T21S R10E, WM

DESCHUTES COUNTY, OREGON

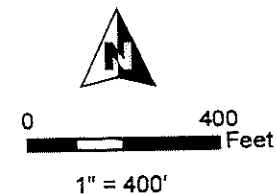

- Well
- ⊙ Meter
- Pipeline
- POU Nursery
- Township
- Section
- Quarter Quarter
- Tax Lot

Well (DESC 56961 / L-78985) Location:
377' S, 308' W of N 1/4 Cor Sec 1

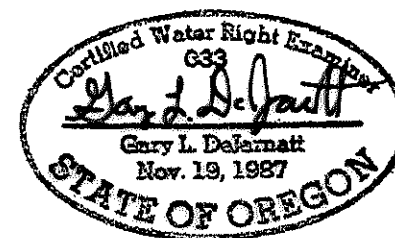

RENEWAL DATE 12/31/2021

RECEIVED

JUL 15 2020

OWRD



CLAIM OF BENEFICIAL USE MAP

William McMichael

AP G-18292

PERMIT G-17853

NOTE: THIS MAP IS NOT INTENDED TO
PROVIDE LEGAL DIMENSIONS OR LOCATIONS
OF PROPERTY OWNERSHIP LINES.

PROJECT #20019

WATER RIGHT SERVICES, LLC

PO BOX 1830, BEND, OR 97709
CCB# 197121 www.oregonwater.us
541-389-2837 JOHNSHORT@USA.COM