


Claim of Beneficial Use Permit G-17879, Application G-18399

A Water Right held by Utokla Farms LLC
Township 4 South, Range 2 East (W.M.)
Clackamas County

RECEIVED

JUL 07 2022

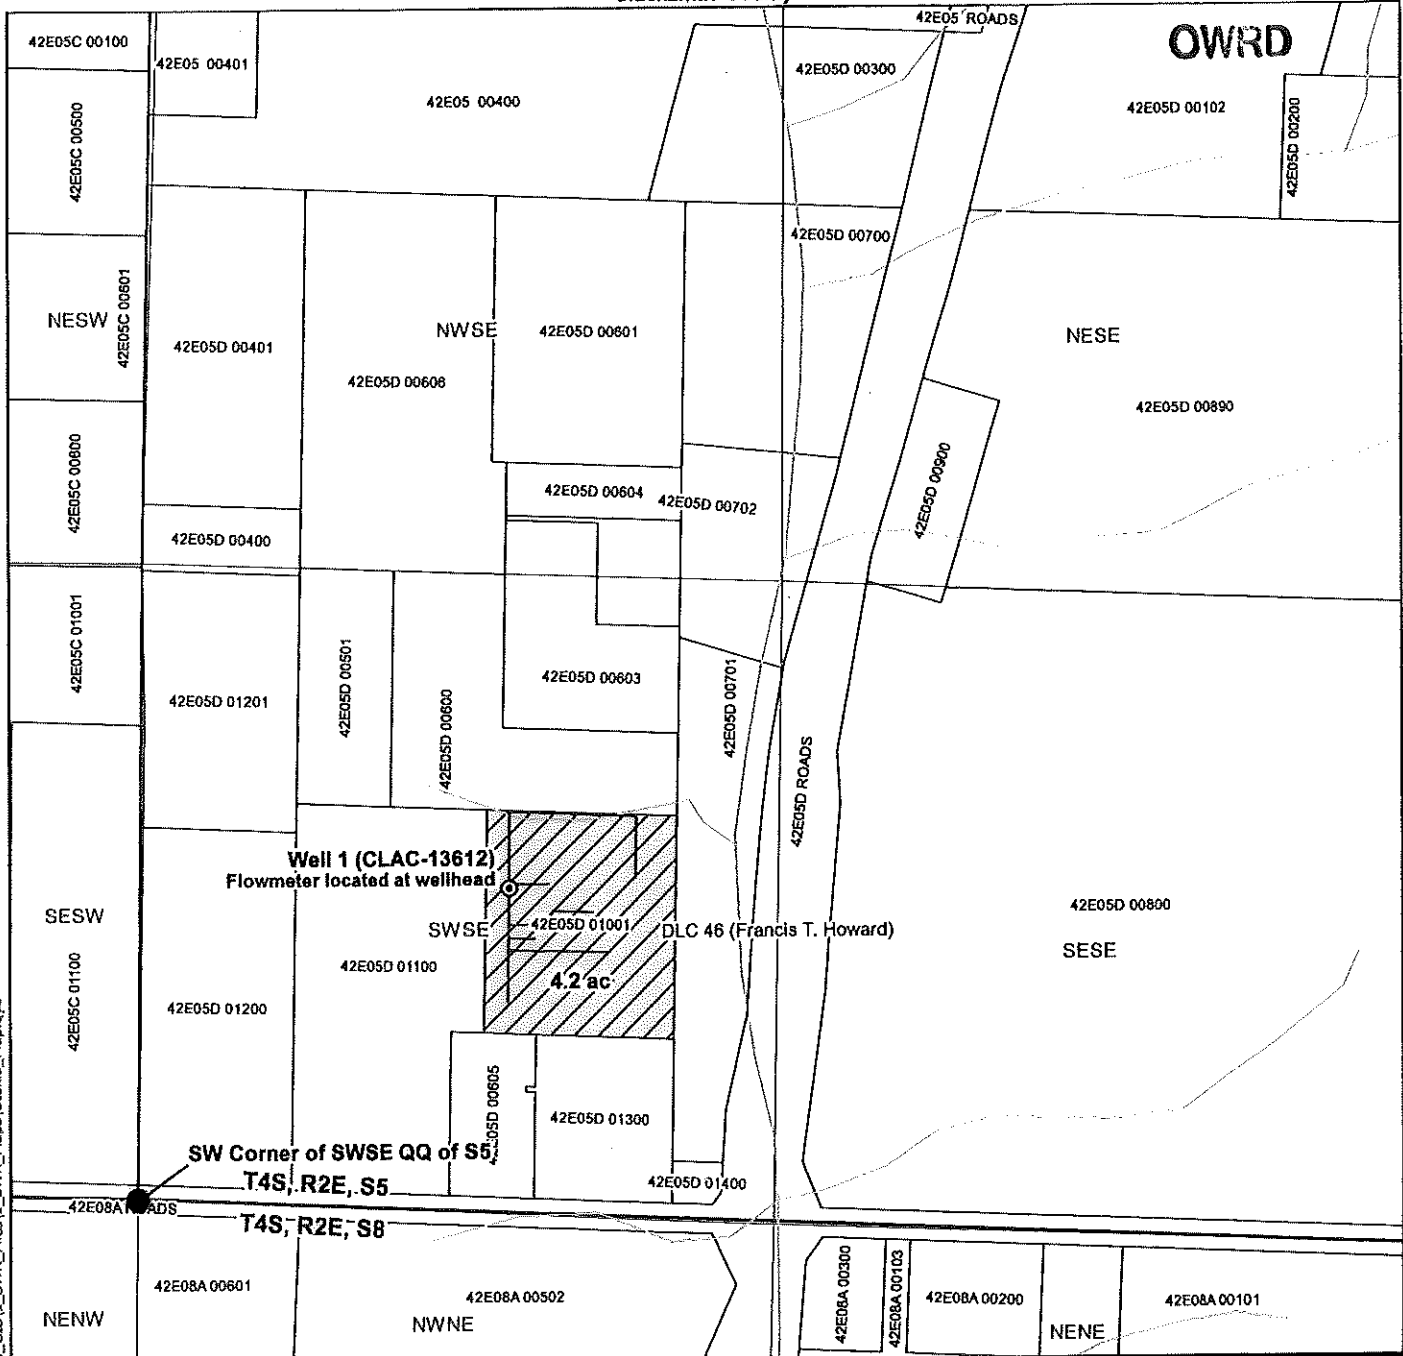


LEGEND

- ⊙ Point of Appropriation (POA)
- ▨ Place of Use (POU)
- Property Lines
- Donation Land Claim (DLC)
- ~ Streams
- ~ Conveyance Mains

POA Location Description

Well 1 (CLAC-13612, L-01071)
Located 665 feet North and 765 feet East from SW corner of
SWSE QQ of Section 5, Township 4 South, Range 2 East,
W.M.

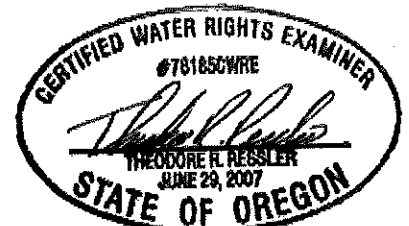

RENEWALS: 12-31-2022

CWRE Seal and Signature



Scale
0 200 400 ft
1-inch = 400 feet

Date: 6/9/2022
Data Sources: BLM, ESRI, OWRD, USGS, Clackamas Co.
Disclaimer: This map was prepared for the sole purpose of
identifying the location of a water right only and is not intended to
provide legal dimensions or the location of property ownership
lines.

