



Well Locations:

#4 (HARN 52299 / L-135026): 1970' N, 2280' E of SW Cor Sec 6
 #5 (HARN 52883 / L-135029): 1500' N, 1220' E of SW Cor Sec 6


**T27S R31E, WM,
 HARNEY COUNTY, OR**

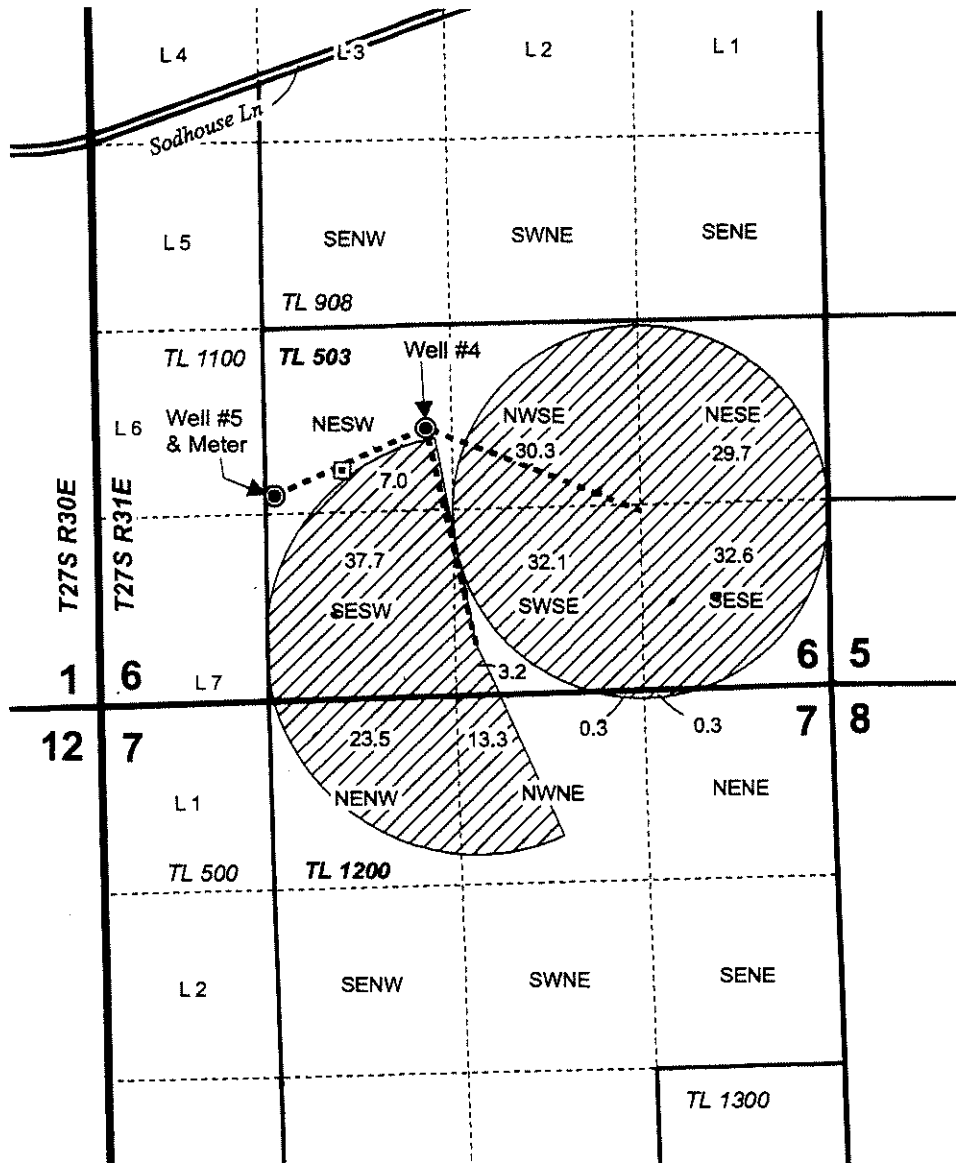

RECEIVED
 FEB 1 2023

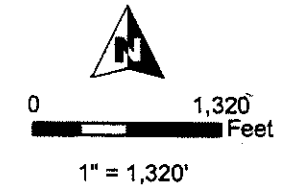

- Well
- Meter for Well #4
- Pipeline
- POU IR 6/17/2008 Priority
- Township
- Section
- Quarter Quarter
- Tax Lot

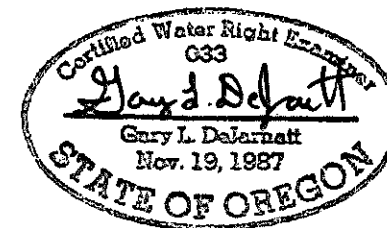

**CLAIM OF BENEFICIAL USE MAP
 JIM ROBEY**

T-12652

Date: 4/14/2022

Project #22008

This map is not intended
 to provide legal dimensions
 or locations of property
 ownership lines.

WATER RIGHT SERVICES, LLC
 PO BOX 1830, BEND, OR 97709
 WWW.OREGONWATER.US CCB # 197121-
 johnshort@usa.com 541-389-2837