Sections 20 & 21, T2S, R3W, W.M., Yamhill County, Oregon

CLAIM OF BENEFICIAL USE MAP
Transfer T-12736
Michael L. Peterson

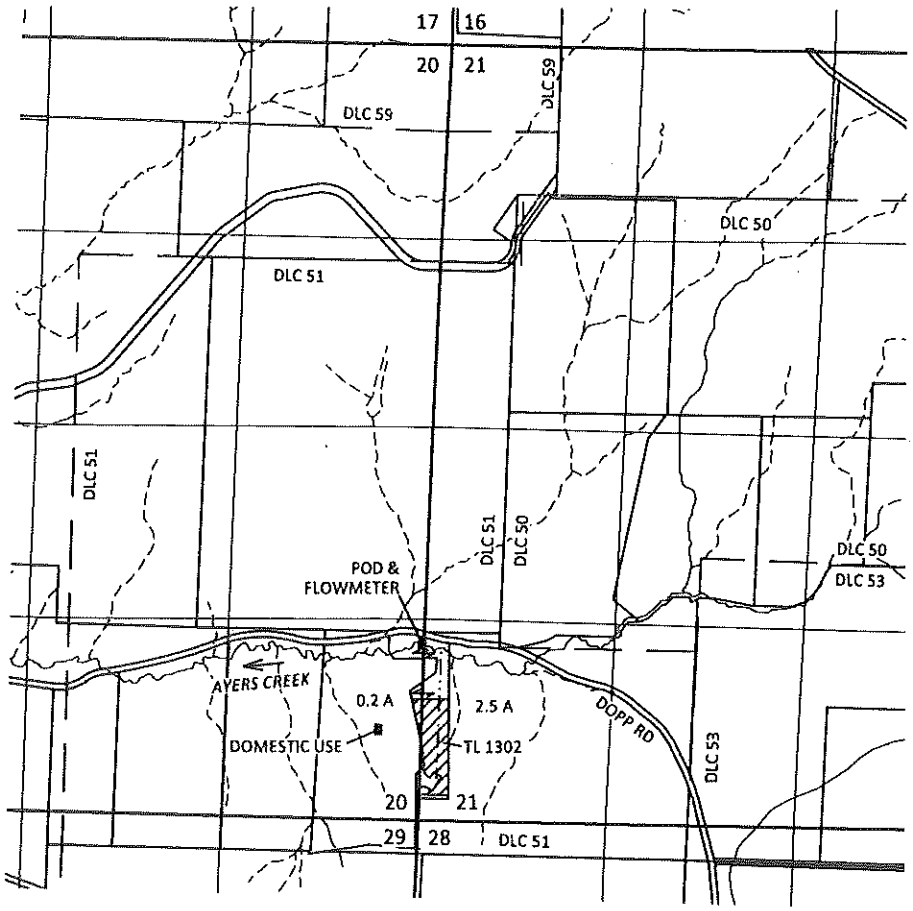

RECEIVED
SEP 13 2022
OWRD

POD: 30 FT W AND 1210 FT N FROM SW CORNER OF SECTION 21, T2S, R3W, W.M.

Site Inspection Conducted
9/1/2022

EXPLANATION

PLACE OF USE
IRRIGATION 2.7 ACRES
PRIORITY: 9/5/1972

POINT OF DIVERSION (POD)

1-1/4" PIPE

N

SCALE
660 0 660 1320
1 INCH = 1320 FEET

September 6, 2022

This map is not intended to provide legal dimensions or locations of property ownership lines

CERTIFIED WATER RIGHT EXAMINER
439
STEVEN R. BRUCE
JUNE 13, 1997
STATE OF OREGON
Expires 12/31/2023

KPFF 1700014.15

SKOOKUM
WATER ASSOCIATES INC

1626 VICTORIAN WAY
EUGENE, OR 97401
(503) 319-8926

Figure 1