


Claim of Beneficial Use - Sonnen - T-12855

Township 4S, Range 2W, W.M.

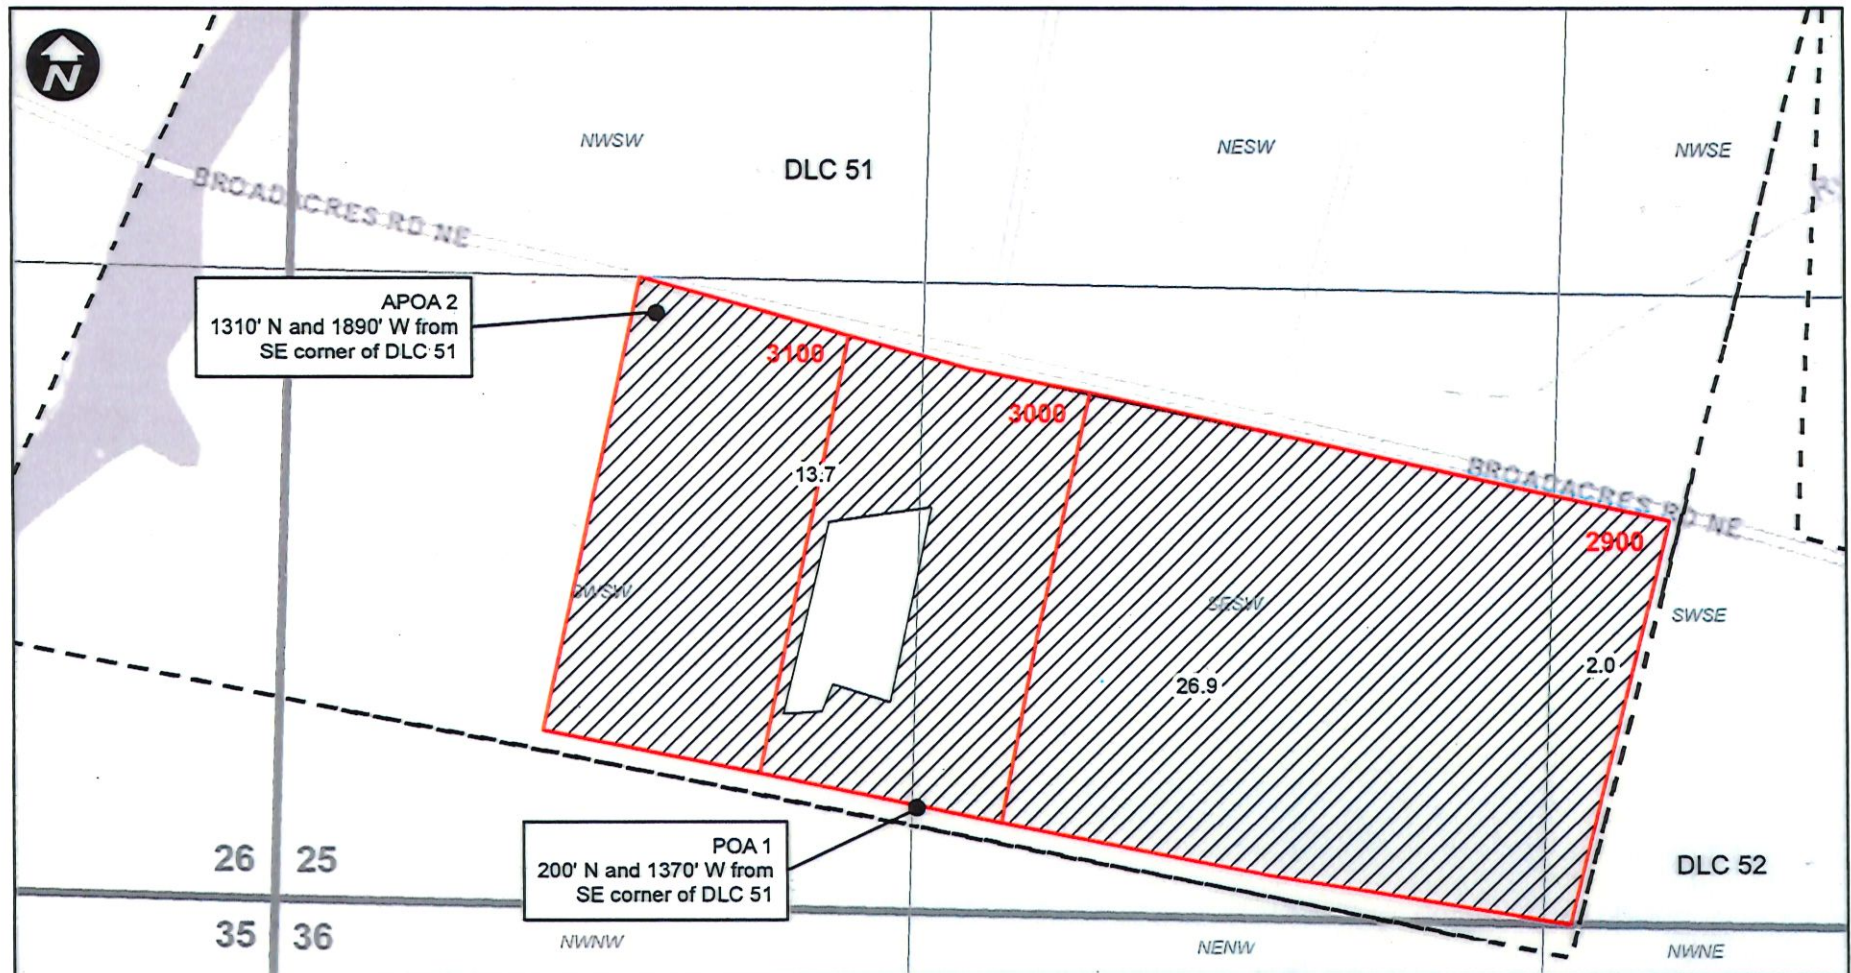

0 200 400 800 Feet

This map is not intended to provide legal dimensions or locations of property ownership lines.

Legend

Irrigation POU Taxlot DLC