


T.5S.,R.3W.,W.M.

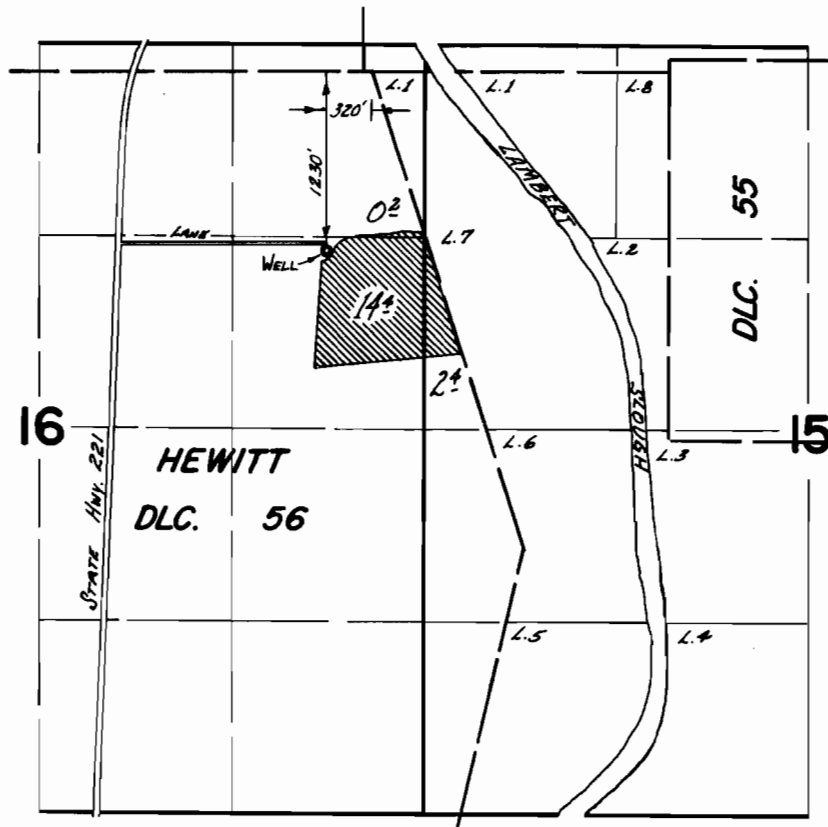

FINAL PROOF SURVEY
UNDER

Application No. G-3842 Permit No. G-3619
IN NAME OF


DONALD KUHN

Surveyed May 18 1973, by D. NORBY

Certificate 40333 - Transfer Application

Hildebrandt

Township 5S, Range 3W, W.M.

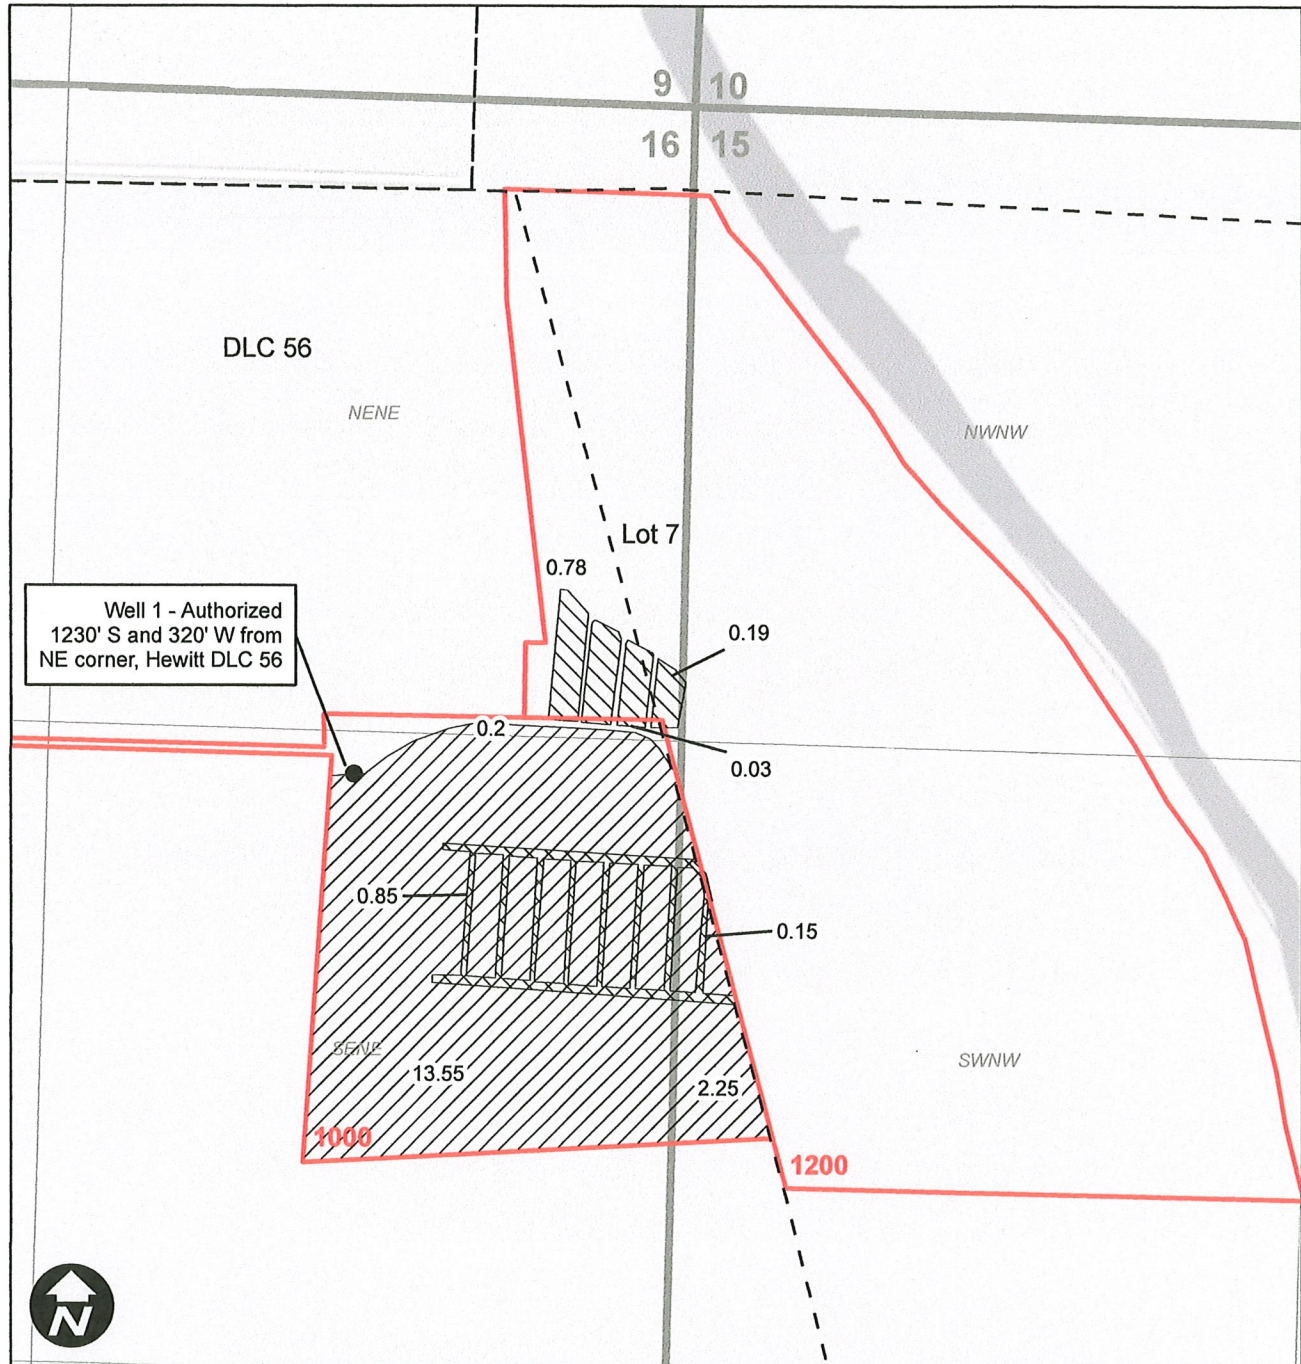

Legend

- Cert. 40333 From (1.0 ac.)
- Cert. 40333 To (1.0 ac.)
- Cert. 40333 No Change (16.0 ac.)
- Tax Lots
- DLC

0 200 400 800 Feet

Received by OWRD

DEC 13 2024

Salem, OR



EXPIRES: 12-31-2026