


T.3S. R.3W. Section 34 and T.4S. R.3W. Section 3, W.M.

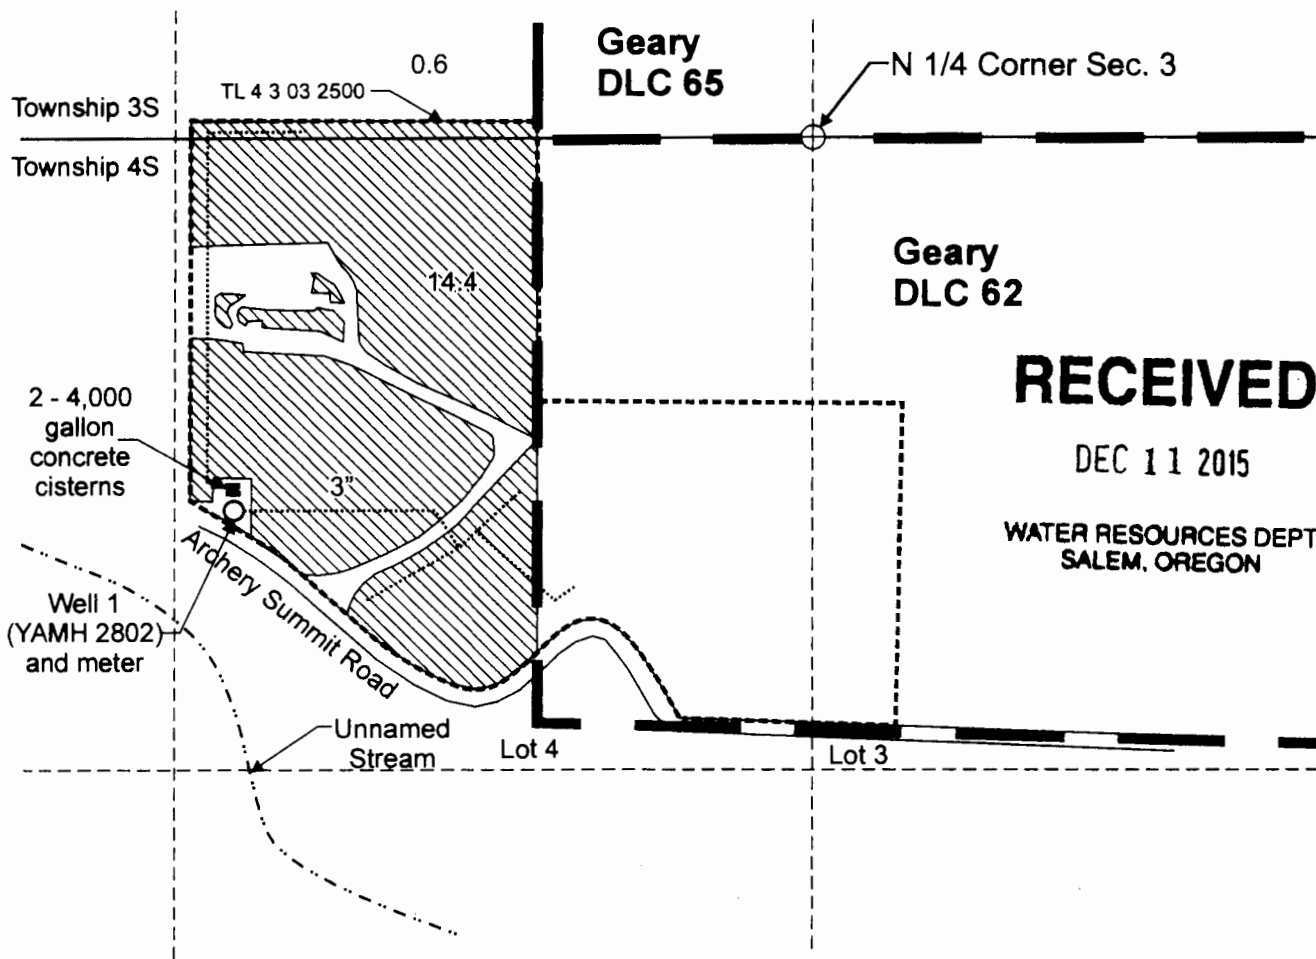

RECEIVED

DEC 11 2015

WATER RESOURCES DEPT
SALEM, OREGON


Well 1 (YAMH 2802) is located 770 feet south and 1,200 feet west from the north 1/4 corner, Section 3.

Area (15.0 acres) irrigated under Application G-13643, Permit G-11888.

Tax lot boundary


Donation Land Claim

Irrigation mainlines

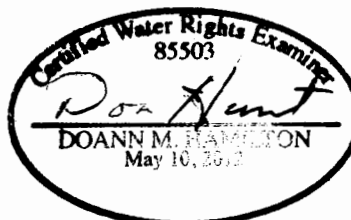

RENEWS June 30 2017

Scale: 1" = 400'

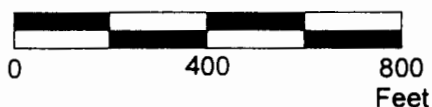

This map was prepared for the purpose of identifying the location of a water right only and is not intended to provide legal dimensions or location of property ownership lines.

Claim of Beneficial Use Map
Application G-13643, Permit G-11888


Archery Summit Winery
T.3S R.3W. Section 34 and
T.4S. R.3W. Section 3, W.M.

Pacific Hydro-Geology Inc.



12/2015

T.3S. R.3W. Section 34 and T.4S. R.3W. Section 3, W.M.

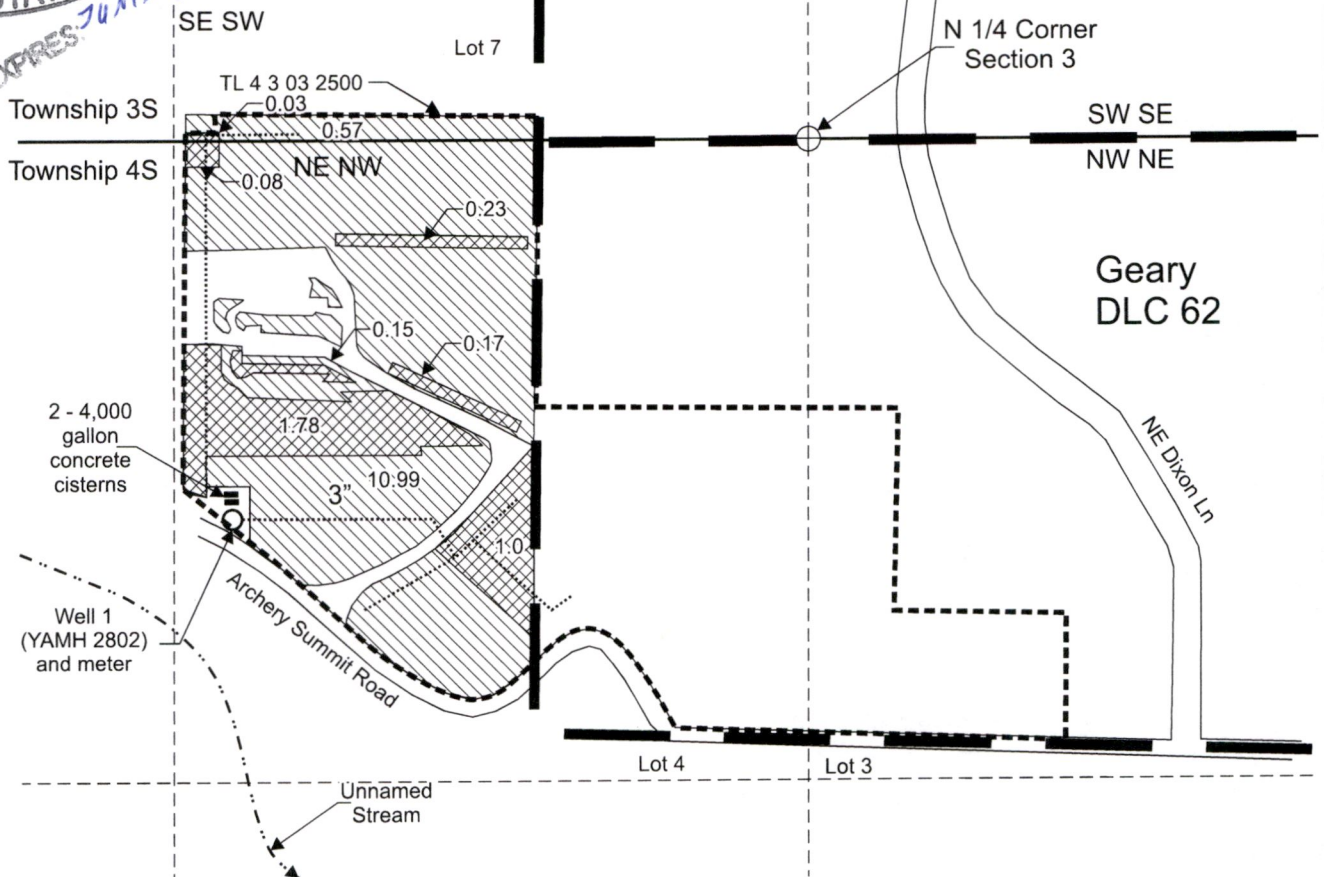Received
APR 30 2024
OWRD




Authorized Well 1 (YAMH 2802) is located 770 feet south and 1,200 feet west from the north 1/4 corner, Section 3.

-  Area (11.56 acres) irrigated under Certificate 91321, priority date March 23, 1994, not affected by this transfer
-  "From" Area (3.44 acres) irrigated under Certificate 91321, priority date March 23, 1994, affected by this transfer

----- Tax lot boundary ————— Donation Land Claim Boundary Irrigation mainlines

Scale: 1" = 400'

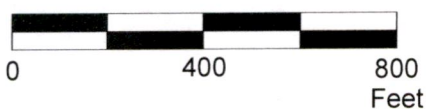

This map was prepared for the purpose of identifying the location of a water right only and is not intended to provide legal dimensions or location of property ownership lines.


Transfer Application "From" Map
Certificate 91321

Pine Ridge Associates
T.3S R.3W. Section 34 and
T.4S. R.3W. Section 3, W.M.


10/2023

Pacific Hydro-Geology Inc.

T.3S. R.3W. Section 34 and T.4S. R.3W. Section 3, W.M.

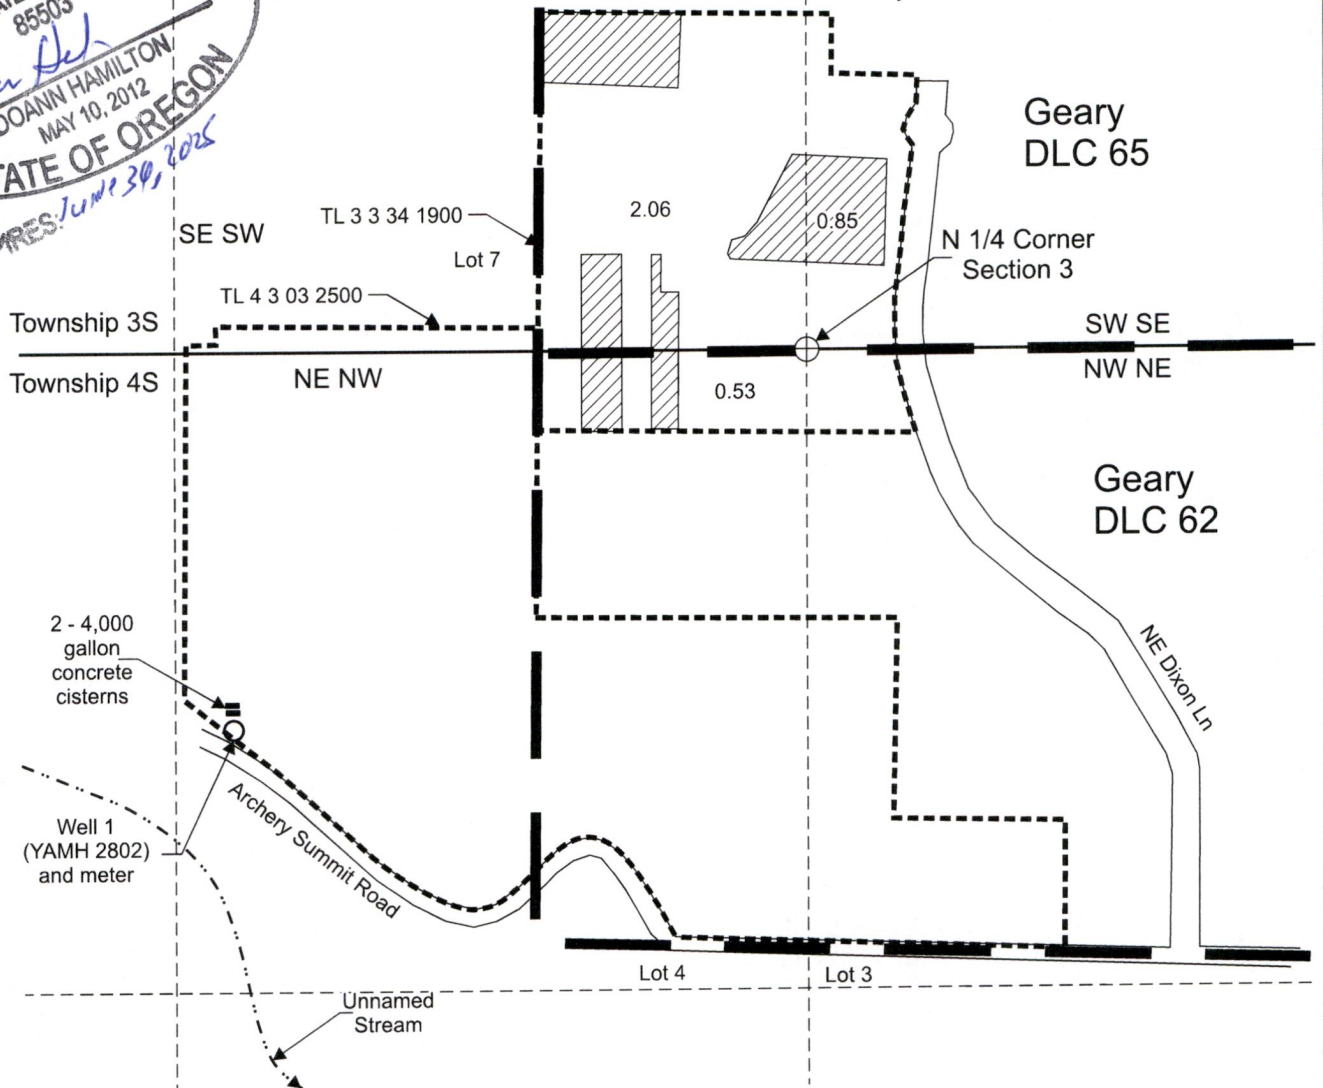

Authorized Well 1 (YAMH 2802) is located 770 feet south and 1,200 feet west from the north 1/4 corner, Section 3.

 "To" Area (3.44 acres) to be irrigated.

----- Tax lot boundary


———— Donation Land Claim Boundary

Received

APR 30 2024

OWRD

Scale: 1" = 400'

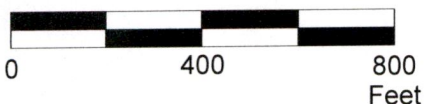

This map was prepared for the purpose of identifying the location of a water right only and is not intended to provide legal dimensions or location of property ownership lines.



Pacific Hydro-Geology Inc.

Transfer Application "To" Map
Certificate 91321

Pine Ridge Associates
T.3S R.3W. Section 34 and
T.4S. R.3W. Section 3, W.M.

10/2023