

CLAIM OF BENEFICIAL USE MAP

FOR

LLOYD & REBECCA MILES

SECTION 2, TOWNSHIP 27 SOUTH RANGE 15 EAST,
LAKE COUNTY, OREGON


TRANSFER NO.

T-8588

LEGEND

- SECTION LINE
- 1/4 SECTION LINE
- 1/16 SECTION LINE
- IRRIGATION MAIN LINE
- WHEEL LINE

NOTE:
PREPARATION OF THIS MAP IS FOR IDENTIFYING
WATER RIGHTS ONLY. IT HAS NO INTENT TO PROVIDE
LOCATIONS OR DIMENSIONS OF PROPERTY BOUNDARIES.

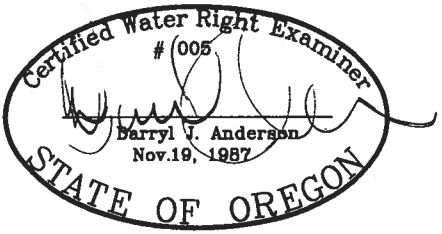

RENEWAL 12/31/19


SCALE: 1"=1320'

RECEIVED

JFC 17 2018

OWRD

WELL #4 LOCATED 2643.37' WEST &
4012.32' NORTH OF THE SOUTHEAST
CORNER OF SECTION 2

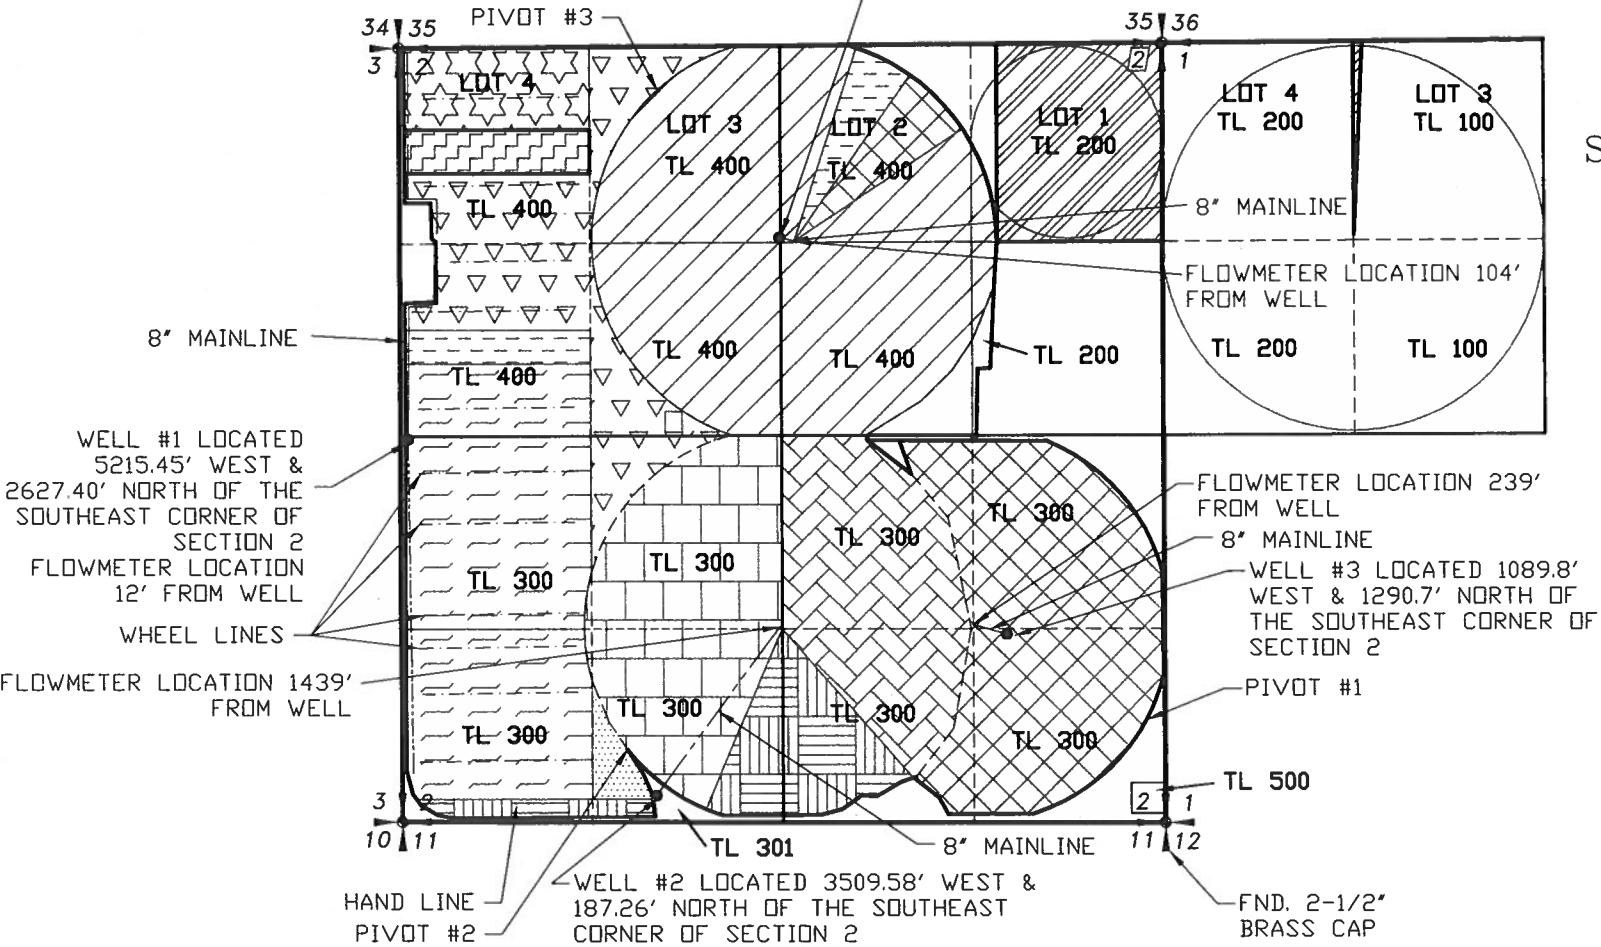

Acres Authorised and Claimed under T - 8588

Primary 561.17
Supplemental 8.9

Certificate	31236						
Township	Range	Mer	Sec	Q-Q	GLot	Well #	Acres
27 S	15 E	WM	2	NW NE	2	4	8.35
27 S	15 E	WM	2	NE SE		3	32.9
27 S	15 E	WM	2	NW SE		3	6.03
27 S	15 E	WM	2	SW SE		3	4.9
27 S	15 E	WM	2	SE SE		3	31.72
Total Acres this Certificate							83.9

Certificate	47919					
Township	Range	Mer	Sec	Q-Q	Well #	Acres
27 S	15 E	WM	2	SW NW	1	14.75
27 S	15 E	WM	2	NW SW	1	38.64
27 S	15 E	WM	2	SW SW	1	33.71
Total Acres this Certificate						87.1

Certificate	72464 Well #2					
Township	Range	Mer	Sec	Q-Q	Well #	Acres
27 S	15 E	WM	2	SW SW	2	3.46
27 S	15 E	WM	2	SE SW	2	9.05
27 S	15 E	WM	2	SW SE	2	13.68
Total Acres this Certificate						26.19

Certificate	72467					
Township	Range	Mer	Sec	Q-Q	Well #	Acres
27 S	15 E	WM	2	NE SW	2	33.41
27 S	15 E	WM	2	NW SW	2	0.31
27 S	15 E	WM	2	SW SW	2	0.28
27 S	15 E	WM	2	SE SW	2	24.45
Total Acres this Certificate						58.45

Certificate	74297						
Township	Range	Mer	Sec	Q-Q	GLot	Well #	Acres
27 S	15 E	WM	2	NE NW	3	1	8.5
27 S	15 E	WM	2	NW NW	4	1	12.68
27 S	15 E	WM	2	SW NW		1	15.32
27 S	15 E	WM	2	SE NW		1	7.79
27 S	15 E	WM	2	NE SW		1	6.61
Total Acres this Certificate							50.9

Certificate	41096						
Township	Range	Mer	Sec	Q-Q	GLot	Well #	Acres
27 S	15 E	WM	2	NE NE	1	4	1.81
27 S	15 E	WM	2	NW NE	2	4	21.15
27 S	15 E	WM	2	SW NE		4	35.63
27 S	15 E	WM	2	SE NE		4	1.77
27 S	15 E	WM	2	NE NW	3	4	32.45
27 S	15 E	WM	2	SE NW		4	31.69
Total Acres this Certificate							124.5

Certificate	72465 						
Township	Range	Mer	Sec	Q-Q	GLot	Well #	Acres
27 S	15 E	WM	2	NW NW	4	1	16.8

Certificate	72468					
Township	Range	Mer	Sec	Q-Q	Well #	Acres
27 S	15 E	WM	2	NW NE	4	6.66
27 S	15 E	WM	2	SW NW	1	6.88
Total Acres this Certificate						13.54

Certificate	76090 Place of use change only						
Township	Range	Mer	Sec	Q-Q	GLot	Well #	Acres
27 S	15 E	WM	1	NE NW		4	0.78
27 S	15 E	WM	2	NE NE	1	4	36.1
Total Acres this Certificate							36.88

Certificate	72463					
Township	Range	Mer	Sec	Q-Q	Well #	Acres
27 S	15 E	WM	2	NW SE	2	32.9
27 S	15 E	WM	2	SW SE	2	17.3
Total Acres this Certificate						50.2

Certificate	74297 & 72465							
Township	Range	Mer	Sec	Q-Q	GLot	Well #	Primary Acres	Supplemental Acres
27 S	15 E	WM	2	NW NW	4	1	8.9	8.9
Total Acres this Certificate							8.9	8.9

Certificate	72464 Well #1						
Township	Range	Mer	Sec	Q-Q	GLot	Well #	Acres
27 S	15 E	WM	2	SE SW		#1	3.81
Total Acres this Certificate							3.81

REVISION	BY
2-6-2018	DA
4-17-2018	RC
12-12-2018	JEH

ANDERSON ENGINEERING
AND SURVEYING, INC.
P.O. BOX 28
LAKEVIEW, OREGON
97630
(541) 947-4407
FAX: 947-2321


FOR:
LLOYD MILES
81341 BUICK LANE
SILVER LAKE, OR
97638

CLAIM OF BENEFICIAL USE
TRANSFER NO. T-8588

DATE:	01-20-09
SCALE:	1"=1320'
DWG. BY:	R.C.
JOB:	2008-003
FILE:	2008-003
SHEET:	1 OF 1

1159

T.27 S.R.15 E.W.M.

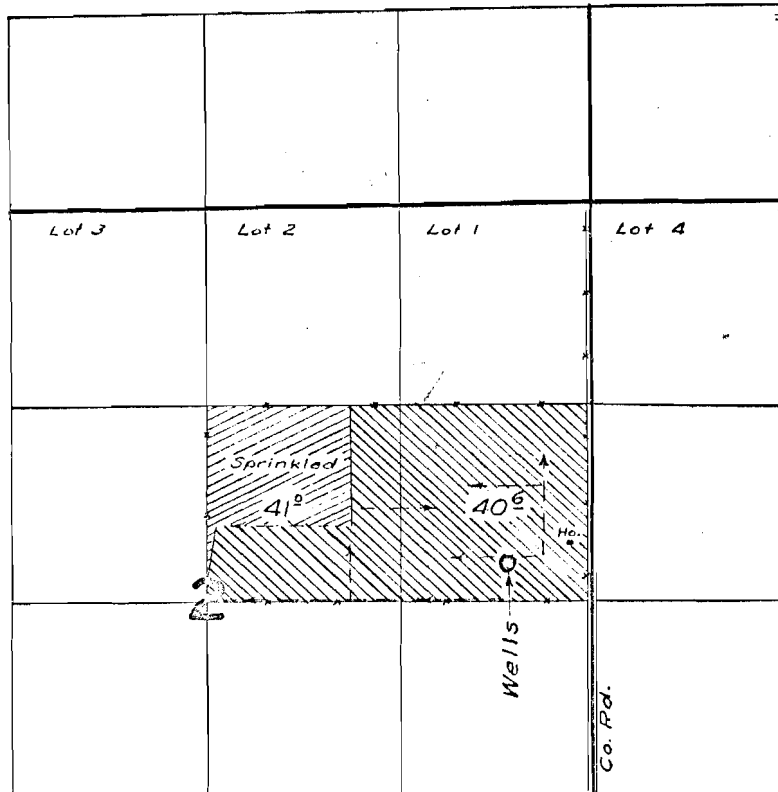


FINAL PROOF SURVEY
UNDER

Application No. U-426 Permit No. U-394
IN NAME OF


OWEN PITCHER

Surveyed 8 May 1959, by M. B. Sch

REVISED: 01/31/2025

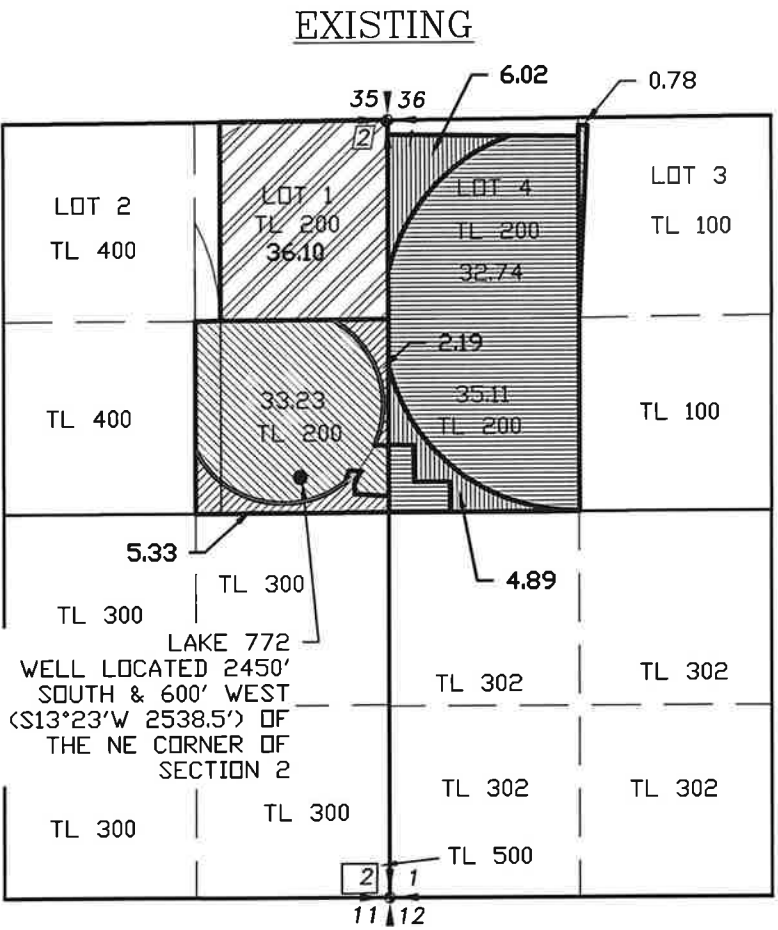

- PLACE OF USE CERTIFICATE 94366
TO MOVE - 36.10 ACRES
- PLACE OF USE CERTIFICATE 94366
TO REMAIN - 0.78 ACRES
- PLACE OF USE CERTIFICATE 83463
TO REMAIN - 33.23 ACRES
- PLACE OF USE CERTIFICATE 83463
TO MOVE - 6.77 ACRES
- PLACE OF USE CERTIFICATE 76091
TO REMAIN - 67.85 ACRES
- PLACE OF USE CERTIFICATE 76091
TO MOVE - 10.91 ACRES

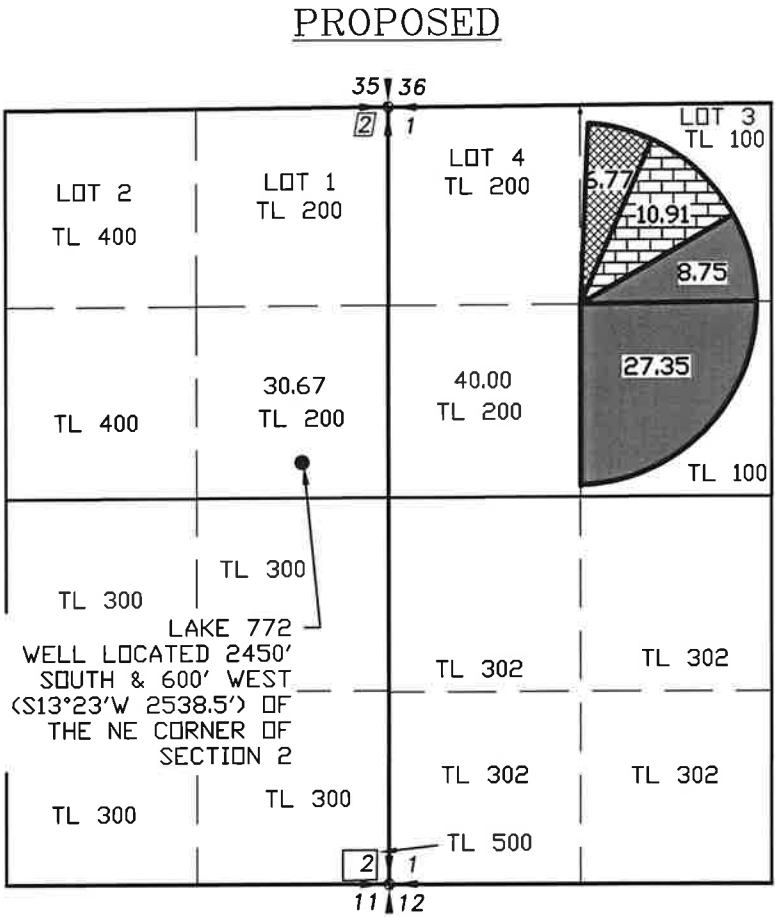

- PROPOSED PLACE OF USE FROM
CERTIFICATE 94366 - 36.10 ACRES
- PROPOSED PLACE OF USE FROM
CERTIFICATE 83463 - 6.77 ACRES
- PROPOSED PLACE OF USE FROM
CERTIFICATE 76091 - 10.91 ACRES

MAP TO ACCOMPANY WATER RIGHT TRANSFER APPLICATION FOR GENE PORTER

SECTIONS 1 & 2, TOWNSHIP 17 SOUTH,
RANGE 15 EAST, W.M.
LAKE COUNTY, OREGON



- LEGEND
- SECTION LINE
 - 1/4 SECTION LINE
 - 1/16 SECTION LINE
 - TAXLOT LINE

TRANSFER NO.
T-13934

NOTE:
PREPARATION OF THIS MAP IS FOR IDENTIFYING PROPOSED
WATER RIGHTS ONLY. IT HAS NO INTENT TO PROVIDE
LOCATIONS OR DIMENSIONS OF PROPERTY BOUNDARIES.

REVISION	BY
02/23/2023	RC
01/31/2025	RC

ANDERSON ENGINEERING
AND SURVEYING, INC.

P.O. BOX 28
LAKEVIEW, OREGON 97630
(541) 947-4407/FAX: 947-2321
WWW.ANDERSONENGINEERING.COM

FOR:
GENE PORTER
57703 FORT ROCK RD
SILVER LAKE, OR
97638

MAP TO ACCOMPANY WATER
RIGHT TRANSFER APPLICATION
SEC.1 & 2, T27S, R15E W.M.

DATE:	2/14/2022
SCALE:	1" = 1320'
DWG. BY:	R.C.
JOB:	2022-019
FILE:	2022-019
SHEET:	1 of 1