


T.31S., R.15W., W.M.

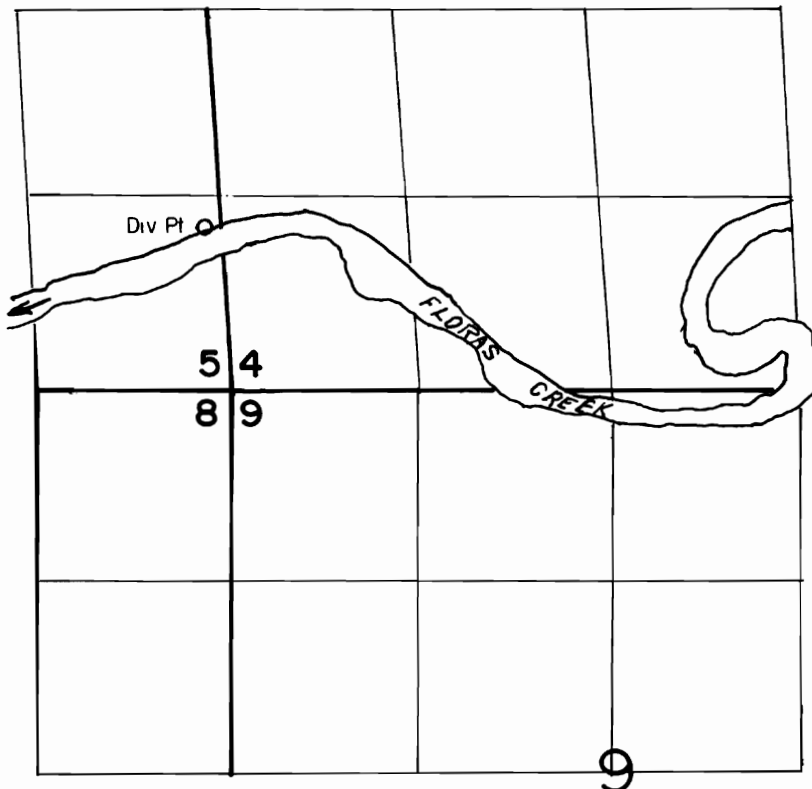

Div Pt Located 1100' N & 160' W From The SW Corner Of Section 4

SCALE: 1" = 132.0'

# FINAL PROOF SURVEY UNDER


TRANSFER NO. 3634

Application No. .... Permit No. ....  
IN NAME OF

..... **RODERICK A. MCKENZIE** .....

Surveyed AUG. 2... 1989., by B.S. JAMES.....

T.31S.R.15W.W.M.

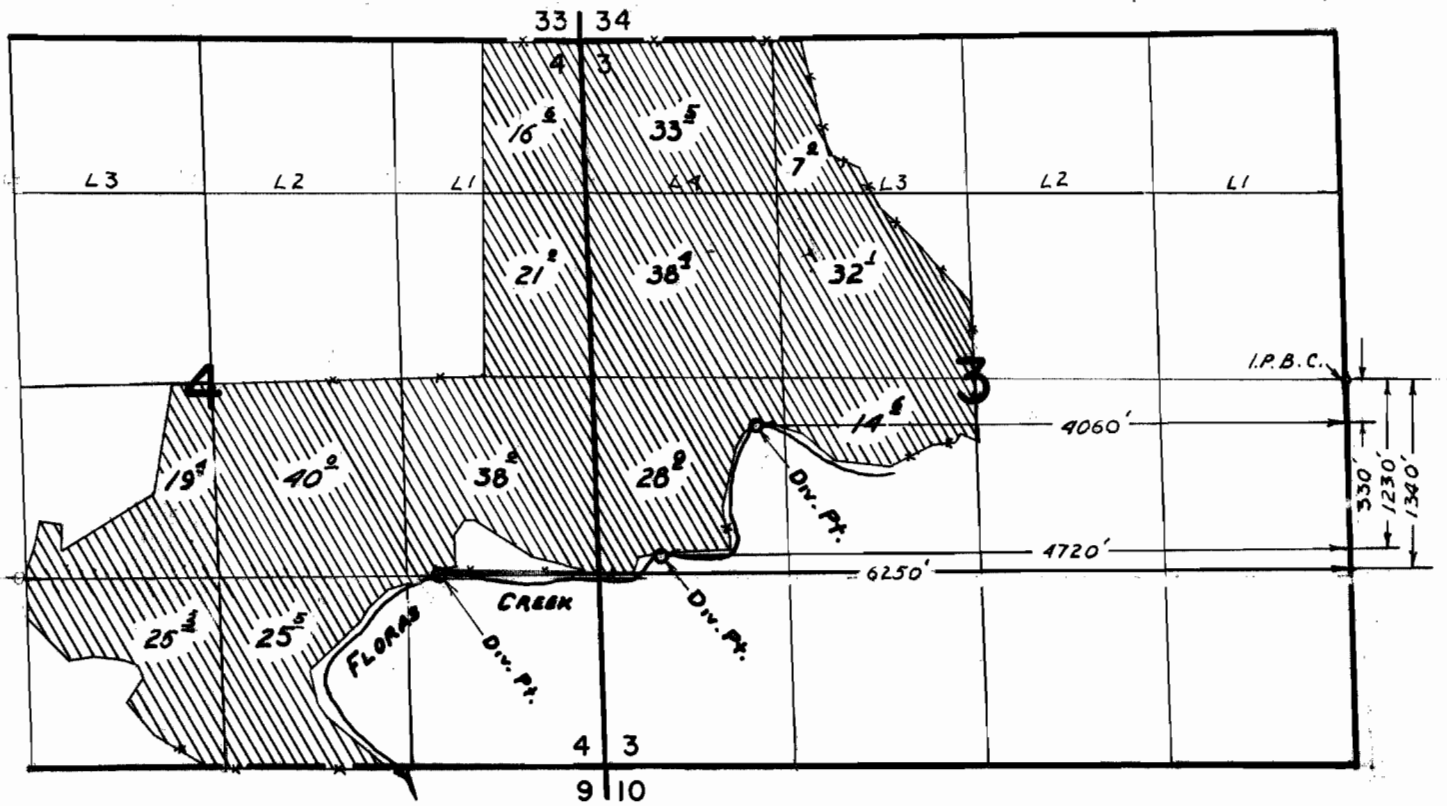

**FINAL PROOF SURVEY**  
UNDER

Application No. 39763. Permit No. 29772.  
IN NAME OF

**RODERICK T. McKENZIE**

Surveyed May 17, 1969, by L. E. Gould