



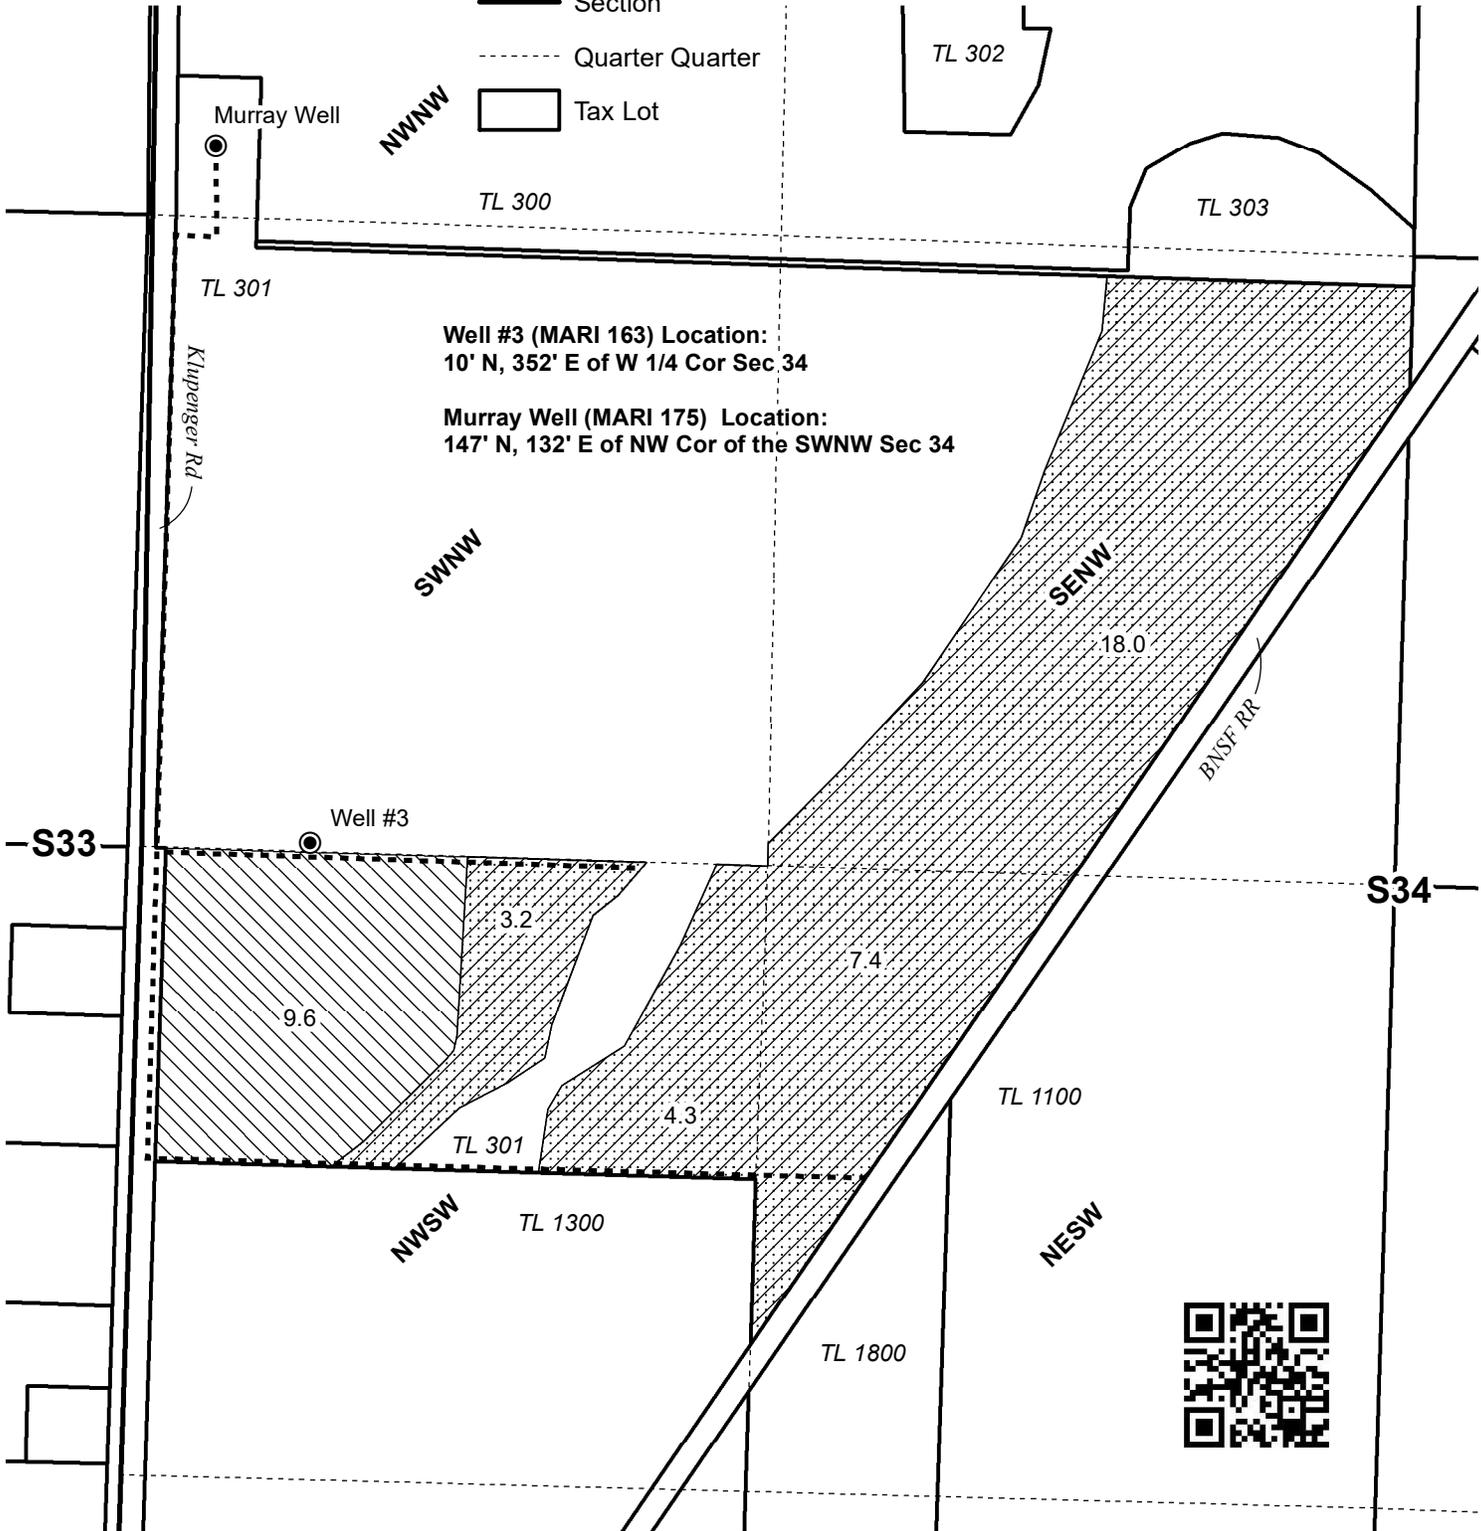

RENEWS: 06/30/2026

- Well & Meter
- Pipeline
-  POU IR 11/24/1987 Priority - Well #3
-  POU (IS) 3/30/1987 Priority - Murray Well
-  POU IR 8/24/1977 Priority - Well #3
- Section
- Quarter Quarter
-  Tax Lot

T3S R1W, WM, MARION COUNTY, OR

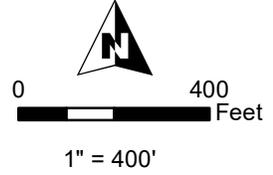

Well #3 (MARI 163) Location:
10' N, 352' E of W 1/4 Cor Sec 34

Murray Well (MARI 175) Location:
147' N, 132' E of NW Cor of the SWNW Sec 34



CLAIM OF BENEFICIAL USE MAP
RAMSAC Land, LLC
Date: 4/3/2025 T-11505 Project #23078

This map is not intended to provide legal dimensions or locations of property ownership lines.

WATER RIGHT SERVICES, LLC
PO BOX 1830, BEND, OR 97709
WWW.OREGONWATER.US CCB # 197121
johnshort@usa.com 541-389-2837