



RENEWAL DATE 12/31/2023

- POD & Fish Screen
- ⊙ Meter
- Pipeline
- POU Domestic Use
- ▨ POU IR
- Township
- Section
- Quarter Quarter
- Tax Lot

T26S R4W, WM
DOUGLAS COUNTY, OR

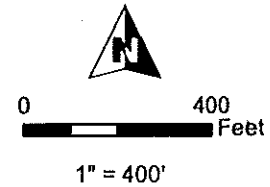

POD Location:
750' N, 690' E
of W 1/4 Cor Sec 19

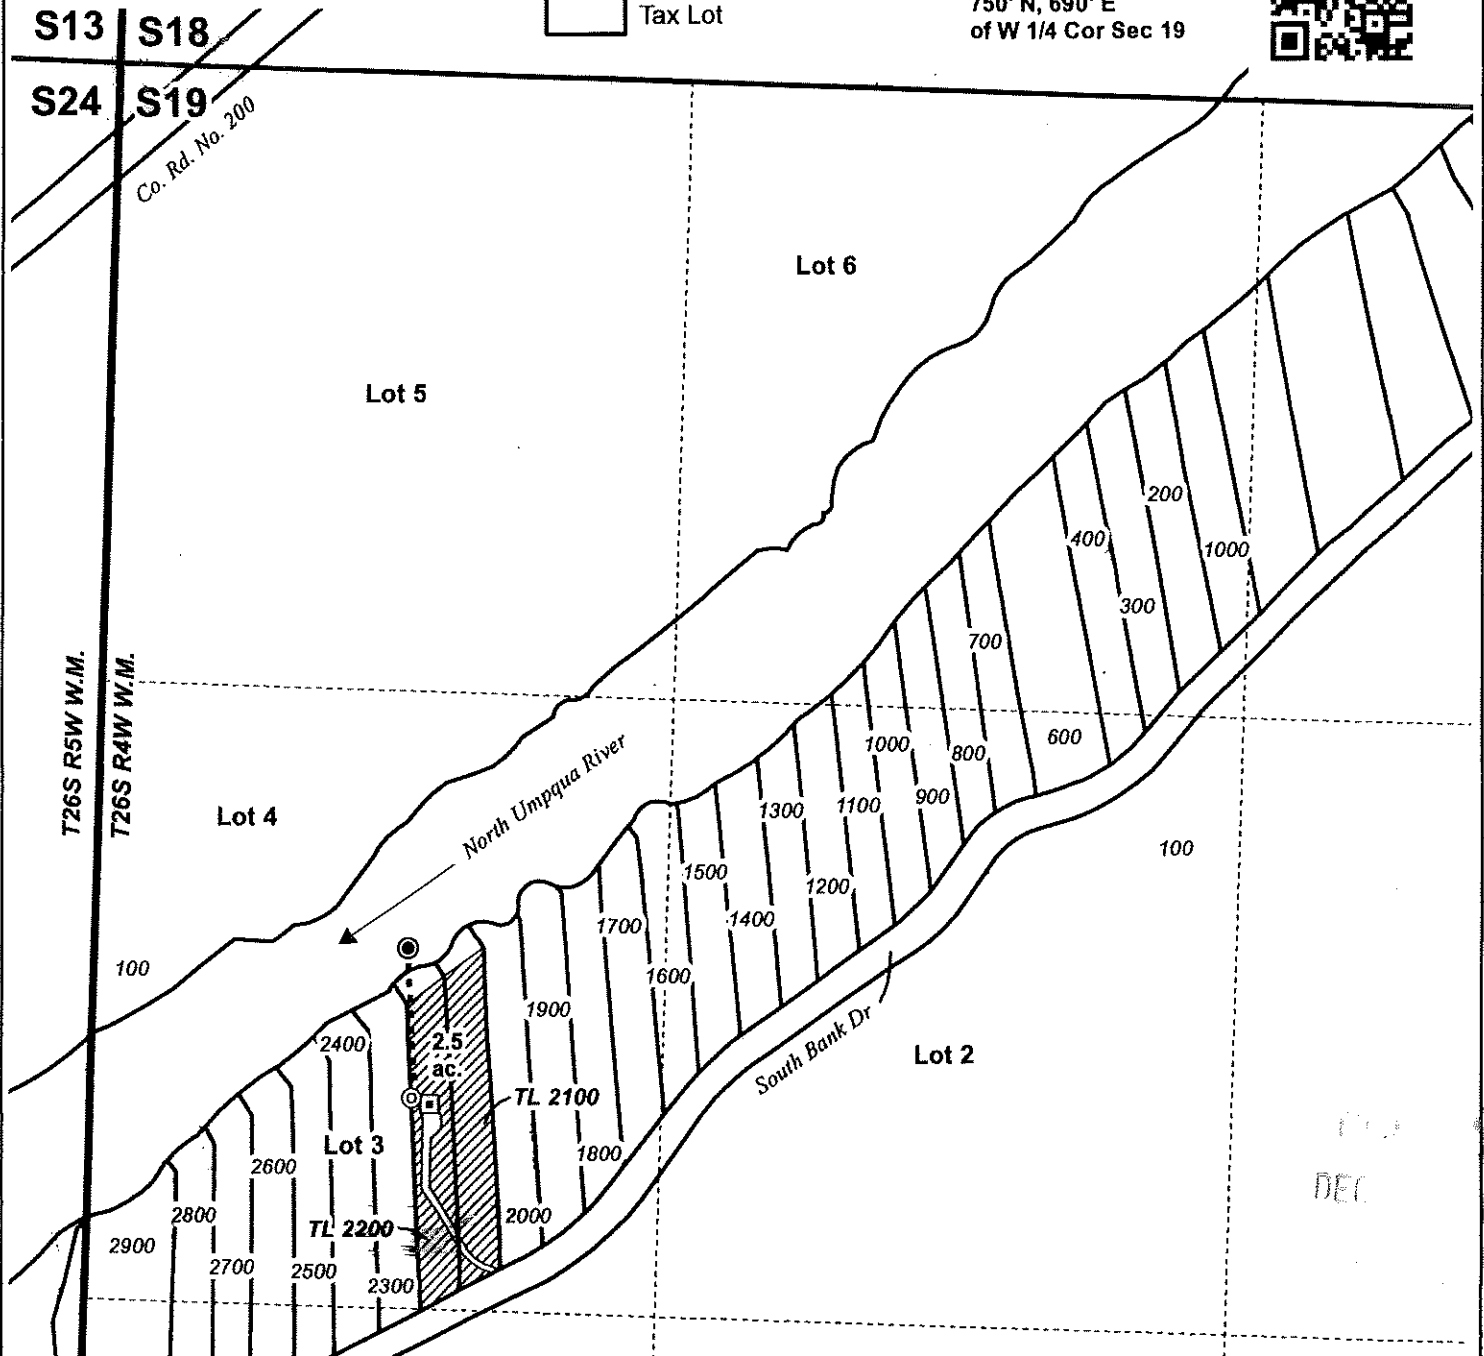

CLAIM OF BENEFICIAL USE MAP

Lou Paris

Project #22047

Date: 9/22/2022

T-13516 3/21/1973 Priority

This map is not intended
to provide legal dimensions
or locations of property
ownership lines.

WATER RIGHT SERVICES, LLC

P.O. BOX 1830, BEND, OR 97709

WWW.OREGONWATER.US CCB # 197121

johnshort@usa.com

541-389-2837