


T 4 S, R 2 W, WM

MARION COUNTY

Etienne Pettier
DLC No. 92

RECEIVED
FEB 26 2009
WATER RESOURCES DEPT
SALEM, OREGON

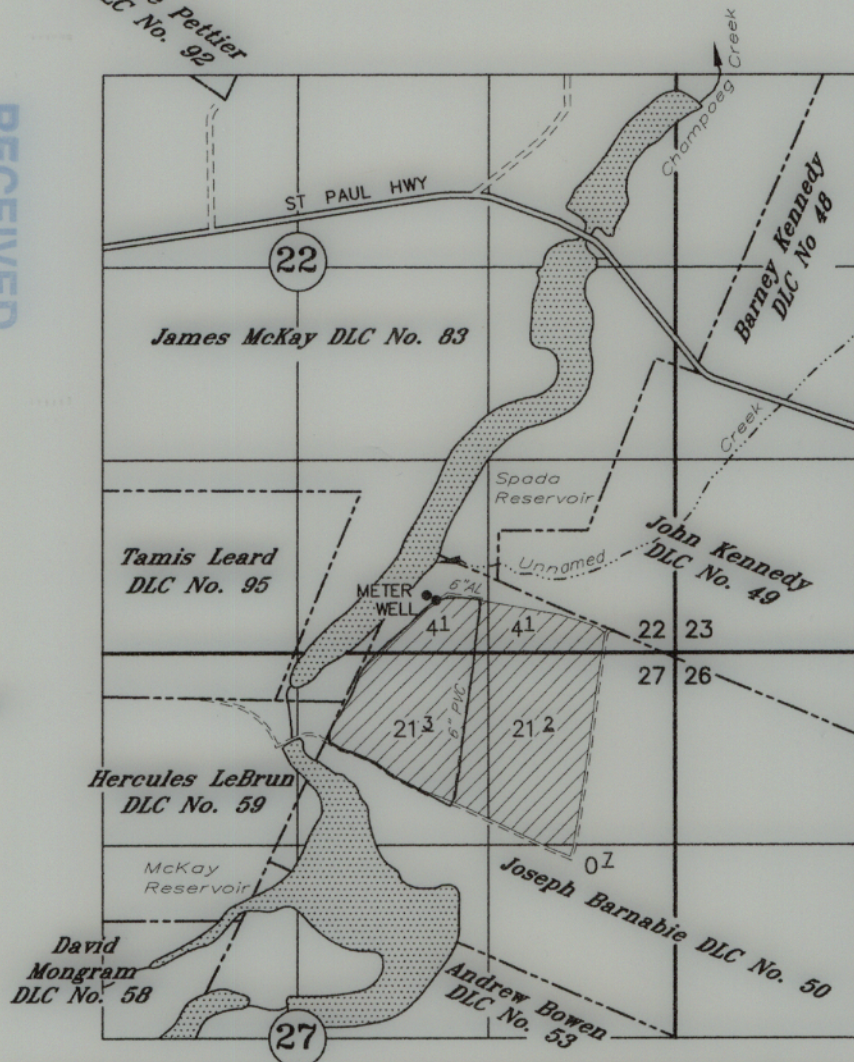

TAX LOT:
4 2W 27 100

WELL: 692' N AND 632' E OF THE NE CORNER HERCULES LeBRUN DLC 59

FINAL PROOF SURVEY

UNDER

 SUPPLEMENTAL

Application No.	S-25725	S-20143	21293	Certificate No. _____	Transfer No. T-8858
	S-45739	S-34601	39689		
	G-14965	G-13817			

IN THE NAME OF


Kevin Crosby

JUNE 22, 2006

MARCH 28, 2008

SCALE: 1" = 1320'

NOTE: This map is not intended to provide legal dimensions or locations of property ownership lines.

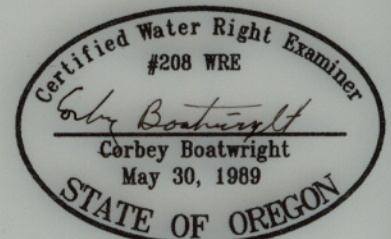

EXPIRES 12-31-09