


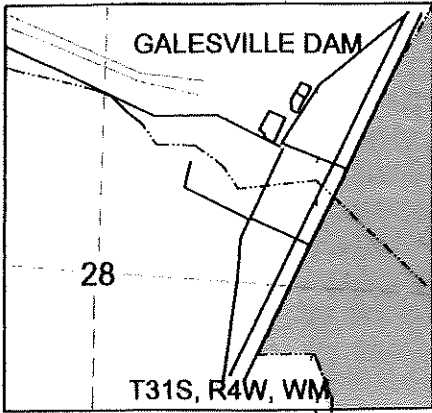

CLAIM of BENEFICIAL USE MAP

FOR: THOMAS (JUSTIN) & KIMBERLY LINDBLOOM

BY: NATHAN REED, PE, CWRE

T27S, R6W, W.M. SECTION 6

APPLICATION NO. S-88728


PERMIT NO. S-55247

DATE OF SURVEY: MAY 20, 2023



SCALE: 1" = 1320'

SCALE: 1" = 400'

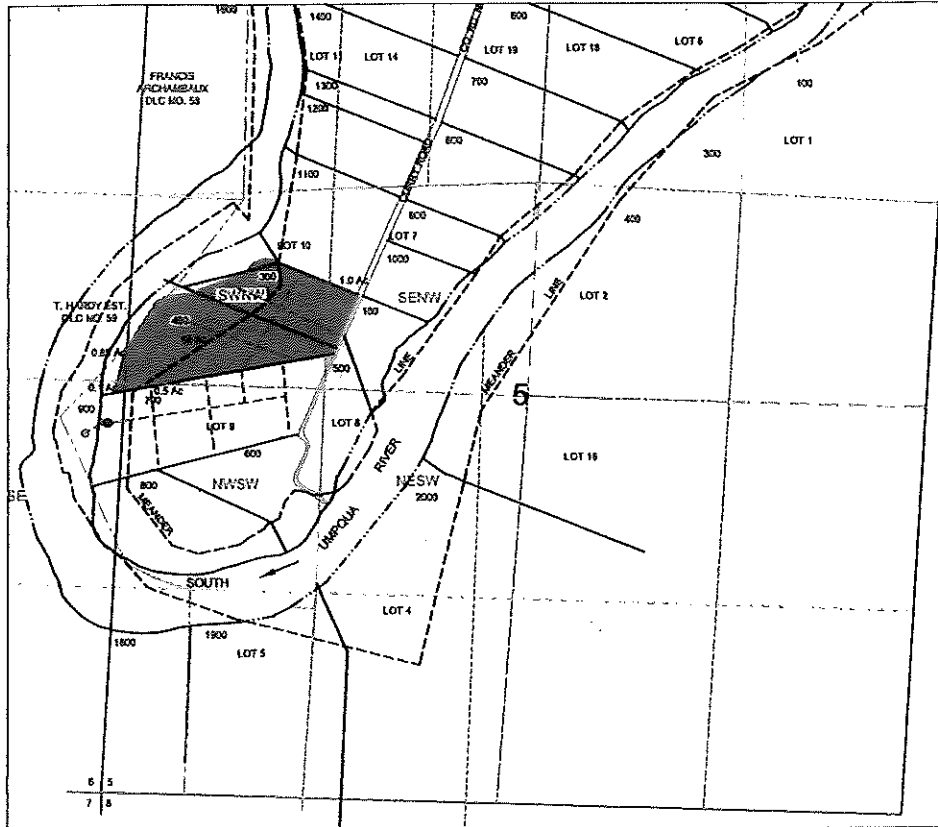


RECEIVED
JUN 15 2023
QWRD

POD IS LOCATED 2230 FEET NORTH & 270 FEET WEST OF SE CORNER OF SECTION 6.

MAP PREPARED FOR:
JUSTIN & KIMBERLY LINDBLOOM
314 BURKHART RAPIDS RD
ROSEBURG, OR 97471

LEGEND

- | | | | |
|---------|-------|-----|------------|
| ---○--- | WATER | --- | QUARTER |
| ---▲--- | POD | --- | SIXTEENTH |
| ---M--- | PUMP | --- | GLOT |
| --- | METER | --- | PARCEL |
| --- | PIPE | --- | IRRIGATION |

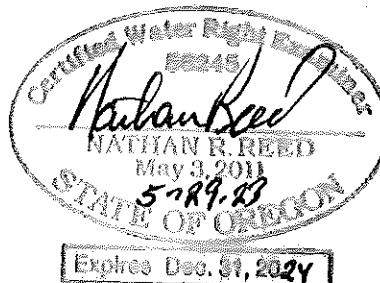

THE PURPOSE OF THIS MAP IS TO IDENTIFY THE LOCATION OF THE WATER RIGHT. IT IS NOT INTENDED TO PROVIDE INFORMATION RELATIVE TO THE LOCATION OF PROPERTY OWNERSHIP BOUNDARY LINES.

MAP PREPARED BY:
NATHAN REED PE, CWRE
157 WEST BODIE STREET
ROSEBURG, OR 97471