
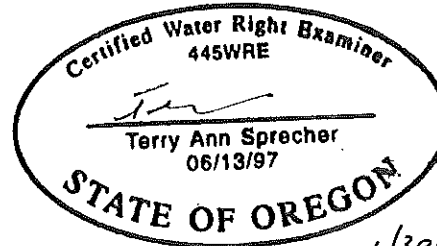


CLAIM OF BENEFICIAL USE MAP

TAX LOT 700

Located in SW-NW OF
Section 22, T.6N., R.35E., W.M.
UMATILLA COUNTY, OREGON

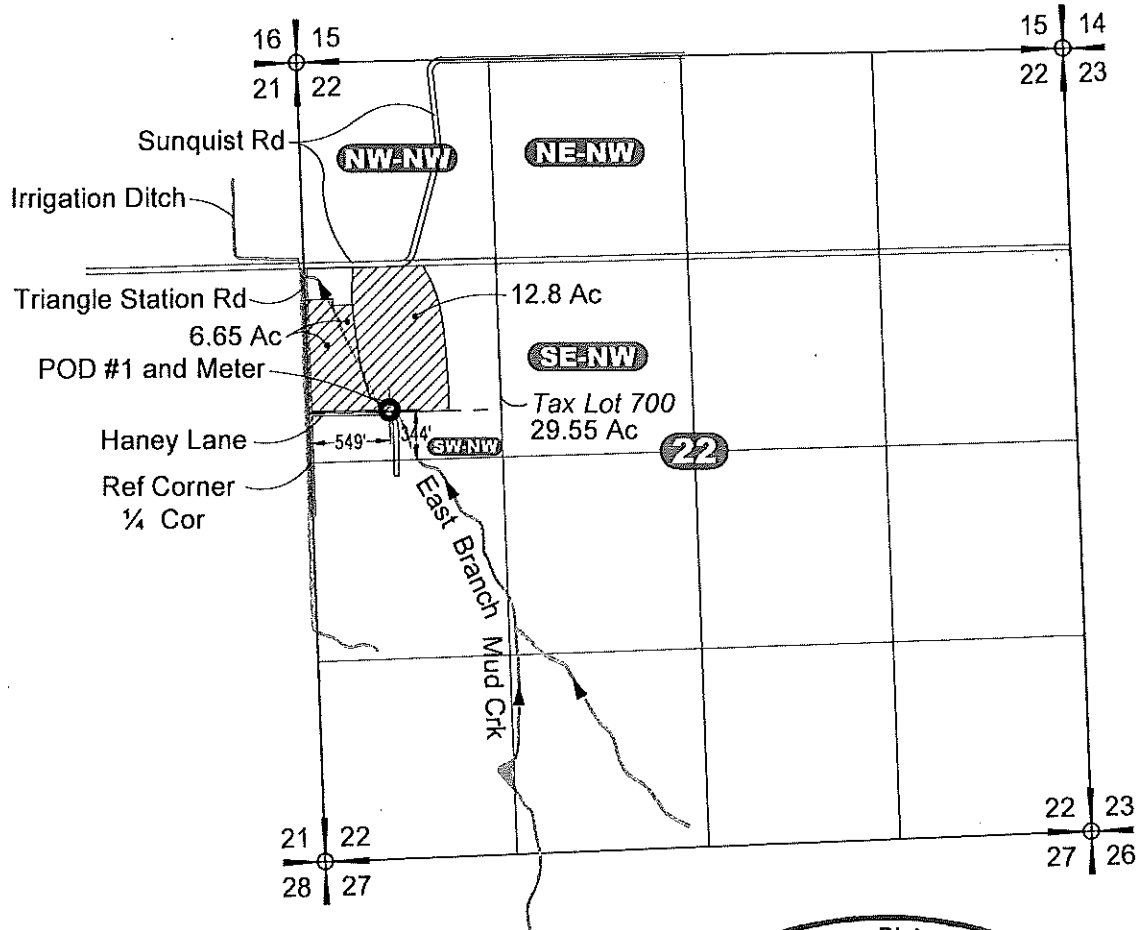

Expires 6/30/2024


RECEIVED
NOV 06 2023
OWRD

LEGEND

AUTHORIZED PLACE OF USE
X.XX Ac

NOTE

THIS MAP WAS PREPARED FOR THE PURPOSE OF IDENTIFYING THE LOCATION OF WATER RIGHTS ONLY AND IS NOT INTENDED TO PROVIDE LEGAL DIMENSIONS OR LOCATIONS OF PROPERTY OWNERSHIP LINES.

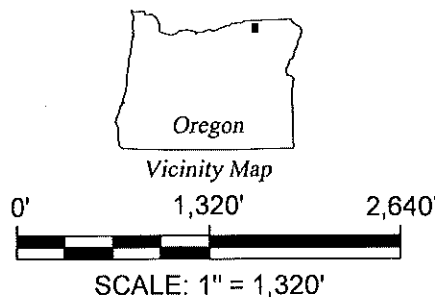


REFERENCE NOTES

Map features supplied by Umatilla County Tax Map 6N 35 22B, dated 03/09/17.

Claim of Beneficial Use Map for T-13526
Tax Lot 700, Tax Map: 6N 35 22B
Milton-Freewater, Oregon, 97862

CREATED BY: TAS
DRAWN BY: SJS

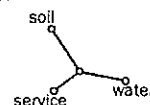

Sprecher
group

2445 NE Division St., Suite 300
Bend, Oregon 97703

SG PROJECT 4339
AUGUST 2023