

MILL SITE INDUSTRIAL, LLC
CLAIM OF BENEFICIAL USE
EXHIBIT MAP
JUNE 23, 2023

TAX MAP 110904


located in

SECTION 4, TOWNSHIP 11 SOUTH,
RANGE 9 WEST, WILLAMETTE MERIDIAN
LINCOLN COUNTY, OREGON

TRANSFER APPLICATION T-13533

THIS MAP IS NOT INTENDED TO PROVIDE
LEGAL DIMENSIONS OR LOCATION OF
PROPERTY OWNERSHIP LINES

POSITION OF POD, WATERLINE, WATER
METER, POND PERIMETER RELATIVE TO SE
CORNER OF SECTION 4 ARE BASED ON A
GPS SURVEY. POSITION OF POU BASED ON
TRANSFER APPLICATION T-13533, SECTION
AND TAX LOT LINES PER COUNTY GIS.

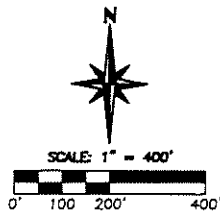

LEGEND

- WATERWAYS
- SECTION LINE
- QTR-SECTION LINE
- TAX LOT LINES
- W & P RAILROAD
- POND (CERTIFICATE 94972)
- AREA OF BENEFICIAL USE
- POINT OF DIVERSION

MAP BASE: COUNTY GIS & TAX ASSESSOR MAP


JDMcGee, Inc.

Engineering & Surveying
Land Use Planning
Wastewater Design
"Solving Problems for You"

1215 Main Street
PO Box 1472
Prineville, OR 97370
C410 925-4226
C410 925-4227 Fax

DRAWN BY: BHI
JDM PROJECT #: 21-40

CHECKED BY: JDM
DATE: 1-6-2023

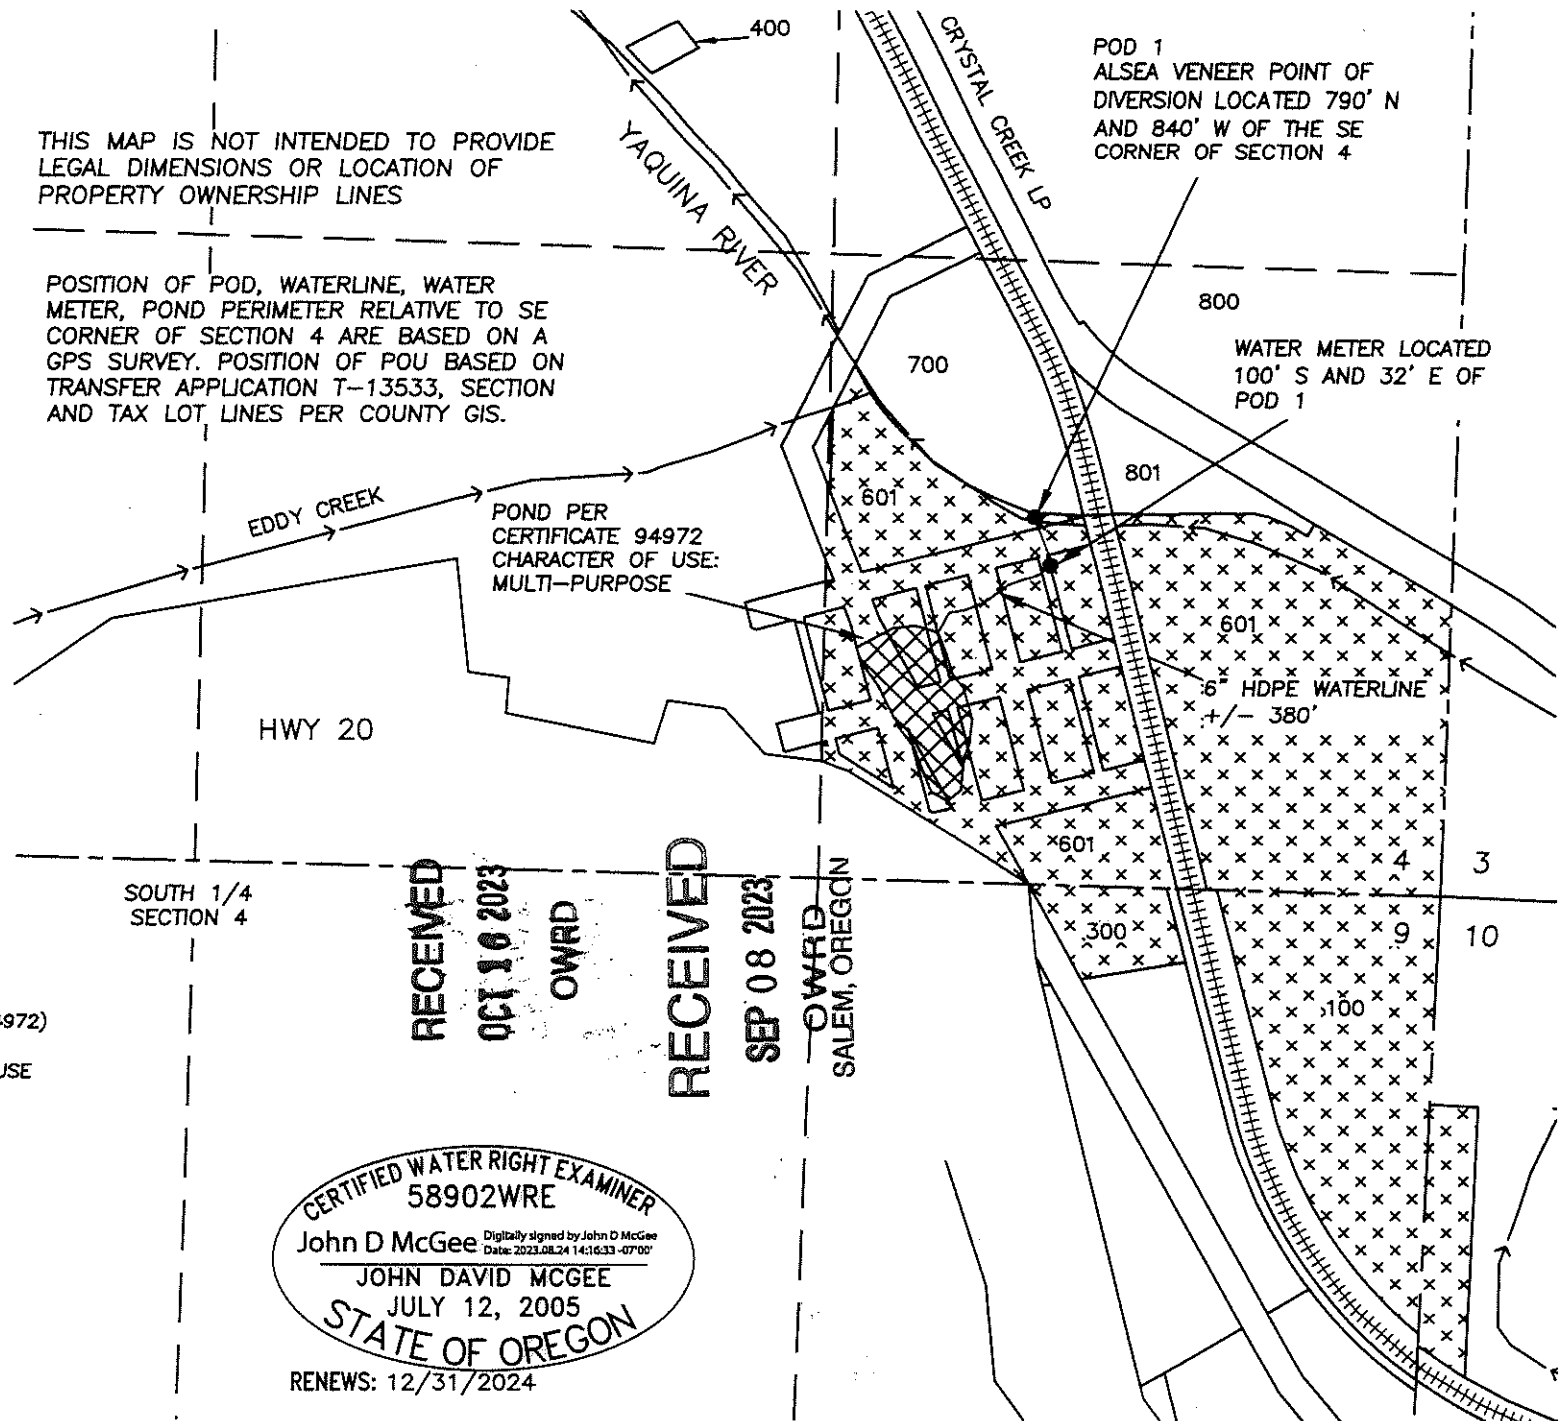

RECEIVED
OCT 10 2023
OWRD

RECEIVED
SEP 08 2023
OWRD
SALEM, OREGON