

# CLAIM OF BENEFICIAL USE MAP


TO CHANGE POINTS OF APPROPRIATION &  
PLACE OF USE FOR TRANSFER, T-12704  
SCOTT & JOSE TOBIASSON

TOWNSHIP 25 SOUTH, RANGE 14 EAST, SECTION 21, W.M.  
TAX LOT: 1300

RECEIVED

NOV 08 2022

(WARD)

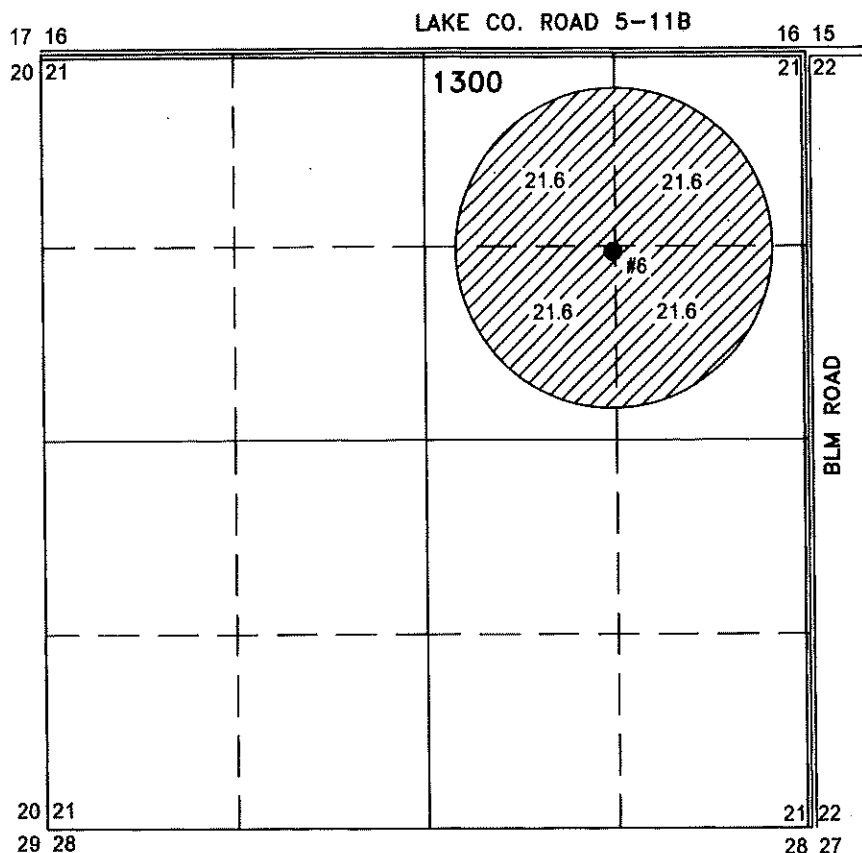


86.4 ACRES IR AUTHORIZED BY  
U-655 FROM POA #6 BY T-12704.

● #6 (LAKE 126)

LOCATED IN THE NE 1/4 NE 1/4 SECTION 21, T25S R14E, W.M.  
AND 1320 FEET SOUTH AND 1320 FEET WEST FROM THE NE  
CORNER OF SECTION 21.

FLOW METER IS ON PIPE 16' EAST FROM WELL.

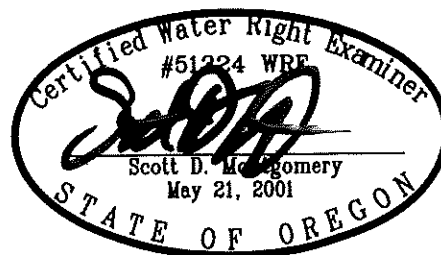

RENEWAL DATE: 12/31/2022

THIS MAP IS FOR THE PURPOSE OF LOCATING A WATER  
RIGHT ONLY AND HAS NO INTENT TO PROVIDE LEGAL  
DIMENSIONS OR THE LOCATION OF PROPERTY LINES.

PREPARED FOR:

SCOTT & JOSE TOBIASSON  
P.O. BOX 93  
FT. ROCK, OR 97735

PREPARED BY:



ALL POINTS ENGINEERING AND SURVEYING, INC.  
P.O. BOX 767 TERREBONNE, OR 97760  
(541) 548-5833 [www.APEandS.com](http://www.APEandS.com)