


CLAIM OF BENEFICIAL USE MAP

TO CHANGE POINTS OF APPROPRIATION &
PLACE OF USE FOR TRANSFER, T-12704
SCOTT & JOSE TOBIASSON


TOWNSHIP 26 SOUTH, RANGE 15 EAST, SECTION 5, W.M.
TAX LOTS: 800 & 900

RECEIVED
NOV 08 2021
CLERK
(OVER)

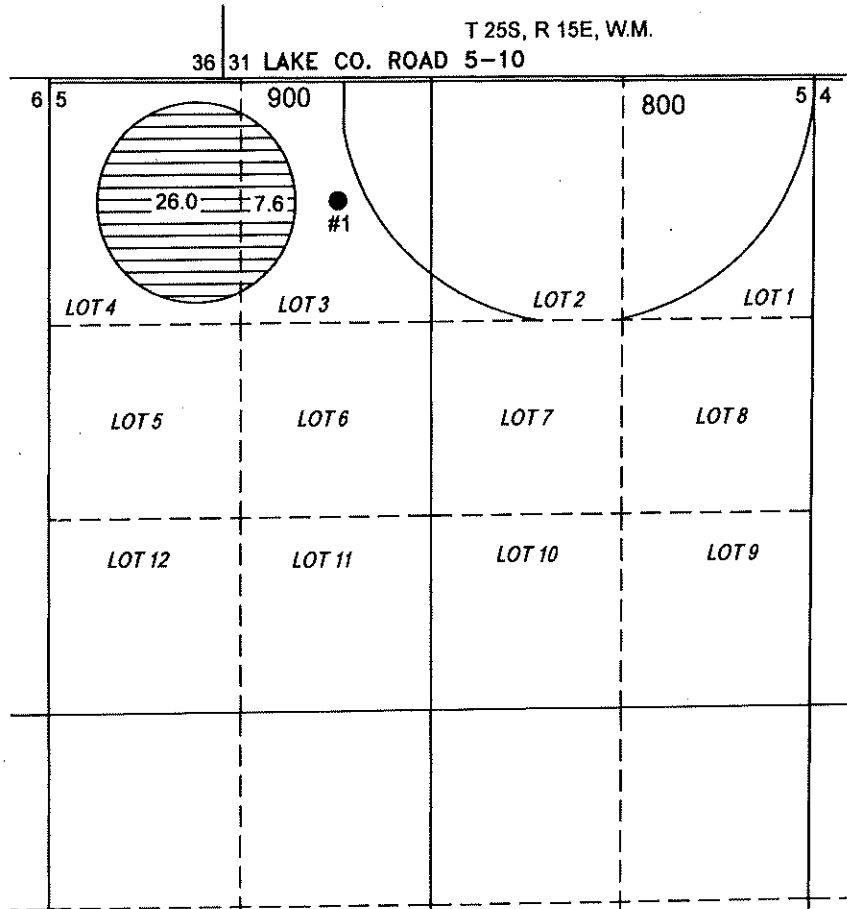

33.6 ACRES IR AUTHORIZED BY
G-8572 FROM POA #1 BY T-12704.

- ALBERTSON #1 (LAKE 377)
LOCATED IN THE LOT 3 SECTION 5, T26S R15E, W.M. AND
12-1/2 CHAINS SOUTH AND 30 CHAINS EAST FROM THE NW
CORNER OF SECTION 5.
FLOW METER IS LOCATED ON CENTER PIVOT SPRINKLER.

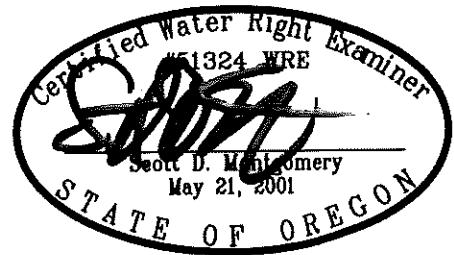

RENEWAL DATE: 12/31/2022

THIS MAP IS FOR THE PURPOSE OF LOCATING A WATER
RIGHT ONLY AND HAS NO INTENT TO PROVIDE LEGAL
DIMENSIONS OR THE LOCATION OF PROPERTY LINES.

PREPARED FOR:

SCOTT & JOSE TOBIASSON
P.O. BOX 93
FT. ROCK, OR 97735

PREPARED BY:



ALL POINTS ENGINEERING AND SURVEYING, INC.
P.O. BOX 767 TERREBONNE, OR 97760
(541) 548-5833 www.APEandS.com