CLAIM OF BENEFICIAL USE SURVEY FOR T-13523
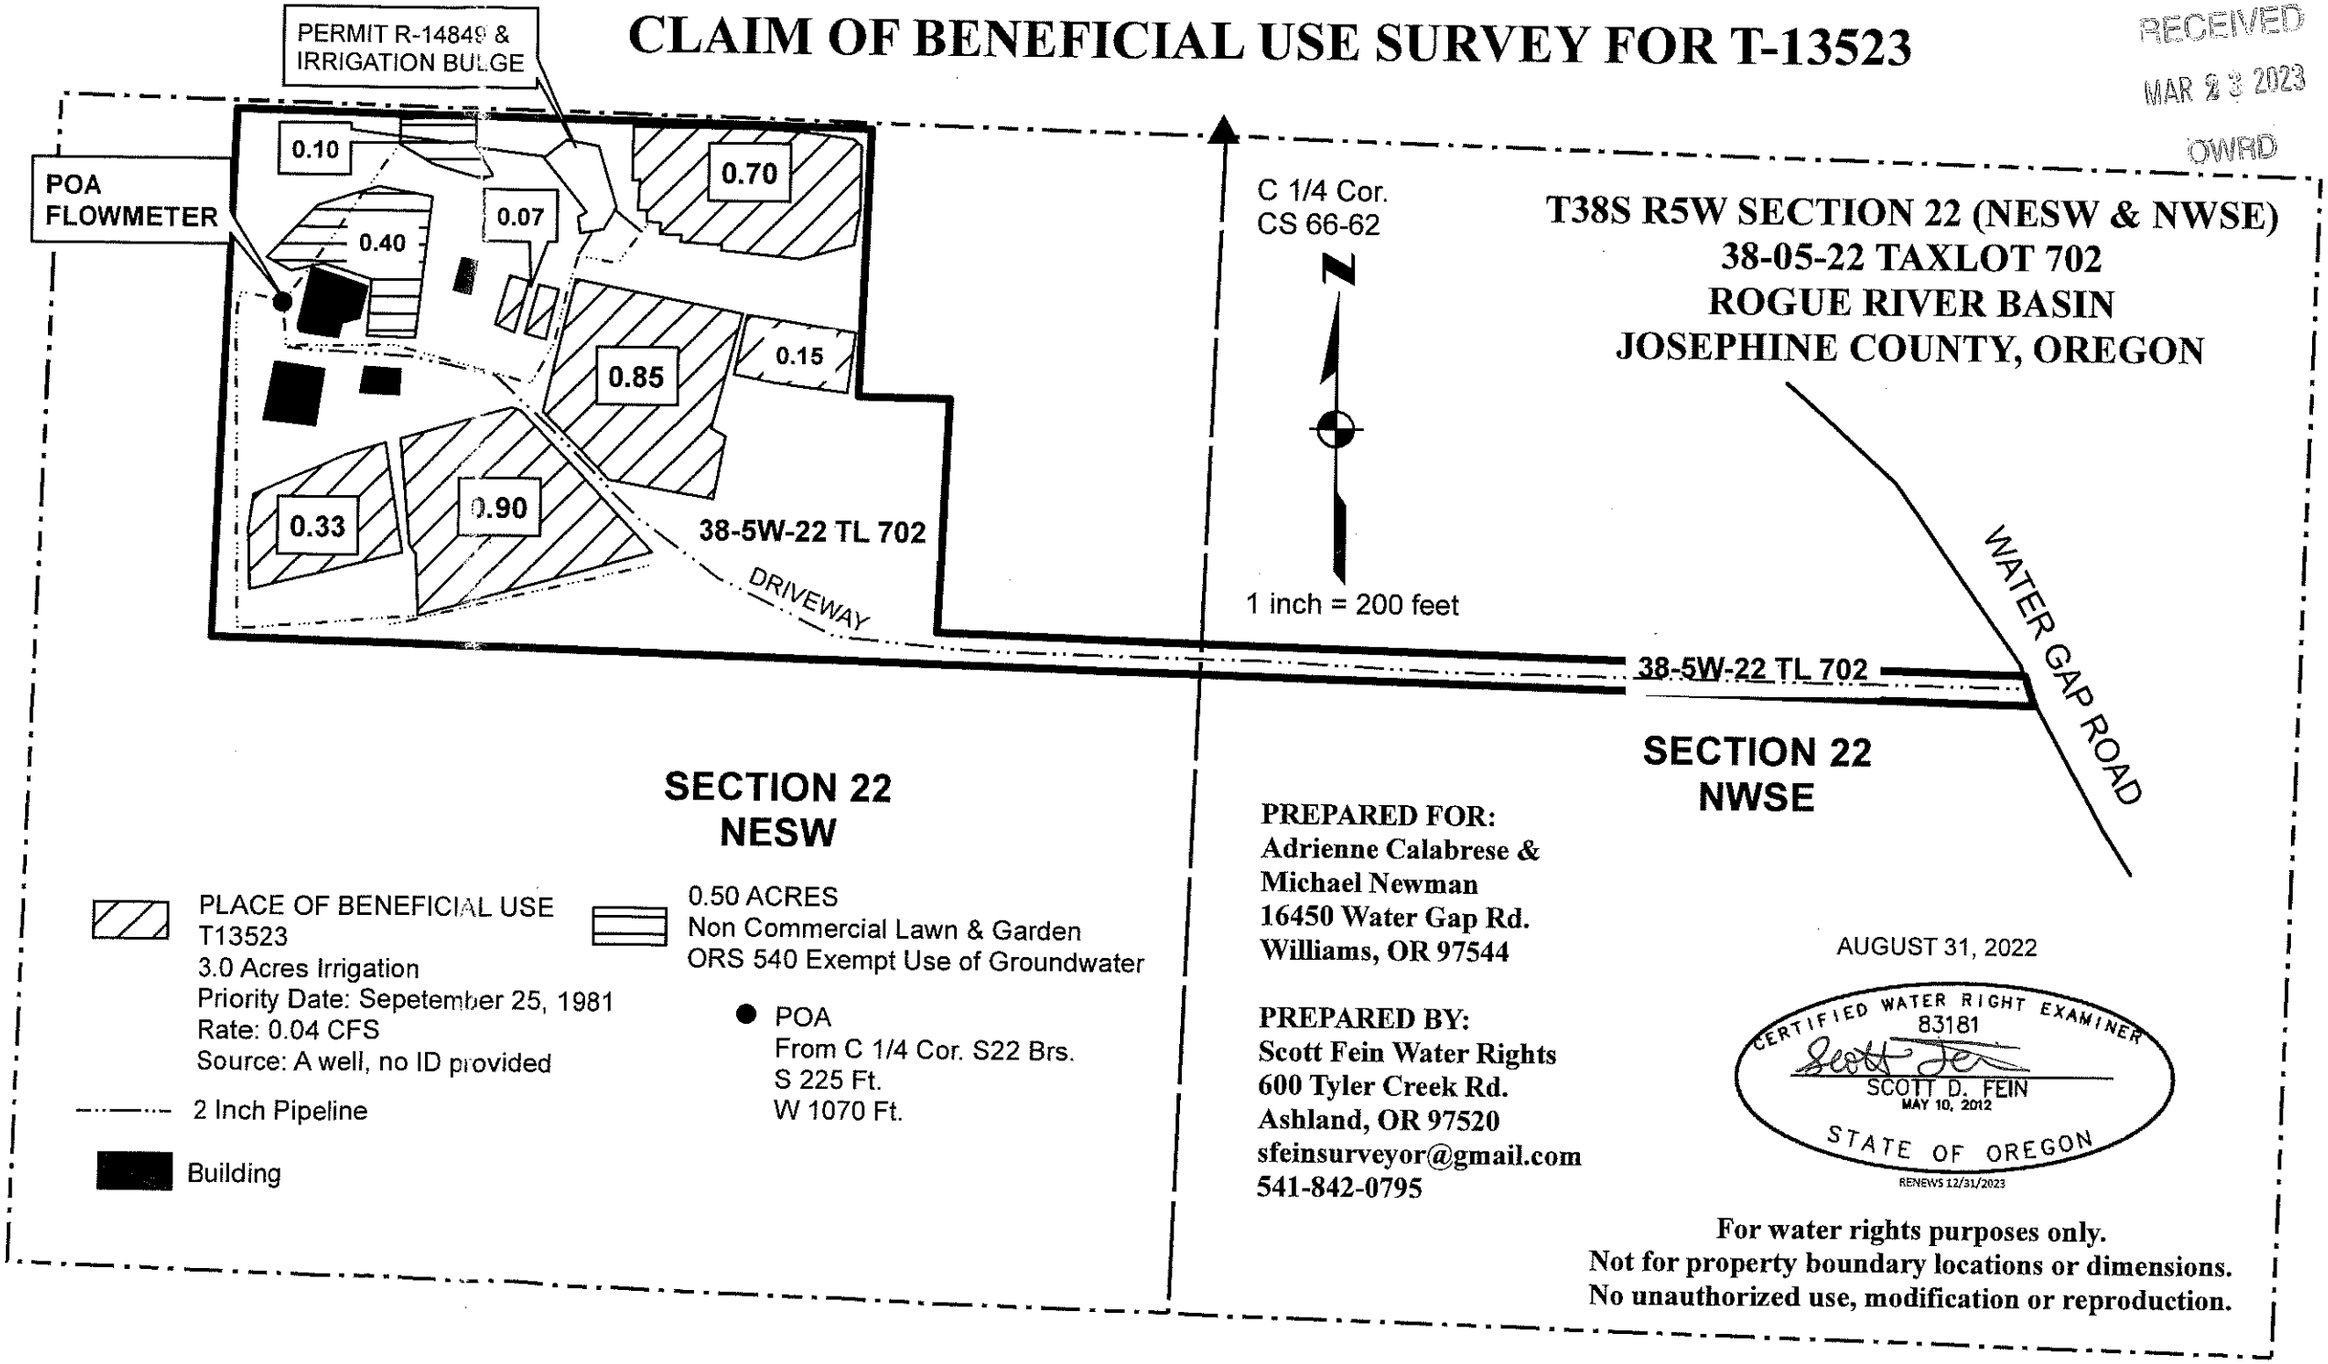
RECEIVED
MAR 23 2023
OWRD