


T.6S. R.1W. Sec. 31 & 32, W.M.

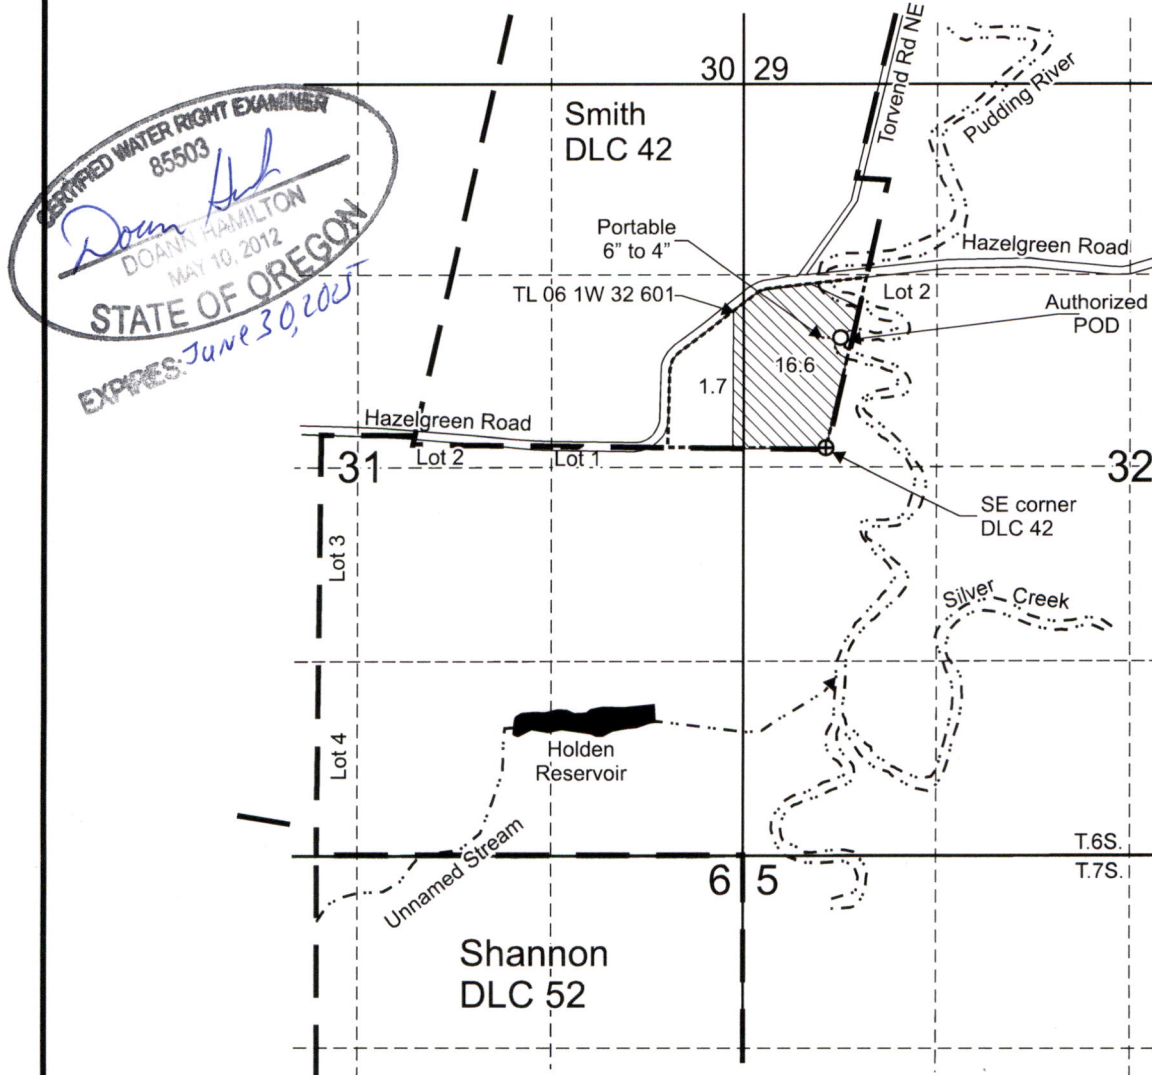

CERTIFIED WATER RIGHT EXAMINER
 85503
Donna Hamilton
 DONNA HAMILTON
 MAY 10, 2012
STATE OF OREGON
 EXPIRES: June 30, 2025

Received by OWRD
 NOV 04 2024
 Salem, OR

Authorized POD is located 760 feet north and 100 feet east from the SE corner, DLC 42.


 Area (18.3 Acres) irrigated under T-13182, formerly Certificate 40143, priority date: 5-13-1968.

----- Tax lot boundary

— . — Donation Land Claim boundary

..... Water main line, portable 6 inch from pump to hydrant, with 4 inch portable main to field.

Scale: 1" = 1,320'

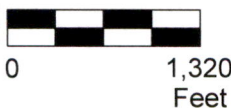

This map was prepared for the purpose of identifying the location of a water right only and is not intended to provide legal dimensions or location of property ownership lines.




Claim of Beneficial Use Map
T-13182, formerly Certificate 40143

Steven V. and Constance A. Johnson
 T.6S. R.1W. Sec. 31 & 32, W.M.

Pacific Hydro-Geology Inc.

10/2024

T.6S. R.1W. Sec. 31 & 32, W.M.

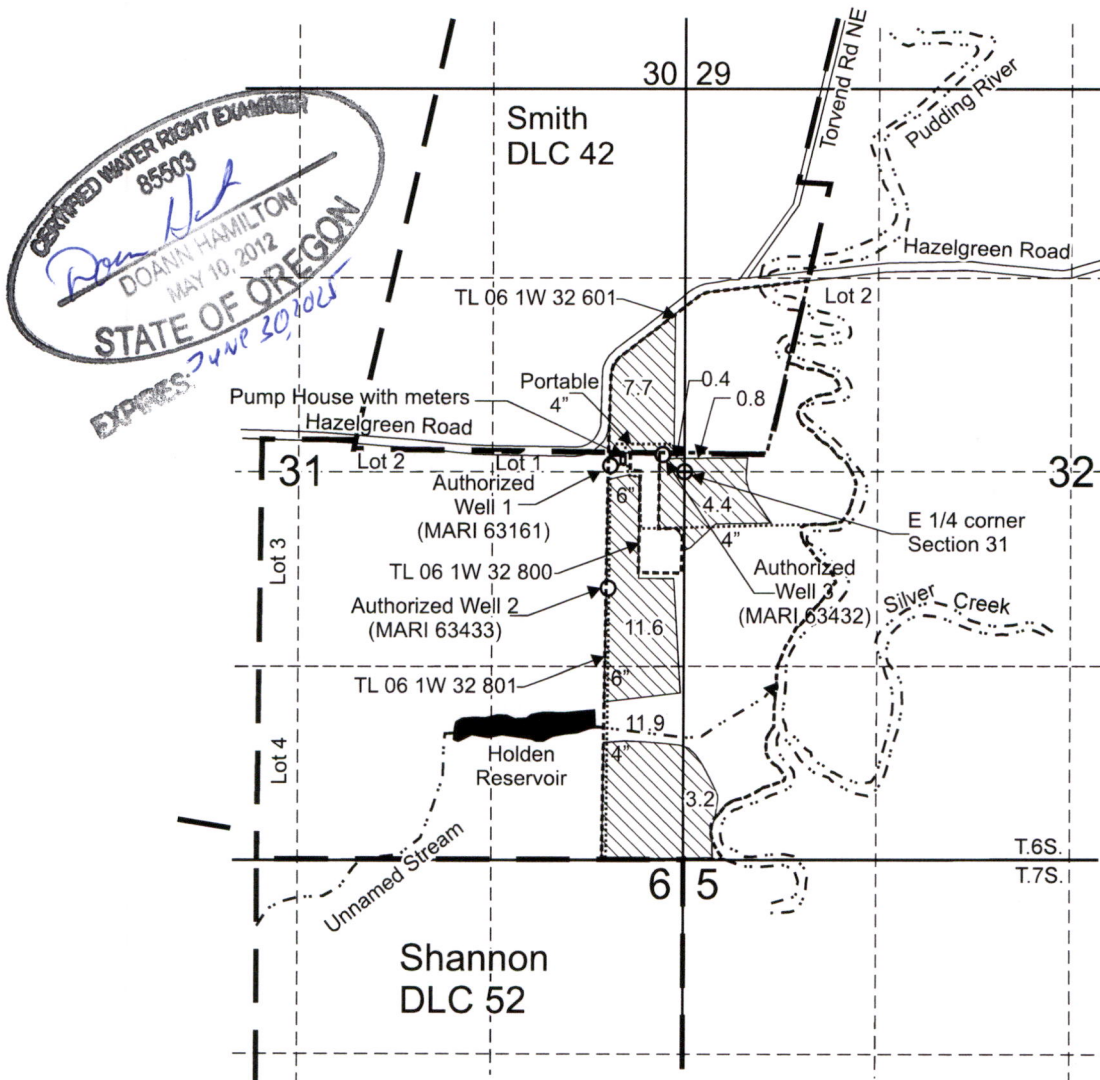

Received by OWRD

NOV 04 2024

Salem, OR

Authorized Well 1 (MARI 63161) is located 40 feet north and 510 feet west from the E 1/4 corner, Section 31.
 Authorized Well 2 (MARI 63433) is located 800 feet south and 520 feet west from the E 1/4 corner, Section 31.
 Authorized Well 3 (MARI 63432) is located 110 feet north and 150 feet west from the E 1/4 corner, Section 31.


 Area (40.0 Acres) irrigated under T-13182, formerly, Certificate 94117, priority date: 6-24-1992.

----- Tax lot boundary

— • — Donation Land Claim boundary

..... Water main line, portable 4 inch from hydrant to field

Scale: 1" = 1,320'

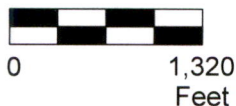

This map was prepared for the purpose of identifying the location of a water right only and is not intended to provide legal dimensions or location of property ownership lines.

Claim of Beneficial Use Map
T-13182, formerly Certificate 94117

Steven V. and Constance A. Johnson
 T.6S. R.1W. Sec. 31 & 32, W.M.

Pacific Hydro-Geology Inc.

10/2024