


CLAIM OF BENEFICIAL USE MAP

TO CHANGE POINTS OF APPROPRIATION AND PLACE OF USE FOR TRANSFER APPLICATION T-12354

SECTIONS 25 & 36, TOWNSHIP 26 SOUTH, RANGE 34 EAST, W.M.
TAX LOTS: 600, 4800, & 4900

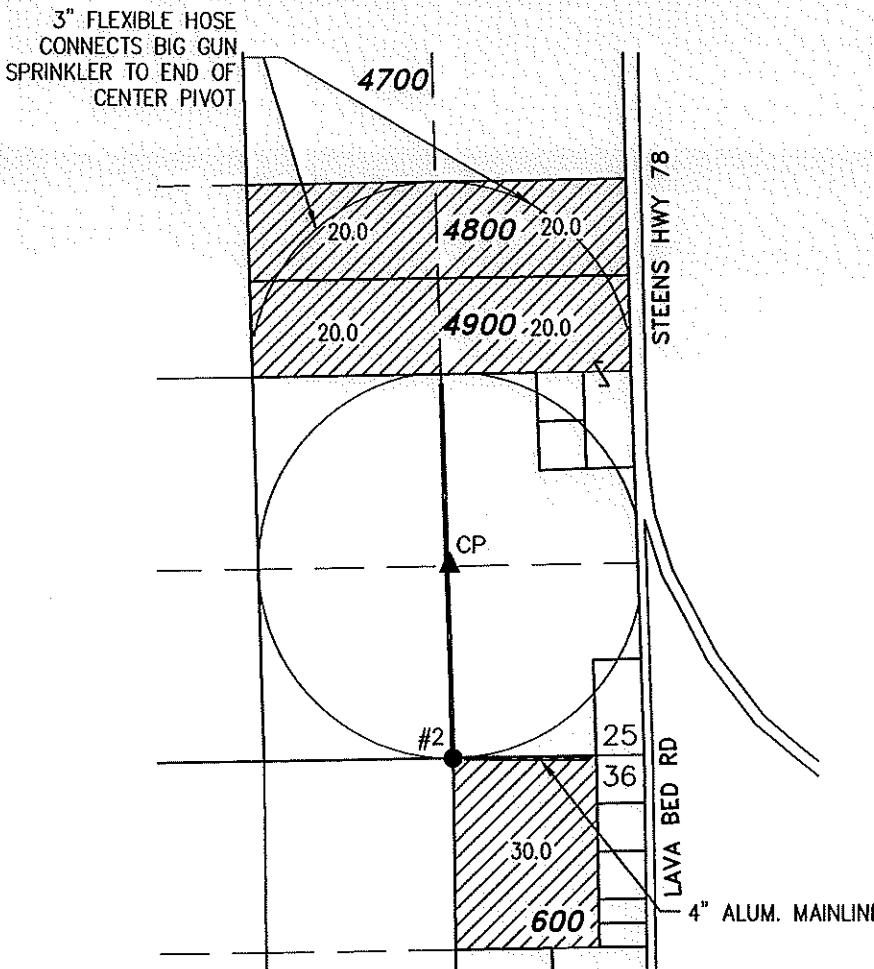


- #2
(HARN 51923) LOCATED 30' NORTH & 1320' WEST FROM THE SE CORNER SECTION 25. FLOW METER IS LOCATED 3 FEET SOUTH FROM CP.
- ▲ CENTER PIVOT 'CP'
LOCATED 1325' NORTH & 1290' WEST FROM THE SE CORNER SECTION 25.


BURIED 6 OR 8 INCH STEEL PIPE

THIS MAP IS FOR THE PURPOSE OF LOCATING A WATER
RIGHT ONLY AND HAS NO INTENT TO PROVIDE LEGAL
DIMENSIONS OR THE LOCATION OF PROPERTY LINES

SECTION 5, TOWNSHIP 27 SOUTH, RANGE 34 EAST, W.M.
TAX LOT: 601

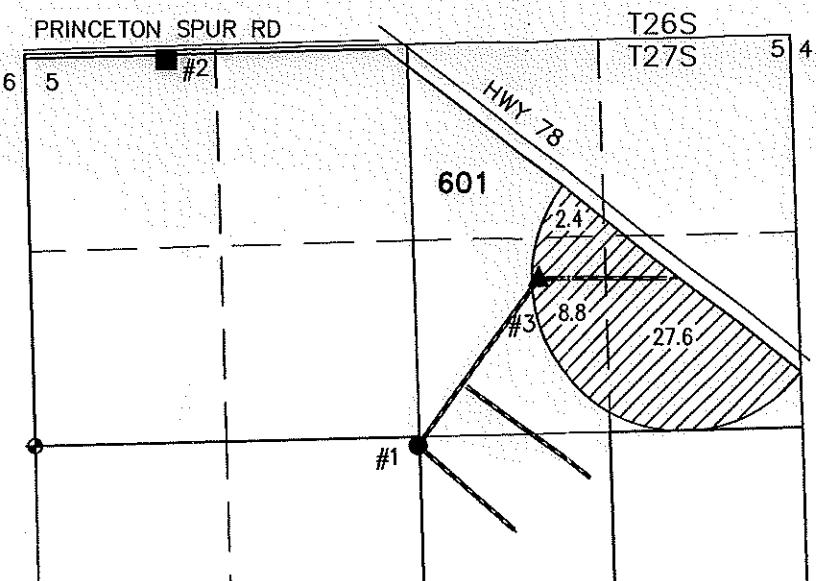


- #1
(HARN 1489) LOCATED 2' SOUTH & 2621' EAST FROM THE W 1/4 CORNER SECTION 5. FLOW METER IS LOCATED 4 FEET SOUTH FROM WELL.
- #3
(HARN 52056) LOCATED 1138' NORTH & 3471' EAST FROM THE W 1/4 CORNER SECTION 5. FLOW METER IS LOCATED 3.5 FEET SOUTH FROM WELL.

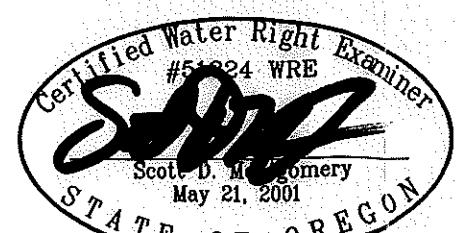

RENEWAL DATE: 12/31/2020

SECTIONS 6 & 7, TOWNSHIP 26 SOUTH, RANGE 34 EAST, W.M.
TAX LOT: 400

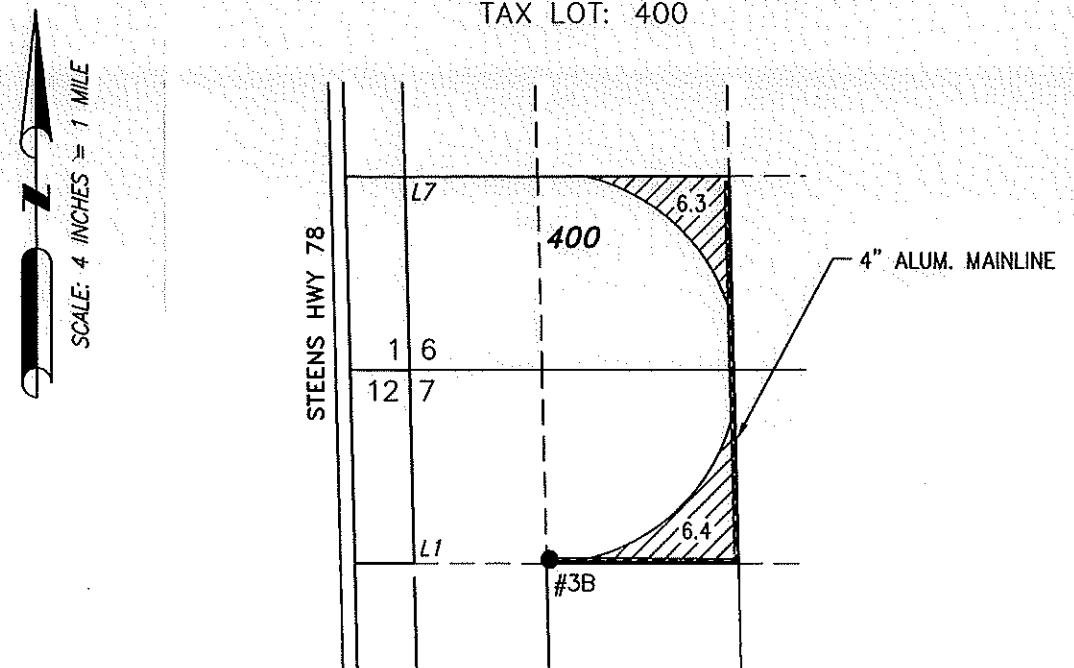

- #3B
(HARN 1414) LOCATED 1295' SOUTH & 960' EAST FROM THE NW CORNER SECTION 7. FLOW METER IS LOCATED 6 FEET WEST FROM WELL.

RECEIVED

AUG 26 2020

OWRD

PREPARED FOR:

JIM AND SUE GILMOUR
30427 STELLMACHER DRIVE
ALBANY, OR 97321

PREPARED BY:

ALL POINTS ENGINEERING AND SURVEYING, INC.
P.O. BOX 767 TERREBONNE, OR 97760
(541) 548-5833
www.APEandS.com

Exhibit "A"

Received

Received

JAN 3 2024


OWRD

OWRD

TRANSFER MAP TO ACCOMPANY APPLICATION TO ADD A POINT OF APPROPRIATION AND CHANGE PLACE OF USE FOR JAMES & SUE GILMOUR

TOWNSHIP 26 SOUTH, RANGE 34 EAST, SECTION 7, W.M.
TAX LOT: 400

"TO"

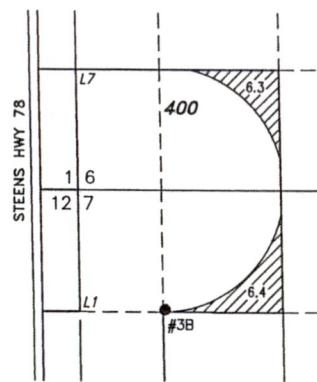

- **HELL 3B (HARN 1414)**
LOCATED IN THE NE 1/4 NW 1/4 SECTION 7, T26S R34E, W.M. AND 1285 FEET SOUTH AND 960 FEET EAST FROM THE NW CORNER OF SECTION 7.

12.7 ACRES WATER RIGHTS FROM CERTIFICATE 91150 (PERMIT G-12961), TRANSFERRED AS SHOWN.

TOWNSHIP 26 SOUTH, RANGE 33 EAST, SECTIONS 25 & 36, W.M.
TAX LOTS: 4800, 4900, & 600

"TO"



- **HELL 2 (HARN 51923)**
LOCATED IN THE SE 1/4 SE 1/4 SECTION 25, T26S R33E, W.M. AND 30 FEET NORTH AND 1320 FEET WEST FROM THE SE CORNER OF SECTION 25.
- ▲ **HELL 4 (NOT CONSTRUCTED)**
LOCATED IN THE SE 1/4 NE 1/4 SECTION 25, T26S R33E, W.M. AND 660 FEET NORTH AND 80 FEET WEST FROM THE E 1/4 CORNER OF SECTION 25.


110.0 ACRES WATER RIGHTS FROM CERTIFICATE 91150 (PERMIT G-12961), TRANSFERRED AS SHOWN.

CN

Retained By Seller
Jm Gilmour to
Transfer

TOWNSHIP 27 SOUTH, RANGE 34 EAST, SECTION 5, W.M.
TAX LOT: 601

"TO"

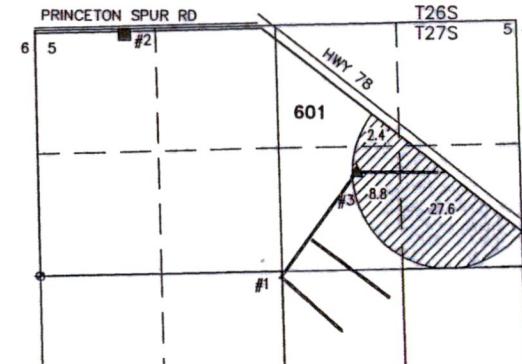

- **HELL 1 (HARN 1489)**
LOCATED IN THE NE 1/4 SW 1/4 SECTION 5, T27S R34E, W.M. AND 2 FEET SOUTH AND 2621 FEET EAST FROM THE W 1/4 CORNER OF SECTION 5.
- ▲ **HELL 3 (HARN 52056)**
LOCATED IN THE SW 1/4 NE 1/4 SECTION 5, T27S R34E, W.M. AND 1130 FEET NORTH AND 3447 FEET EAST FROM THE W 1/4 CORNER OF SECTION 5.


38.8 ACRES WATER RIGHTS FROM CERTIFICATE 91150 (PERMIT G-12961), TRANSFERRED AS SHOWN.

RECEIVED BY OWRD

JUN 29 2016

SALEM, OR

This is the only
water right sold
in attached Deed.

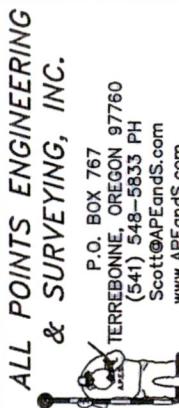 <p>State of Oregon Water Right Examiner May 2, 2001 RENEWAL DATE: 12/31/2016</p>	
<p>ALL POINTS ENGINEERING & SURVEYING, INC.</p>  <p>P.O. BOX 767 TERREBONNE, OREGON 97770 (541) 548-5835 PH Scott@APEands.com www.APEands.com</p>	
PROJECT No. 16-048	PREPARED AT THE REQUEST OF:
<p>RIVERBOTTOM FARMS 30427 STELLMACHER DRIVE ALBANY, OR 97321</p>	
<p>3-1/2" ALUMINUM CAPPED SECTION MONUMENT THIS MAP IS FOR THE PURPOSE OF LOCATING A WATER RIGHT ONLY AND HAS NO INTENT TO PROVIDE LEGAL DIMENSIONS OR THE LOCATION OF PROPERTY LINES</p>	

+ 1245

14399 -

TRANSFER MAP TO ACCOMPANY APPLICATION TO
 CHANGE PLACE OF USE AND ADD A POINT OF Received
 APPROPRIATION FOR
 JAMES & SUE GILMOUR


JAN 31 2024

OWRD

TOWNSHIP 27 SOUTH, RANGE 34 EAST, SECTIONS 5 & 6, W.M.

TAX LOTS: 601

"TO"

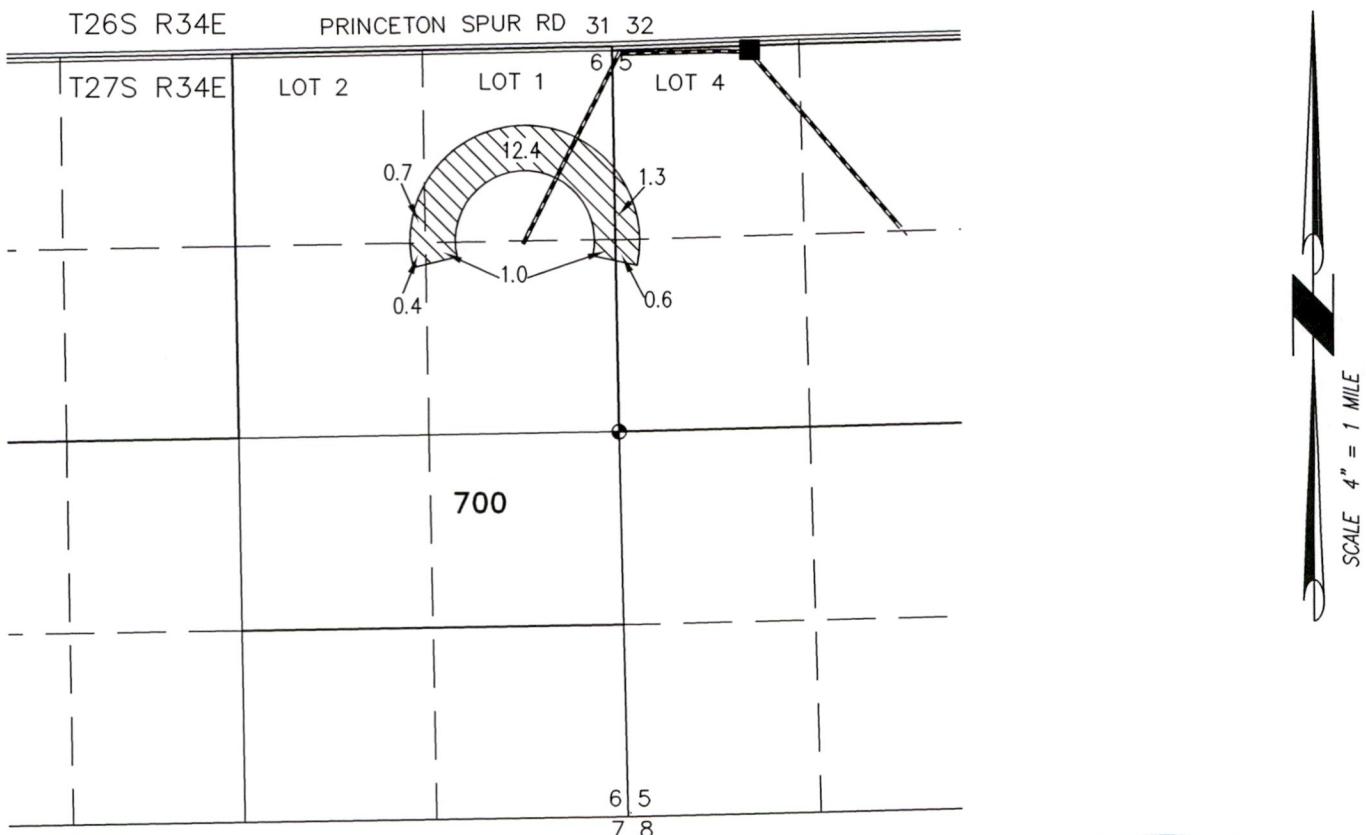


BUFFALO WELL (HARN 50318)

LOCATED IN THE NW 1/4 NW 1/4 SECTION 5, T27S R34E, W.M. AND 35 FEET SOUTH AND 975 FEET EAST FROM THE NW CORNER OF SECTION 5.



16.4 ACRES WATER RIGHTS FROM
 CERTIFICATE 97231 (PERMIT G-12961),
 TRANSFERRED, AS SHOWN.

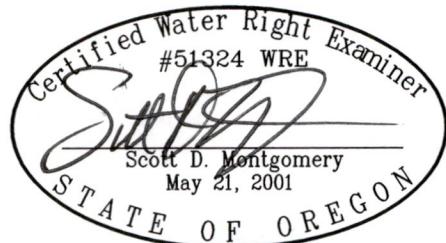

RENEWAL DATE: 12/31/2024

THIS MAP IS FOR THE PURPOSE OF LOCATING A WATER
 RIGHT ONLY AND HAS NO INTENT TO PROVIDE LEGAL
 DIMENSIONS OR THE LOCATION OF PROPERTY LINES

PROJECT No. 22-136

PREPARED AT THE REQUEST OF:
 RIVERBOTTOM FARMS
 30427 STELLMACHER DRIVE
 ALBANY, OR 97321

ALL POINTS ENGINEERING
 & SURVEYING, INC.




P.O. BOX 767
 TERREBONNE, OREGON 97760
 (541) 548-5833 PH
 Scott@APEandS.com
 www.APEandS.com

TRANSFER MAP TO ACCOMPANY APPLICATION TO
CHANGE PLACE OF USE AND ADD A POINT OF
APPROPRIATION FOR
JAMES & SUE GILMOUR

TOWNSHIP 26 SOUTH, RANGE 33 EAST, SECTIONS 25 & 36, W.M.
TAX LOTS: 100, 4800, 4900, & 600
"FROM"

Received
JAN 31 2024
OWRD

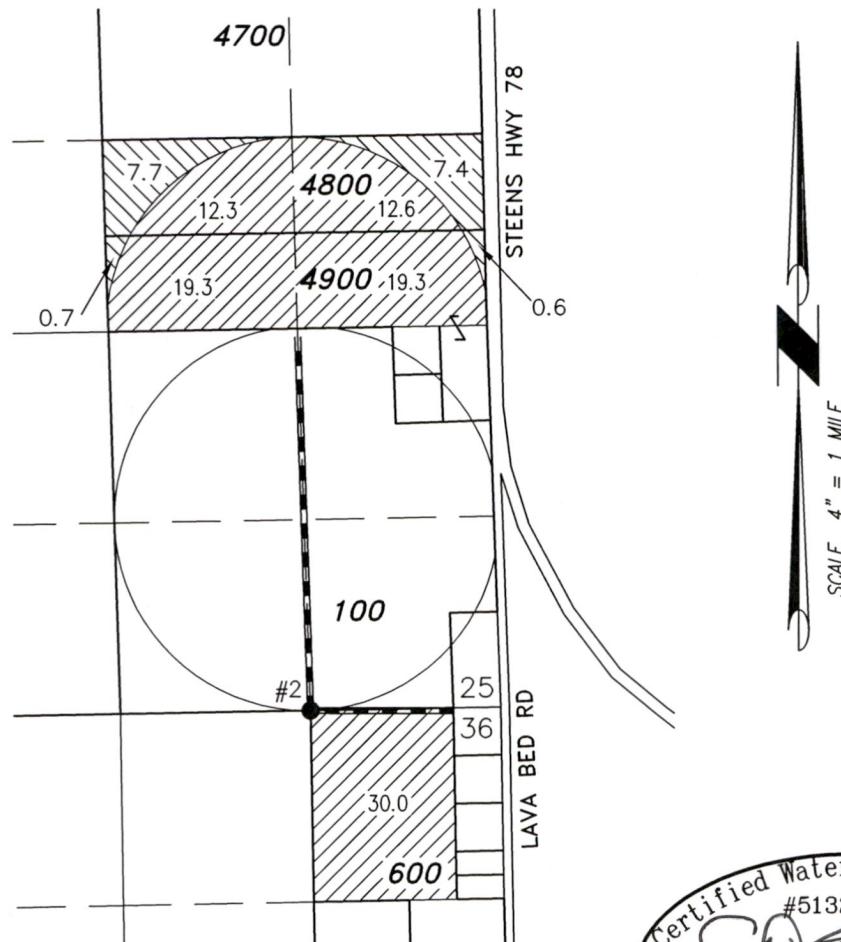


■ WELL 2 (HARN 51923)

LOCATED IN THE SE 1/4 SE 1/4 SECTION 25, T26S
R33E, W.M. AND 30 FEET NORTH AND 1320 FEET WEST
FROM THE SE CORNER OF SECTION 25.



16.4 ACRES WATER RIGHTS FROM
CERTIFICATE 97231 (PERMIT G-12961),
TRANSFERRED, AS SHOWN.

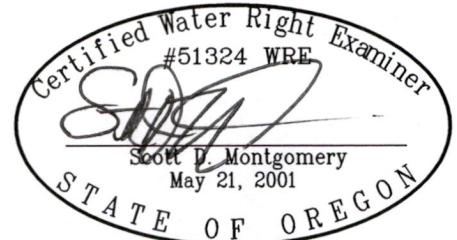

RENEWAL DATE: 12/31/2024



93.5 ACRES WATER RIGHTS FROM
CERTIFICATE 97231 (PERMIT G-12961),
REMAIN, AS SHOWN.

THIS MAP IS FOR THE PURPOSE OF LOCATING A WATER
RIGHT ONLY AND HAS NO INTENT TO PROVIDE LEGAL
DIMENSIONS OR THE LOCATION OF PROPERTY LINES

PROJECT No. 22-136

PREPARED AT THE REQUEST OF:
RIVERBOTTOM FARMS
30427 STELLMACHER DRIVE
ALBANY, OR 97321

ALL POINTS ENGINEERING
& SURVEYING, INC.



P.O. BOX 767
TERREBONNE, OREGON 97760
(541) 548-5833 PH
Scott@APEandS.com
www.APEandS.com