


TOWNSHIP 34^S, RANGE 1^W, W. M.

North

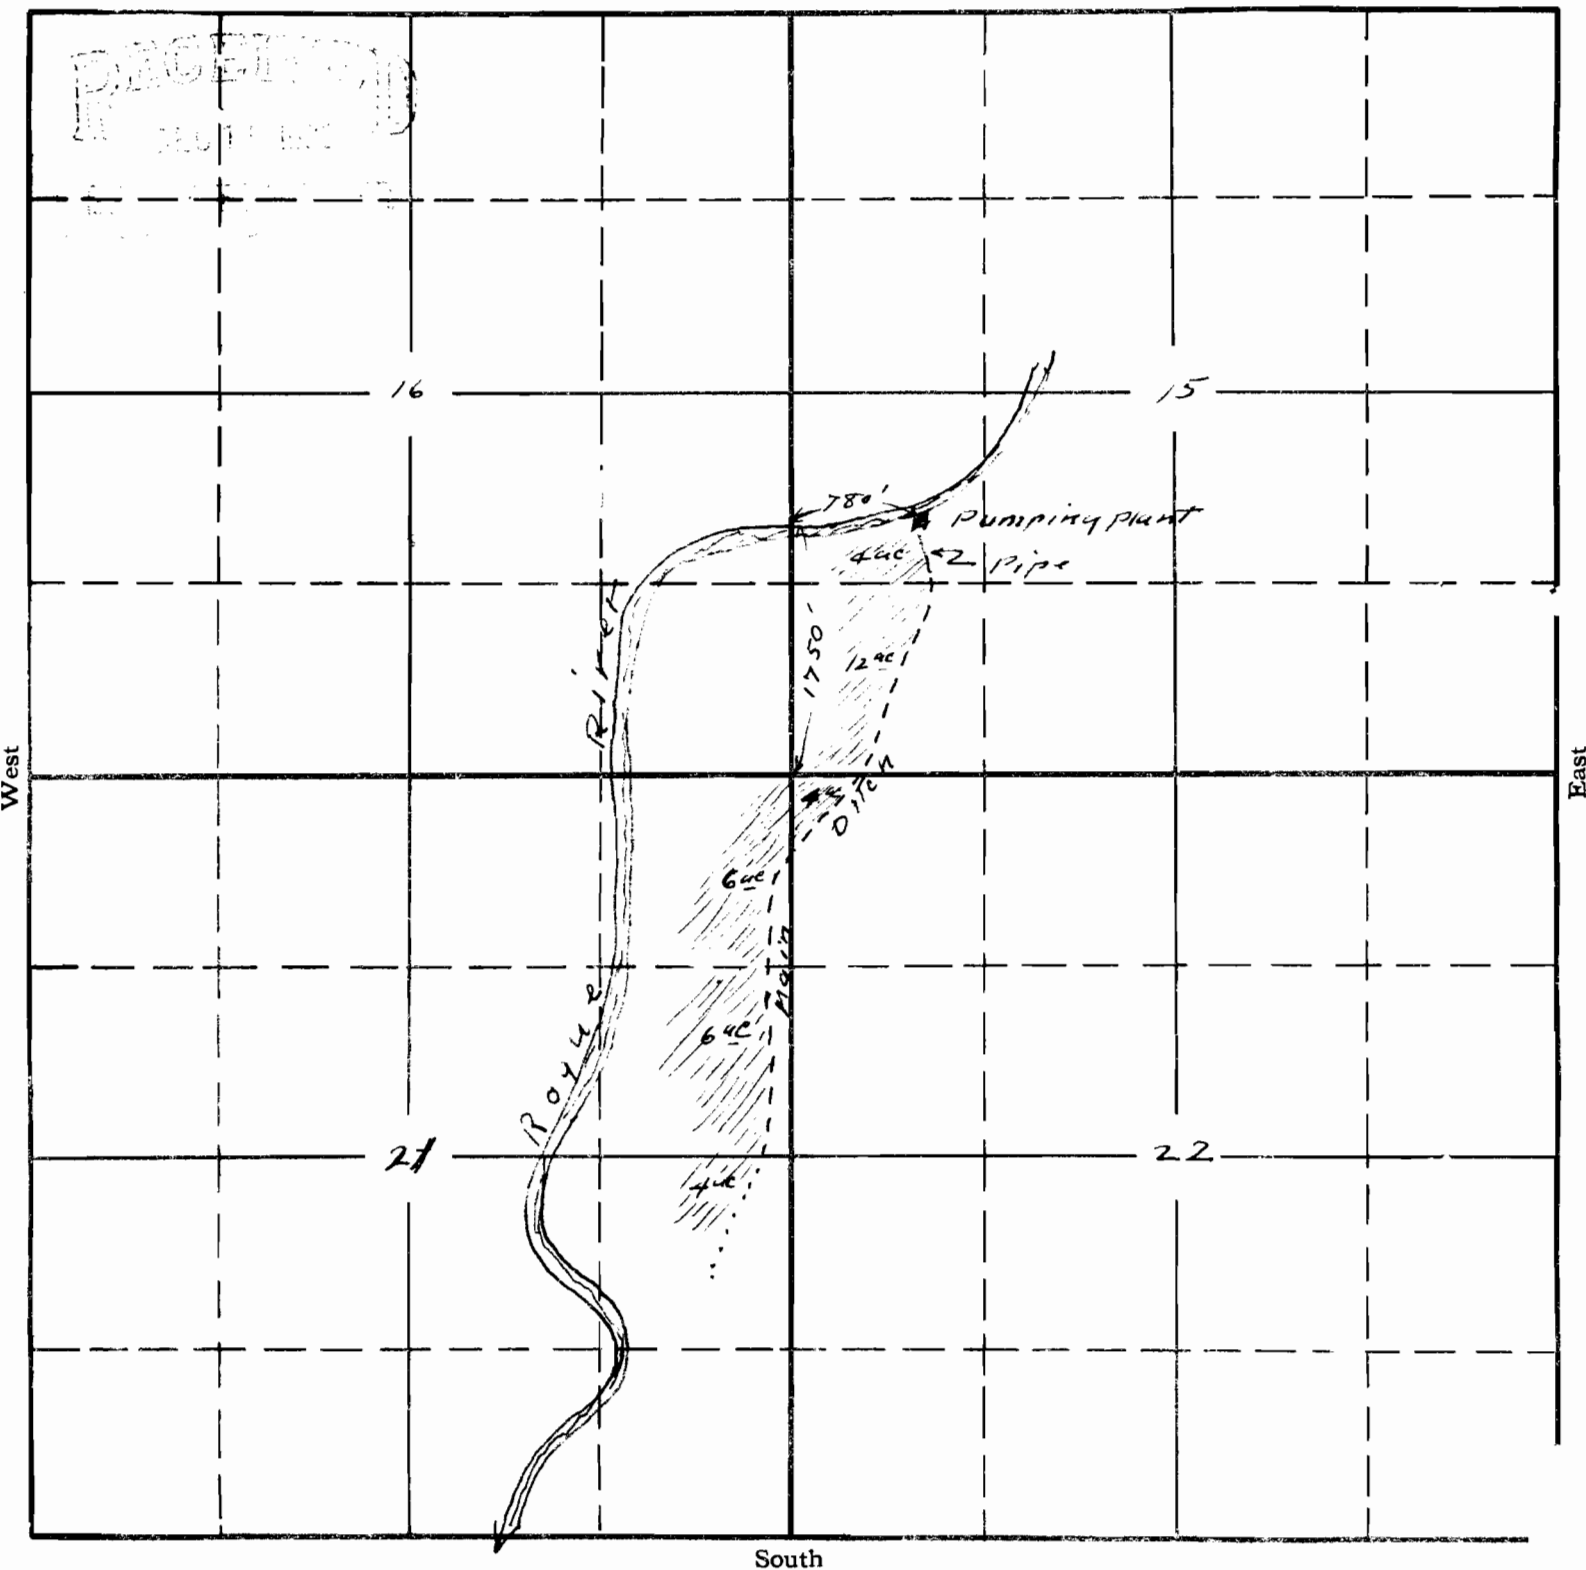

South

Map to accompany application
of T. J. & V. Johnson for irrigation


APPLICATION No. 15220

PERMIT No. 11137

HEIDI AND FREDRICK WAHL
161 EDGEWOOD PARK DRIVE
SHADY COVE, OR 97539

C-45291
HISTORIC POD CHANGE
APPLICATION

SITUATED IN SECTION 21
TOWNSHIP 34 S
RANGE 1 W, W.M.
JACKSON COUNTY OREGON

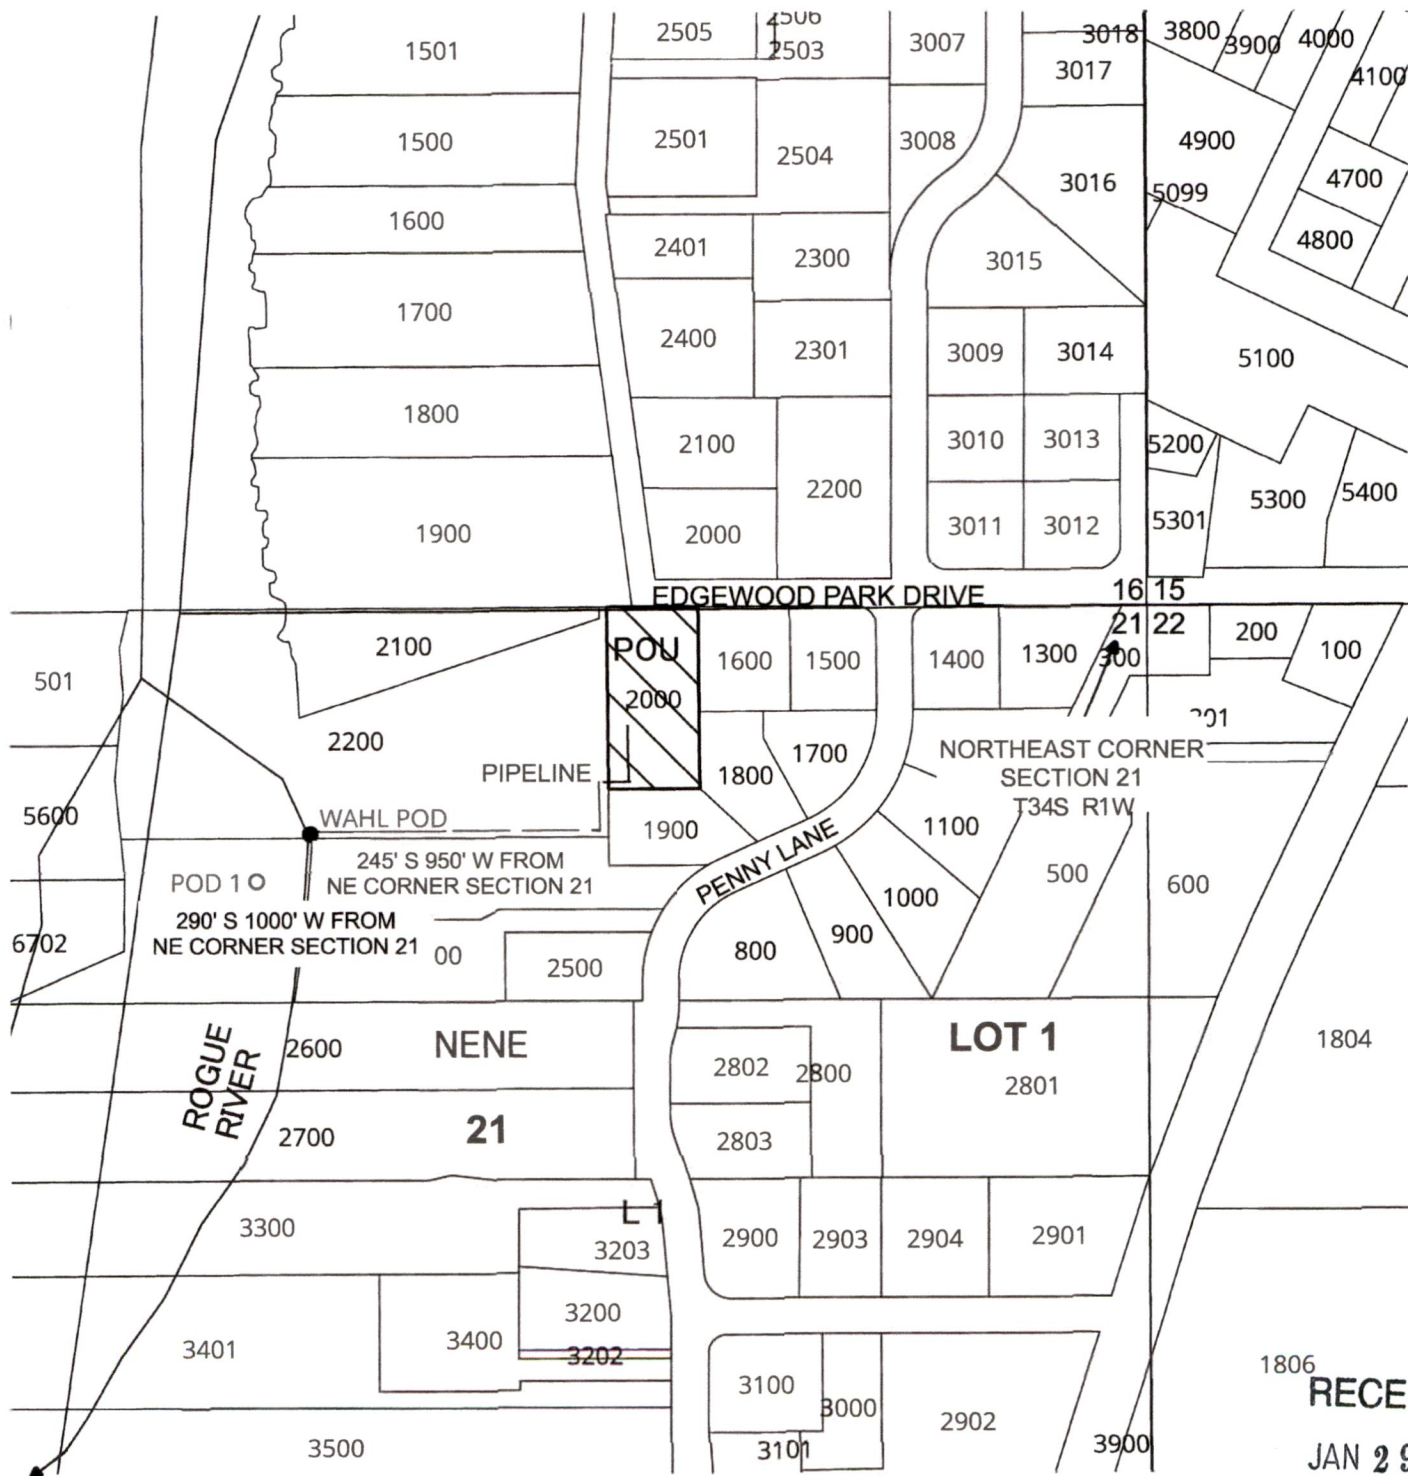

RECEIVED
JAN 29 2024

OWRD


1" = 200 feet

This map is not intended to provide
legal dimensions or locations of
property ownership lines

ParsonsWater Consulting LLC
rick.parsons@parsonwater.com
541.499.0257 303.667.5067

14396 -