


T21S, R5W, WM T21S, R4W, WM

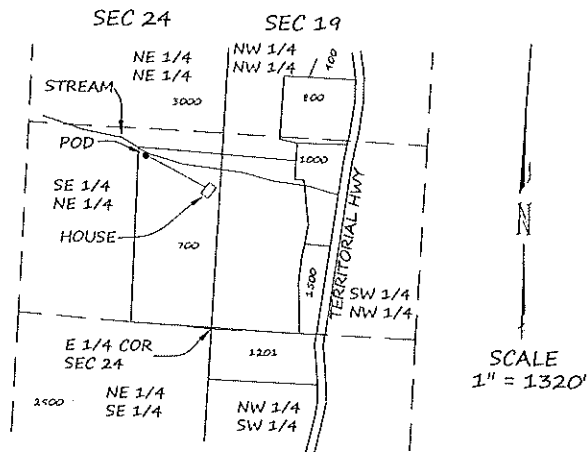


APPLICATION S-72980 PERMIT S-52182

POD LOCATION
N22°W 126.9' FROM
E 1/4 COR SEC 24

FINAL PROOF SURVEY
FOR
WESLEY GRIFFITH
1180 TERRITORIAL HWY
COTTAGE GROVE, OR 97424
BY

H. TIMOTHY FASSBENDER, PLS, CWRE
2896 SARAH LN
EUGENE, OR 97408
SEPTEMBER 22, 2022

NOTE:
THE PREPARATION OF THE MAP WAS
FOR THE PURPOSE OF IDENTIFYING THE
LOCATION OF THE WATER RIGHT ONLY.
IT IS NOT INTENDED TO PROVIDE
LOCATION NOR DIMENSIONS OF PROPERTY
OWNERSHIP LINES.

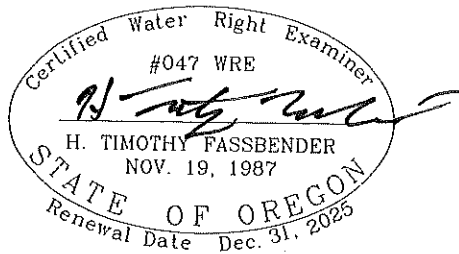

Received
JUN 23 2025
OWRD