



MAP TO ACCOMPANY APPLICATION TO CHANGE POINT OF APPROPRIATION AND PLACE OF USE PERTAINING TO CERTIFICATE 82463 FOR RATTLESNAKE CREEK LAND & CATTLE CO, LLC

TAX LOTS 100 & 200
IN SECTION 16, TOWNSHIP 24 SOUTH, RANGE 33 EAST, W.M.
HARNEY COUNTY, OREGON

RECEIVED

JAN 11 2023

OWRD

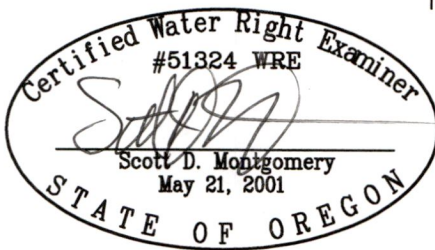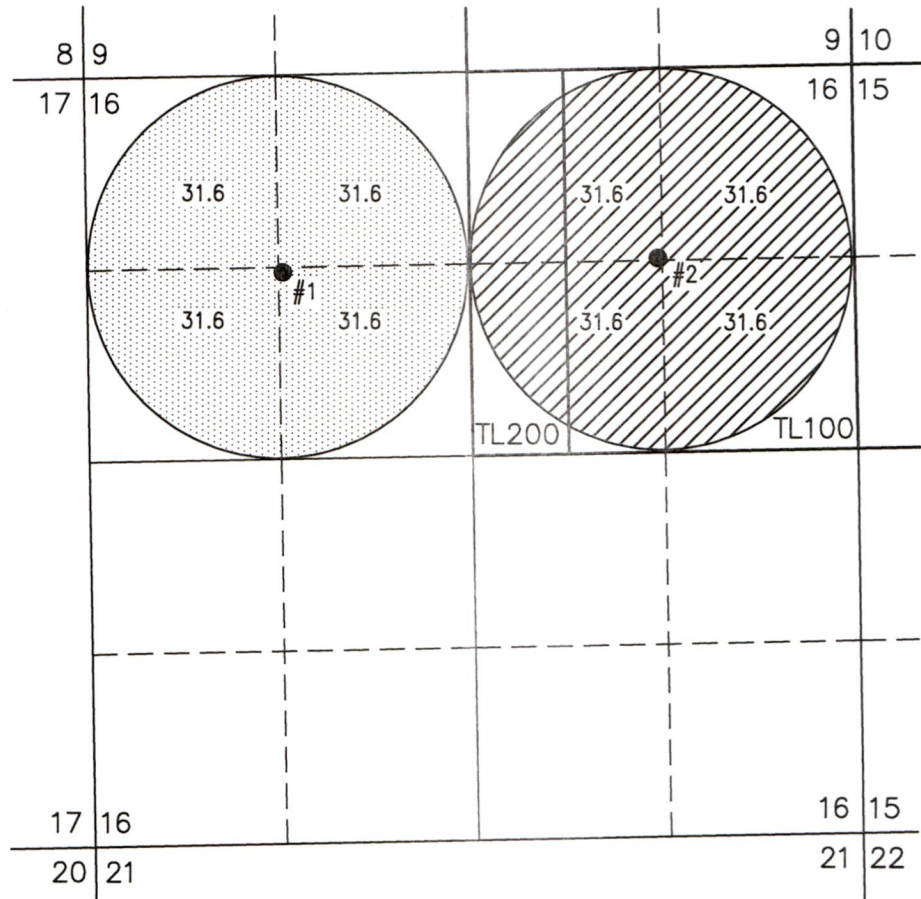

RENEWAL DATE: 12/31/2024

THIS MAP IS FOR THE PURPOSE OF LOCATING A WATER
RIGHT ONLY AND HAS NO INTENT TO PROVIDE LEGAL
DIMENSIONS OR THE LOCATION OF PROPERTY LINES.

- WELL #1 (HARN 1012) AUTHORIZED BY C82463, LOCATED 1350 FEET SOUTH AND 1350 FEET EAST FROM THE NW CORNER OF SECTION 16.
- WELL #2 (HARN 1011) AUTHORIZED BY C82463, LOCATED 1300 FEET SOUTH AND 1350 FEET WEST FROM THE NE CORNER OF SECTION 16.

 126.4 ACRES IR FROM WELL #2 & C 82463 TRANSFERRED OFF, AS SHOWN.

 126.4 ACRES IR FROM WELL #1 & C 82463 REMAINS, AS SHOWN.

PROJECT No. 22-170

PREPARED AT THE REQUEST OF:

ANDY ROOT
524 HWY 20 N
HINES, OR 97738


**ALL POINTS ENGINEERING
& SURVEYING, INC.**



P.O. BOX 767
TERREBONNE, OREGON 97760
(541) 548-5833 PH
Scott@APEandS.com
www.APEandS.com

14144

T. 24 S., R. 33 E., W.M.

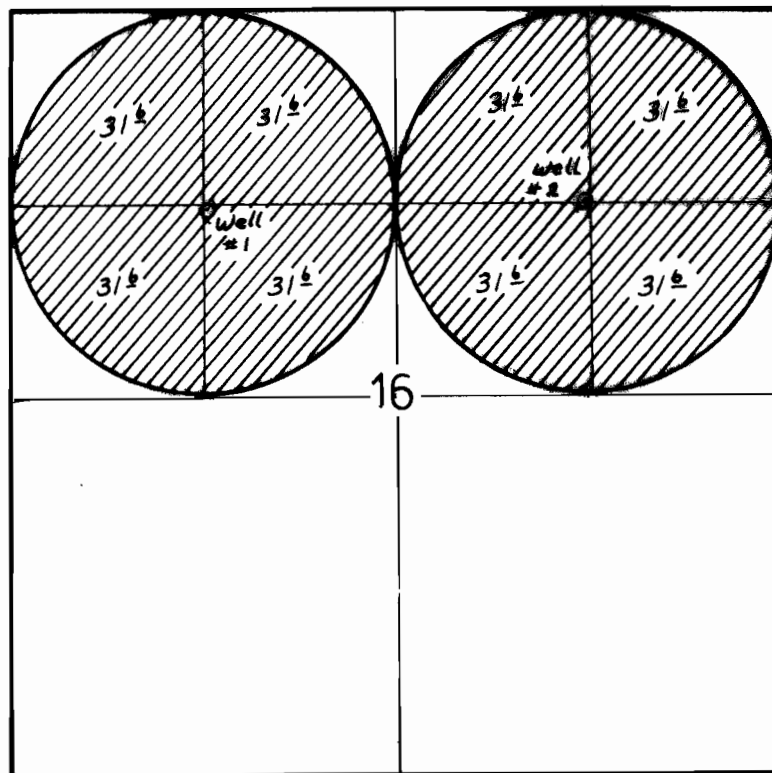

Wells Located - No. 1 - 1350 feet South and
1350 feet East from the NW Corner Section 16;
No. 2 - 1300 feet South and 1350 feet West
from the NE Corner Section 16.

FINAL PROOF SURVEY

UNDER

Application No. G-9558 Permit No. G-9273

IN NAME OF

~~WALTER H. KLEINER~~

Surveyed 10-29, 1990, by K. KEMP

Revised 3-18-99 *AK*
Drafted 3-30-93 JM 41025-179-113R