

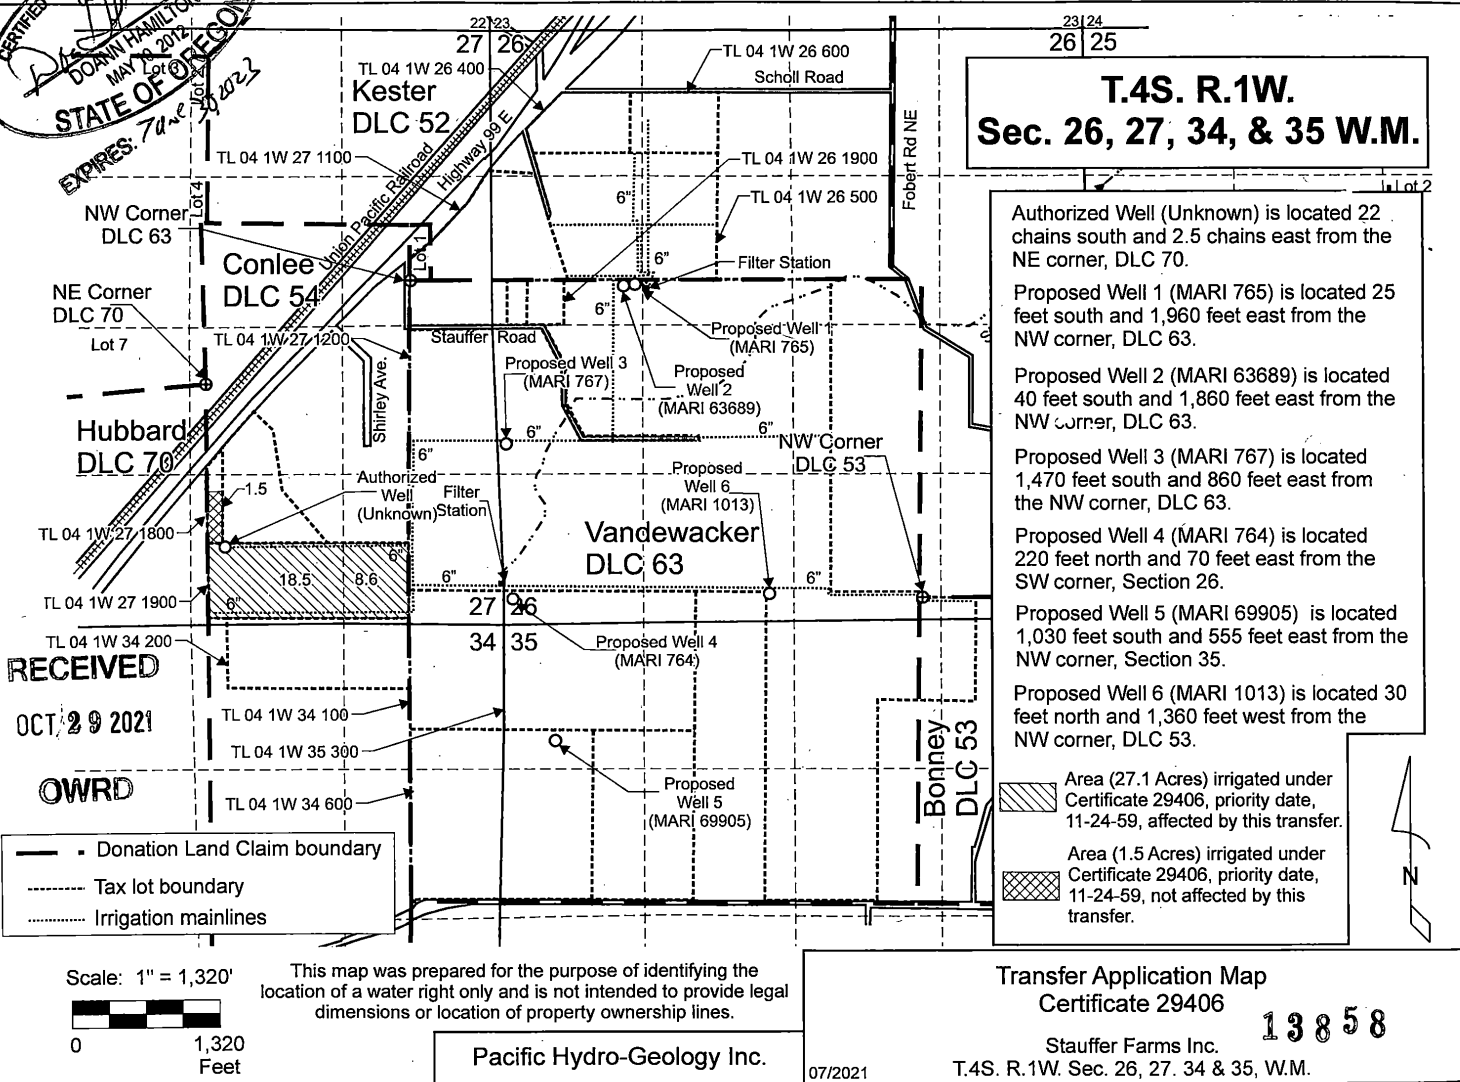


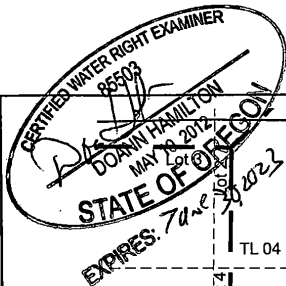

T.4S. R.1W. W.M.

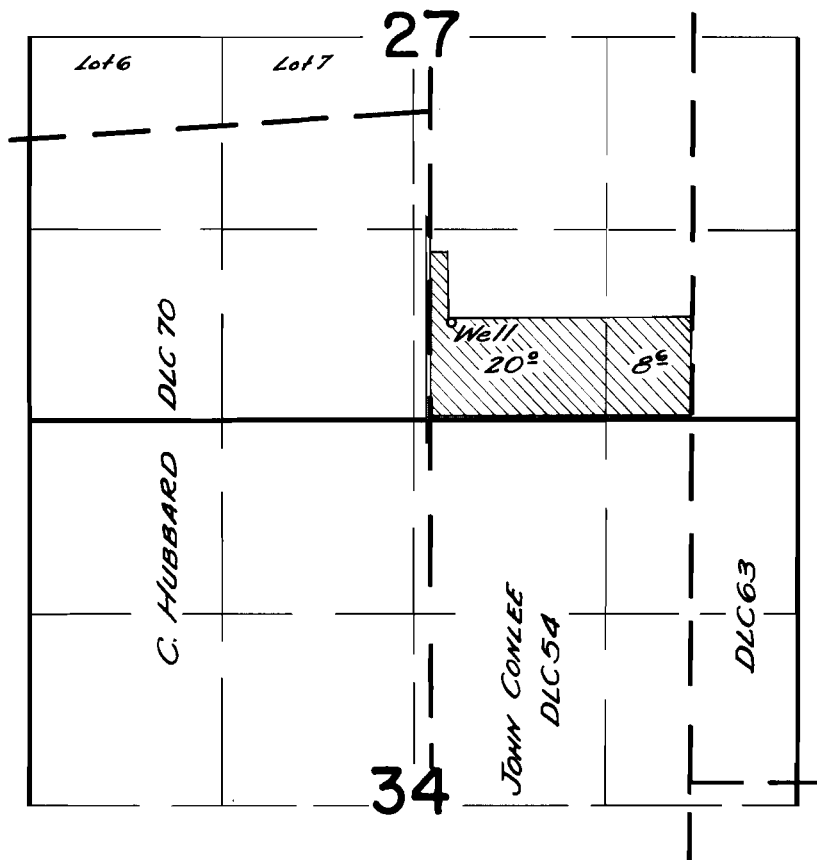

FINAL PROOF SURVEY
UNDER

Application No. G-1626 Permit No. G-1494
IN NAME OF

ALBERT DEMPSEY

Surveyed April 4 1961, by Colbastes