COBU MAP#1189 A.4

T 5 S R 11 W, WM

TILLAMOOK COUNTY

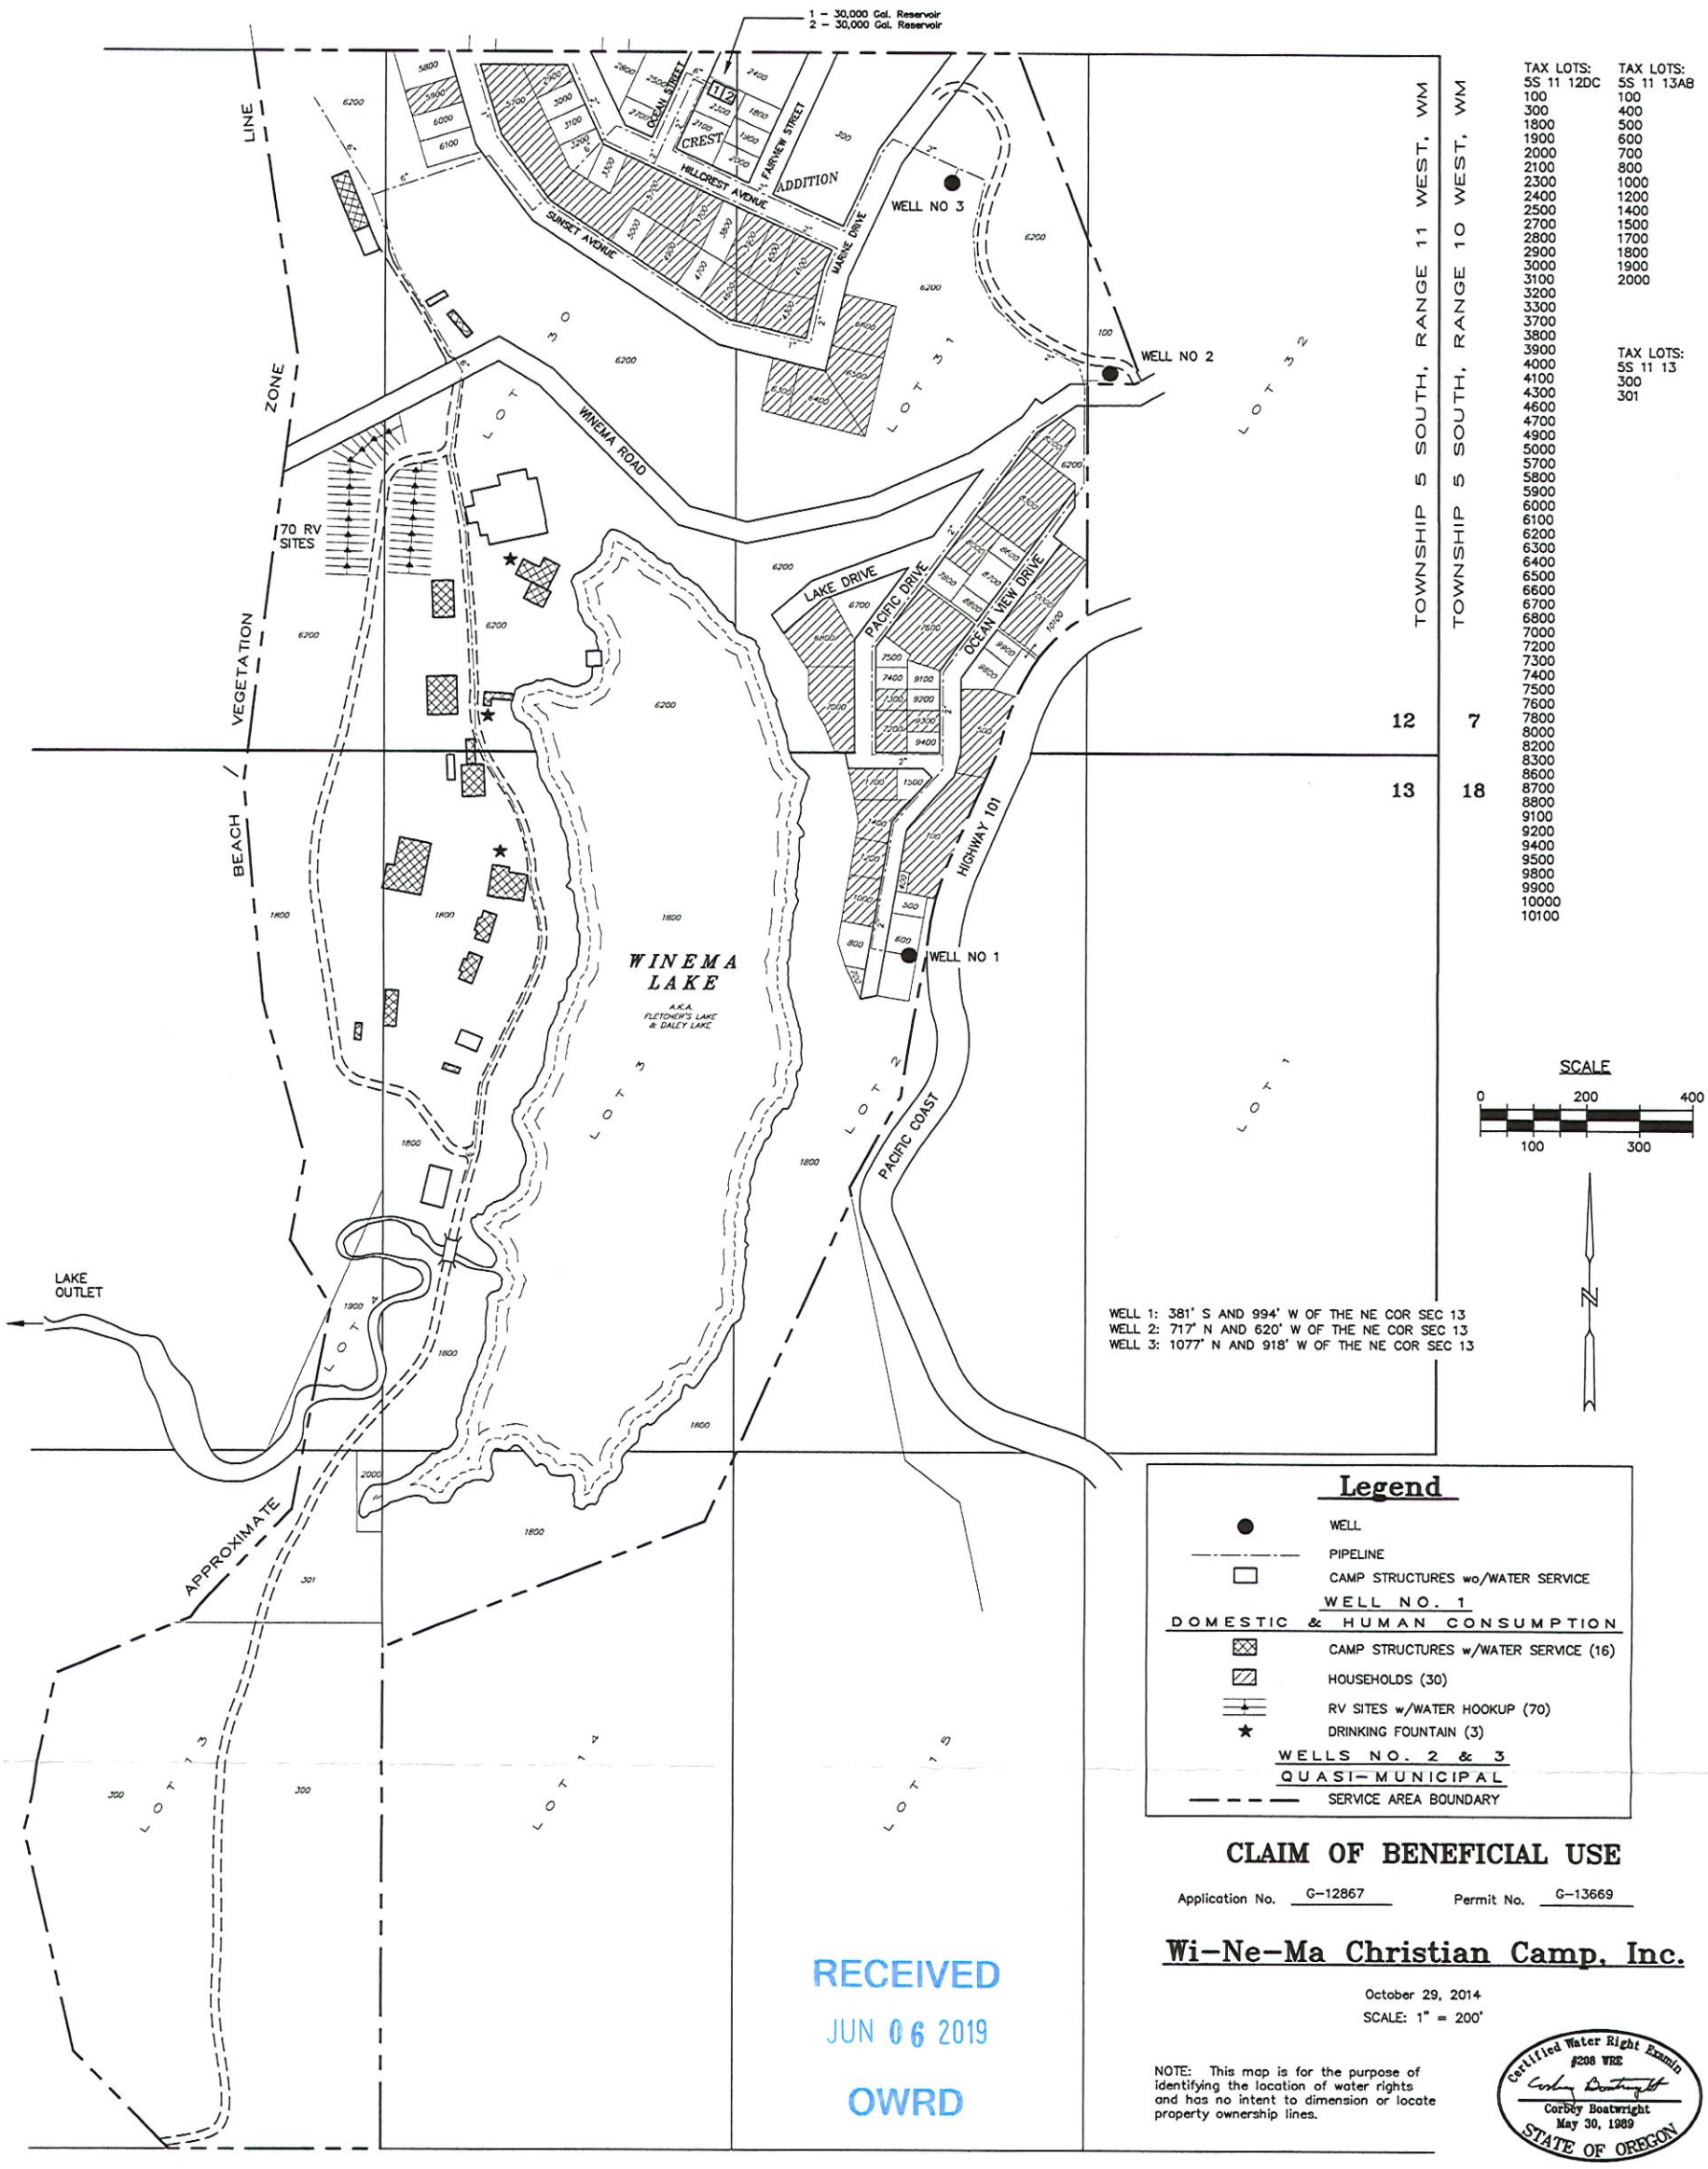

CLAIM OF BENEFICIAL USE

Application No. G-12867 Permit No. G-13669

Wi-Ne-Ma Christian Camp, Inc.

October 29, 2014

SCALE: 1" = 200'

NOTE: This map is for the purpose of identifying the location of water rights and has no intent to dimension or locate property ownership lines.

Certified Water Right Examiner #208 WRE
Corbey Boatwright
May 30, 1989
STATE OF OREGON

Renewal Date: December 31, 2019

RECEIVED
JUN 06 2019
OWRD