


THIS MAP IS NOT INTENDED TO PROVIDE LEGAL DIMENSIONS OR LOCATIONS OF PROPERTY OWNERSHIP LINES.

Claim Map for Permit G 15300, Application G 15218, Township 15S Range 5W Sections 4, 8, and 9
 Benton County Tax Lots 155080000100, 155090000500, 155090000800, 155090000700, and 155040000601

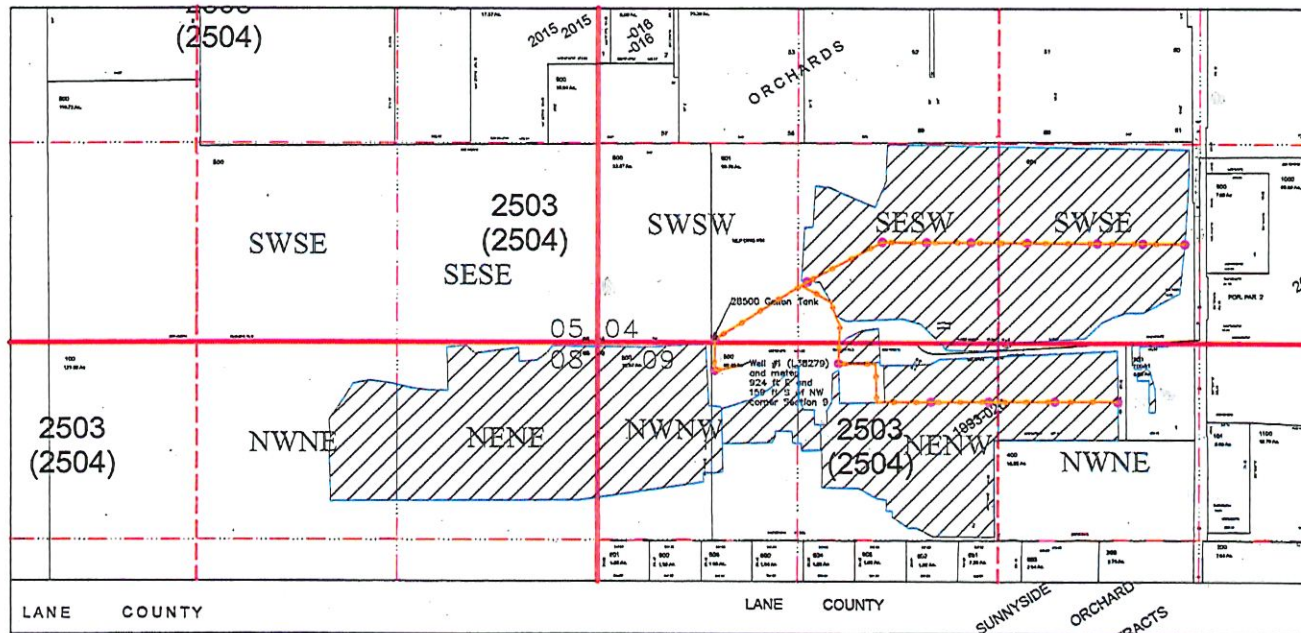

1/4/2019 3:18:53 PM

Benton County, Oregon - Assessor's Department
 Esri, HERE, Garmin, © OpenStreetMap contributors, and the GIS
 user community

Benton County, Oregon
 This product is for informational purposes
 and may not have been prepared for,
 or be suitable for legal, engineering, or surveying purposes.

Irrigated Areas

Irrigation
Risers/Valves

Buried
2"
Irrigation
Line



Tax Lot
Boundaries



Section
Lines



Quarter
Section
Lines



Quarter
Quarter
Lines

400 0 400 800




EXPIRATION DATE: 12/31/20

COBU MAP# 1171

1 of 2

RECEIVED
FEB 07 2019
OWB

THIS MAP IS NOT INTENDED TO PROVIDE LEGAL DIMENSIONS OR LOCATIONS OF PROPERTY OWNERSHIP LINES.
 Claim Map for Permit G 15300, Application G 15218, Township 15S Range 5W Sections 4, 8, and 9.
 Benton County Tax Lots 155080000100, 155090000500, 155090000800, 155090000700, and 155040000601

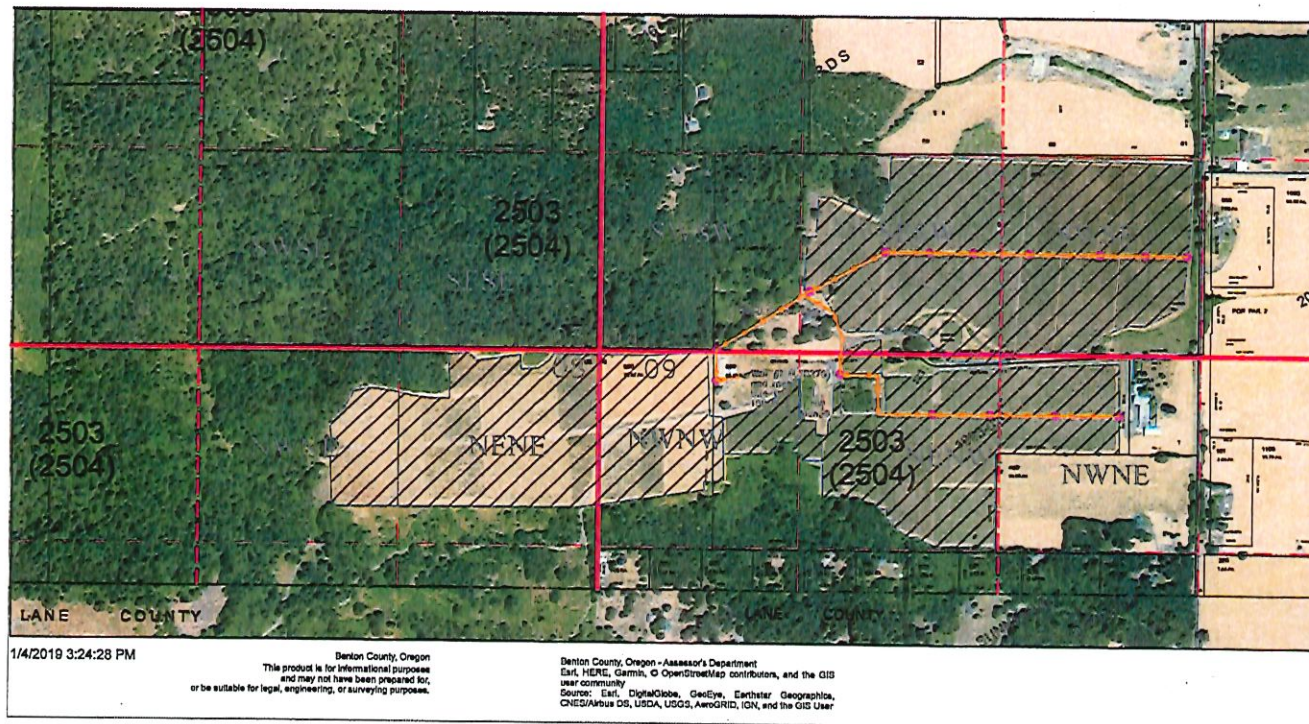

1/4/2019 3:24:28 PM

Benton County, Oregon
 This product is for informational purposes
 and may not have been prepared for,
 or be suitable for legal, engineering, or surveying purposes.

Benton County, Oregon - Assessor's Department
 Earl, HENL, Garmis, © OpenStreetMap contributors, and the GIS
 user community
 Sources: Esri, DigitalGlobe, GeoEye, Earthstar Geographics,
 CNES/Airbus DS, USDA, USGS, AeroGRID, IGN, and the GIS User




Irrigated
Areas

Irrigation
Risers/Valves

Buried
2"
Irrigation
Line



Tax Lot
Boundaries



Section
Lines



Quarter
Section
Lines



Quarter
Quarter
Lines



EXPIRATION DATE: 12/31/20

COBU MAP# 1171

2 of 2

RECEIVED
FEB 07 2019
OWRD