


Claim of Beneficial Use - Java Properties OR 4 LLC

Application G-18398, Permit G-18029

Township 19S, Range 2W, W.M.

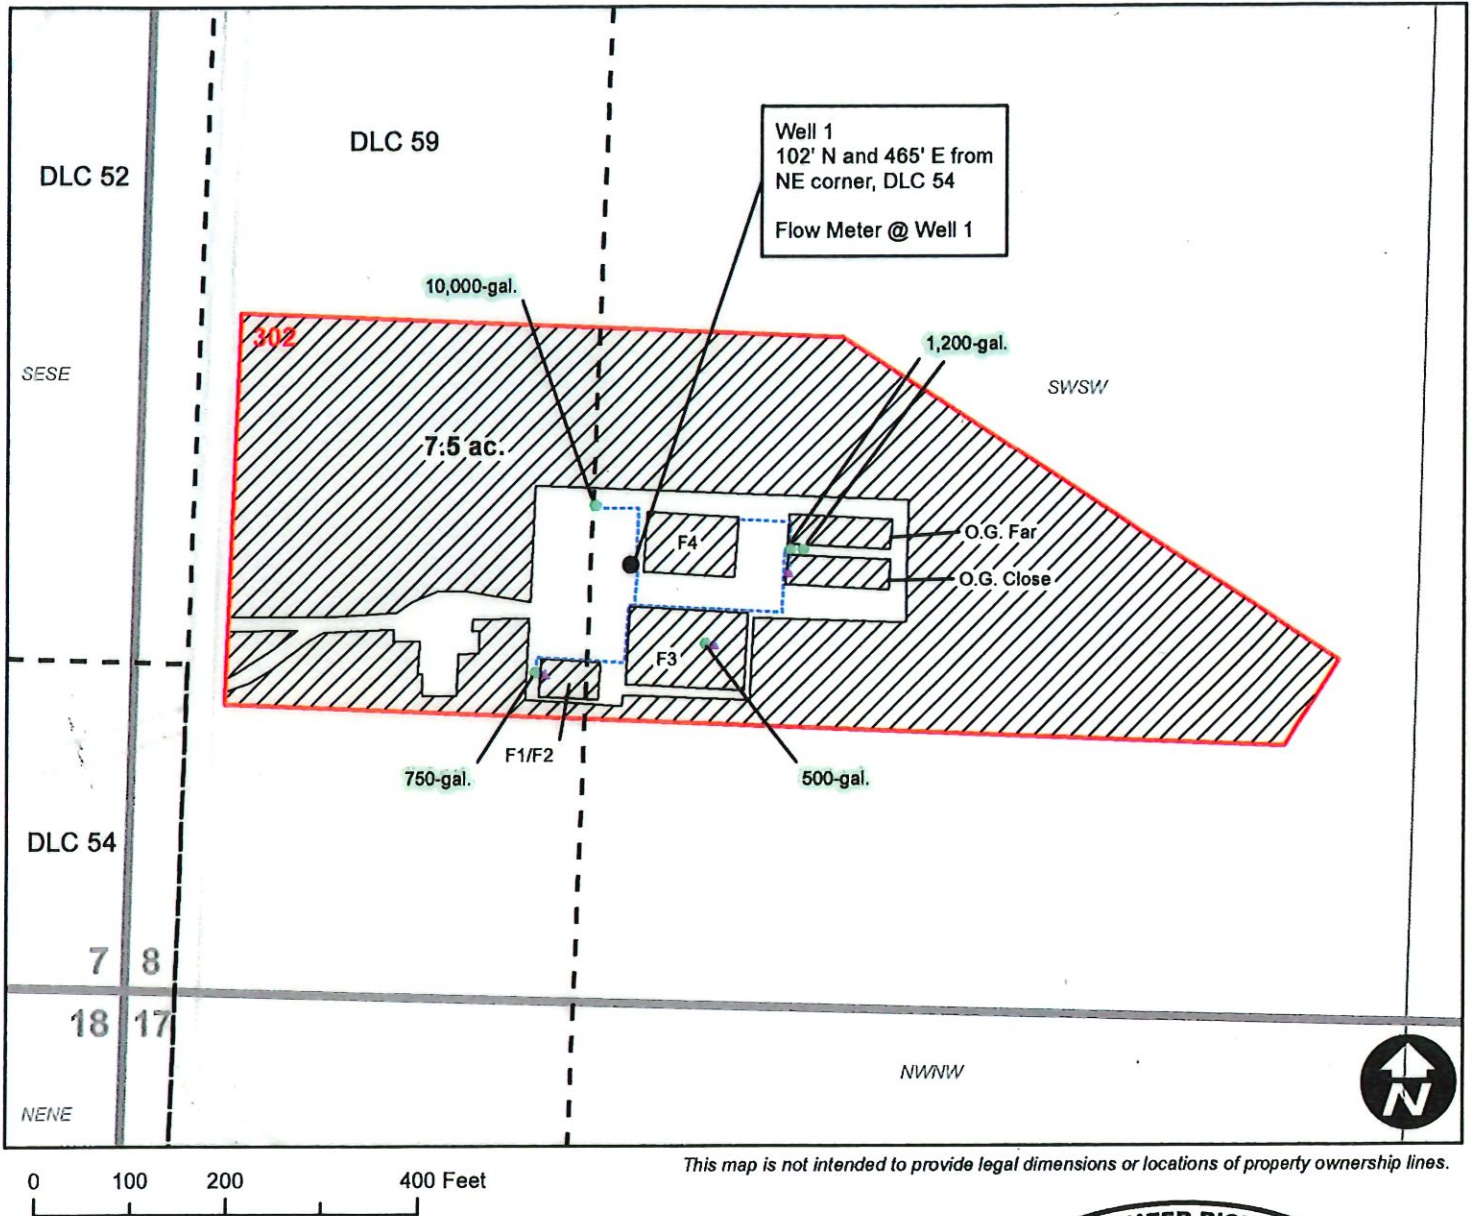

Legend

- Developed POU
- 1.5" PVC Mainline
- Storage Tanks
- Centrifugal Pumps
- Taxlot
- DLC

