



CLAIM OF BENEFICIAL USE MAP FOR A PORTION OF APPLICATION
S-87923, PERMIT S-54849, IN THE NAME OF
JOHN AND SANDRA STREDWICK
SEC 28 & 33, T4N, R37E, W.M., UMATILLA COUNTY

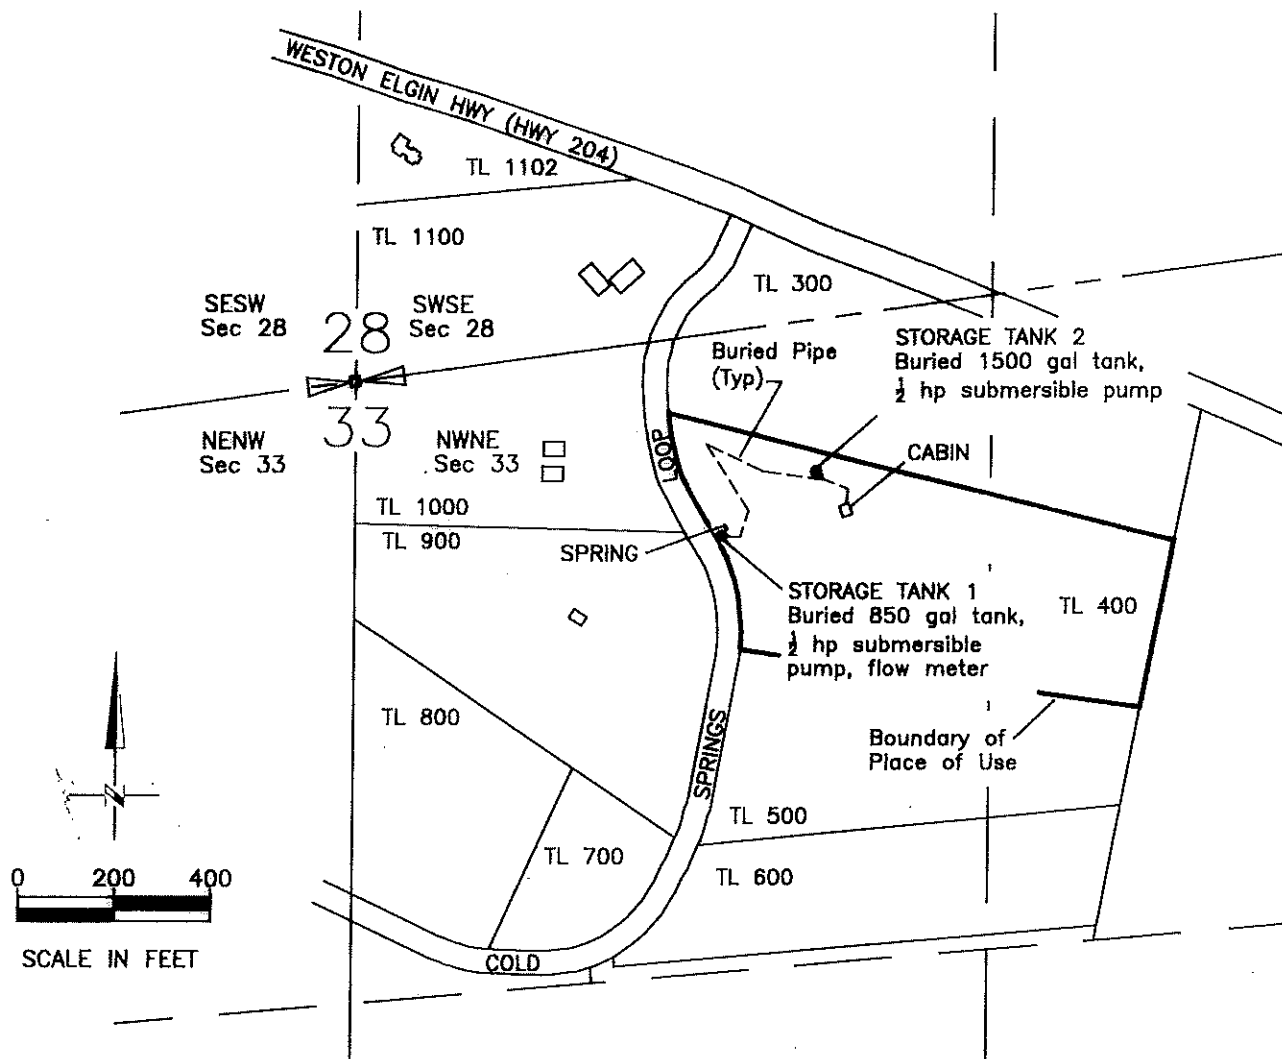

LEGEND & LOCATION OF STORAGE SITES (PODs)

- STORAGE TANK 1, 430'S & 750'E
FROM THE N1/4 COR OF SEC 33
- STORAGE TANK 2, 320'S & 960'E
FROM THE N1/4 COR OF SEC 33

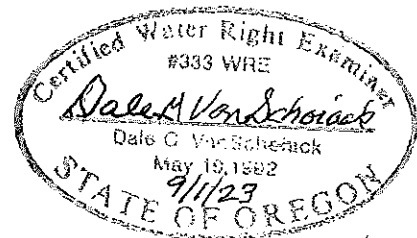


Renews 6/30/24

SEP 16 2023

NOTE:
THE PURPOSE OF THIS MAP IS TO IDENTIFY THE APPROXIMATE LOCATION OF THE WATER RIGHT. IT IS NOT INTENDED TO PROVIDE INFORMATION RELATIVE TO THE LOCATION OF PROPERTY OWNERSHIP BOUNDARY LINES. PIPELINE SIZES AND LOCATIONS WERE PROVIDED BY FARM PERSONNEL AND HAVE NOT BEEN VERIFIED.

DGV Consulting, PLLC
PHONE (509) 627-8717
dalevconsulting@gmail.com
Date: August 29, 2023


CLAIM OF BENEFICIAL USE MAP FOR A PORTION OF APPLICATION
R-87846, PERMIT R-15009, IN THE NAME OF
ALETHA GRUZENSKY, AARON LEEN, LENNY & KELLI LEEN,
AND DELMAR & THERESA GRIEBEL
SEC 28 & 33, T4N, R37E, W.M., UMATILLA COUNTY

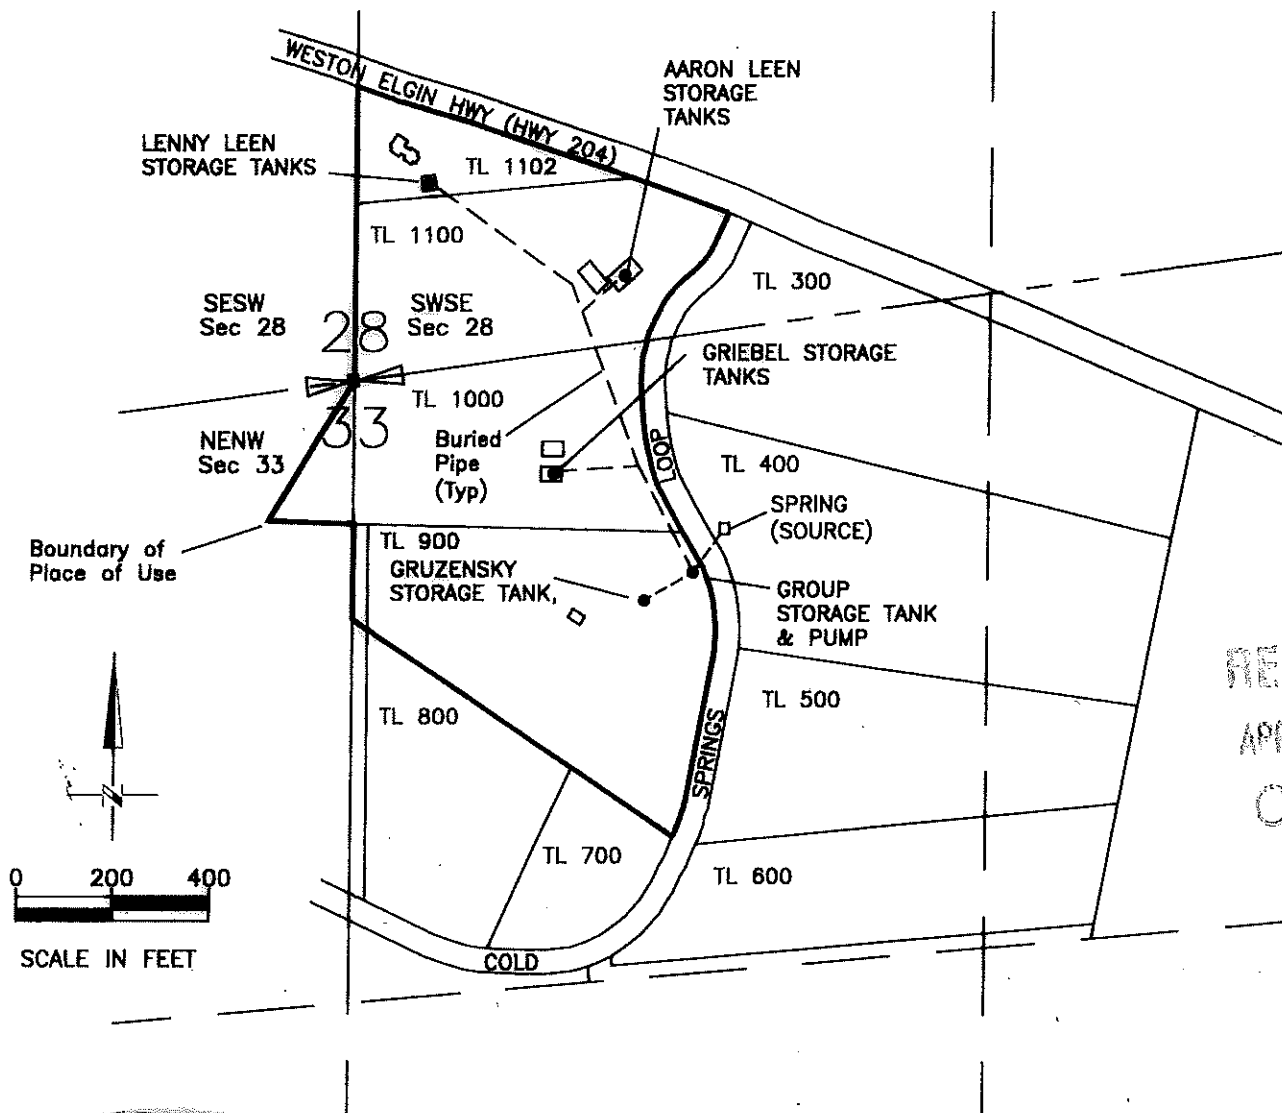

RECEIVED
APR 03 2023
OWRD

LEGEND & LOCATION OF SOURCE AND STORAGE SITES

- SPRING (SOURCE), 420'S & 760'E FROM THE N1/4 COR OF SEC 33
- AARON LEEN STORAGE TANK, 140'N & 560'E FROM THE S1/4 COR OF SEC 28
- GROUP STORAGE TANK, 470'S & 730'E FROM THE N1/4 COR OF SEC 33
- LENNY LEEN STORAGE TANK, 370'N & 140'E FROM THE S1/4 COR OF SEC 28
- GRUZENSKY STORAGE TANK, 530'S & 640'E FROM THE N1/4 COR OF SEC 33
- GRIEBEL STORAGE TANK, 240'S & 430'E FROM THE N1/4 COR OF SEC 33

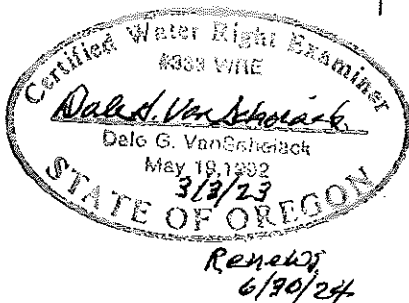

NOTE:
THE PURPOSE OF THIS MAP IS TO IDENTIFY THE APPROXIMATE LOCATION OF THE WATER RIGHT. IT IS NOT INTENDED TO PROVIDE INFORMATION RELATIVE TO THE LOCATION OF PROPERTY OWNERSHIP BOUNDARY LINES. PIPELINE SIZES AND LOCATIONS WERE PROVIDED BY FARM PERSONNEL AND HAVE NOT BEEN VERIFIED.

DGV Consulting, PLLC
PHONE (509) 627-8717
dalevconsulting@gmail.com
Date: Jan 5, 2023