


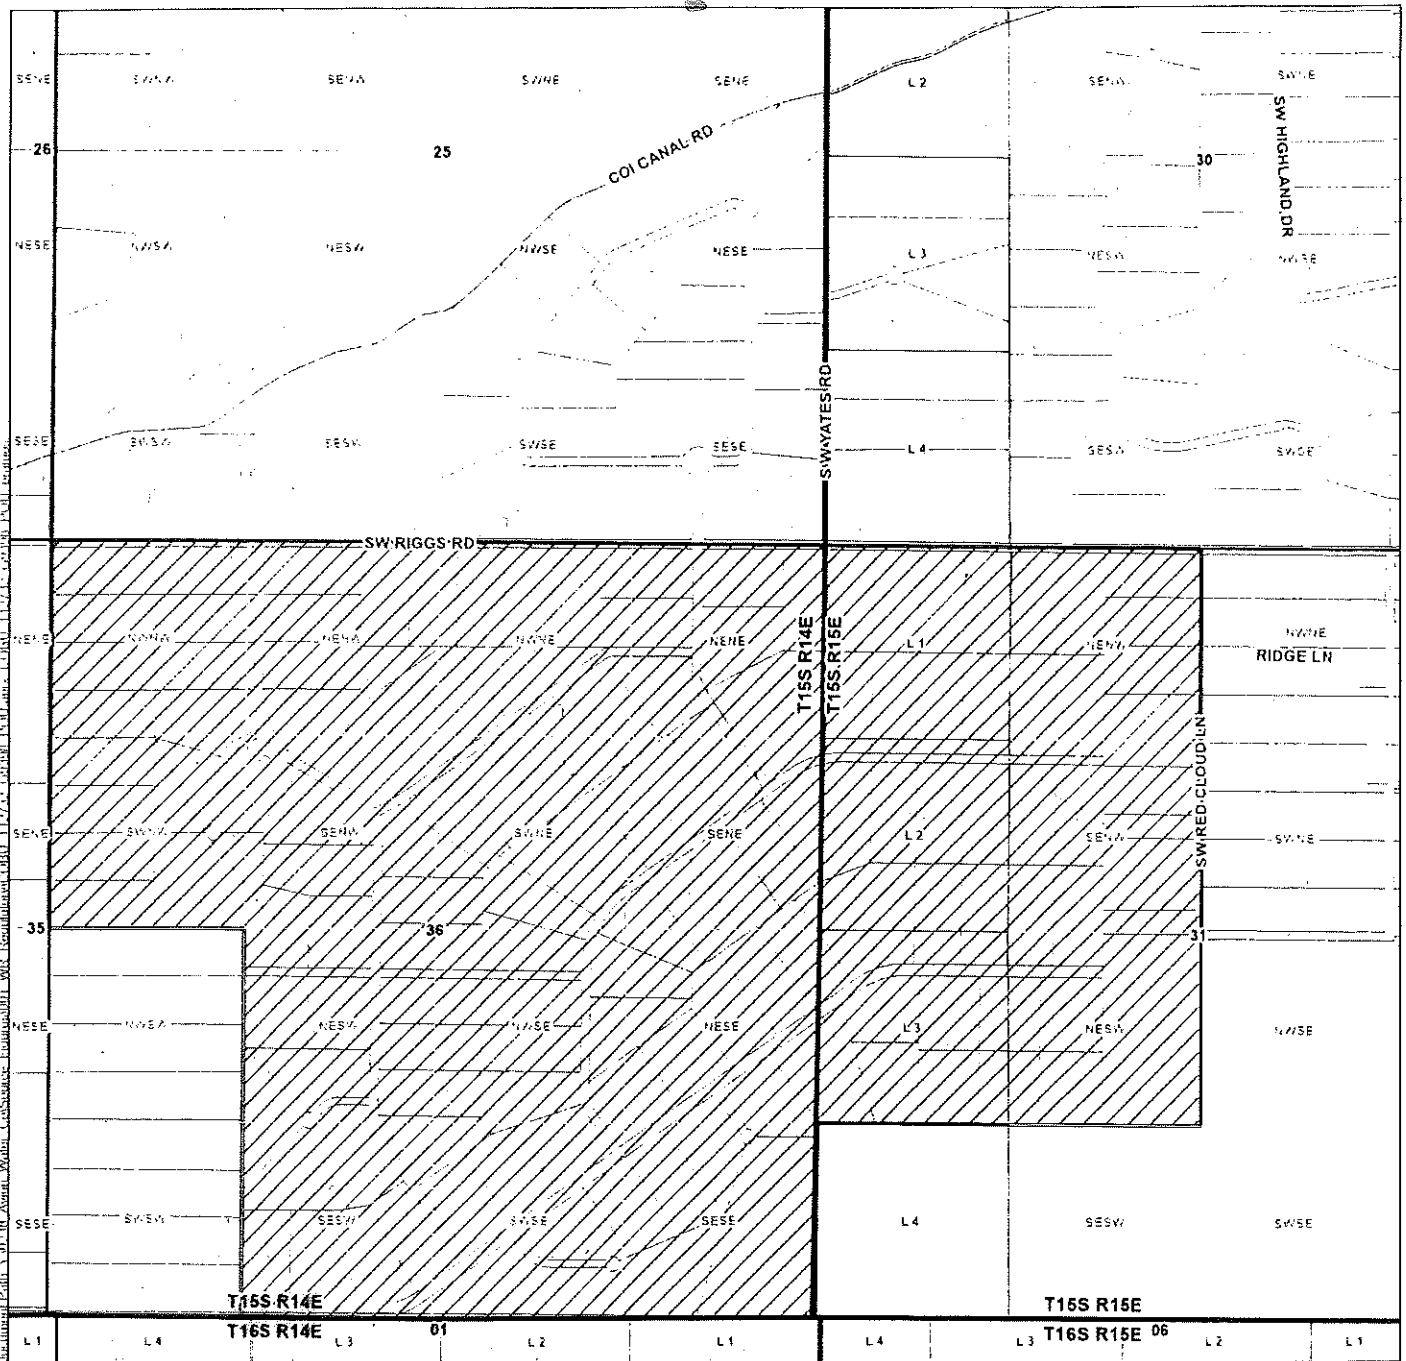

LEGEND


-  Permit G-9398 POU
-  Tax Lot
-  Government Lot (GL)
-  Watercourse

Claim of Beneficial Use
Avion Water Co. Inc.
Place of Use

Transfer T-12732, Permit G-9398

Township 15 South, Range 14/15 East (W.M.)

CERTIFIED WATER RIGHTS EXAMINER STAMP

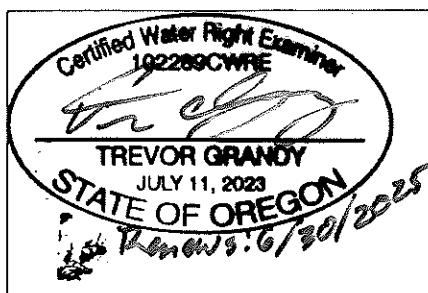

Received

OCT 07 2024

OWRD

DISCLAIMER
 This map was prepared for the purpose of identifying the location of a water right only and it is not intended to provide legal dimensions or location of property ownership lines.

Date: September 24, 2024
 Data Sources: BLM, ESRI, OWRD, USGS

