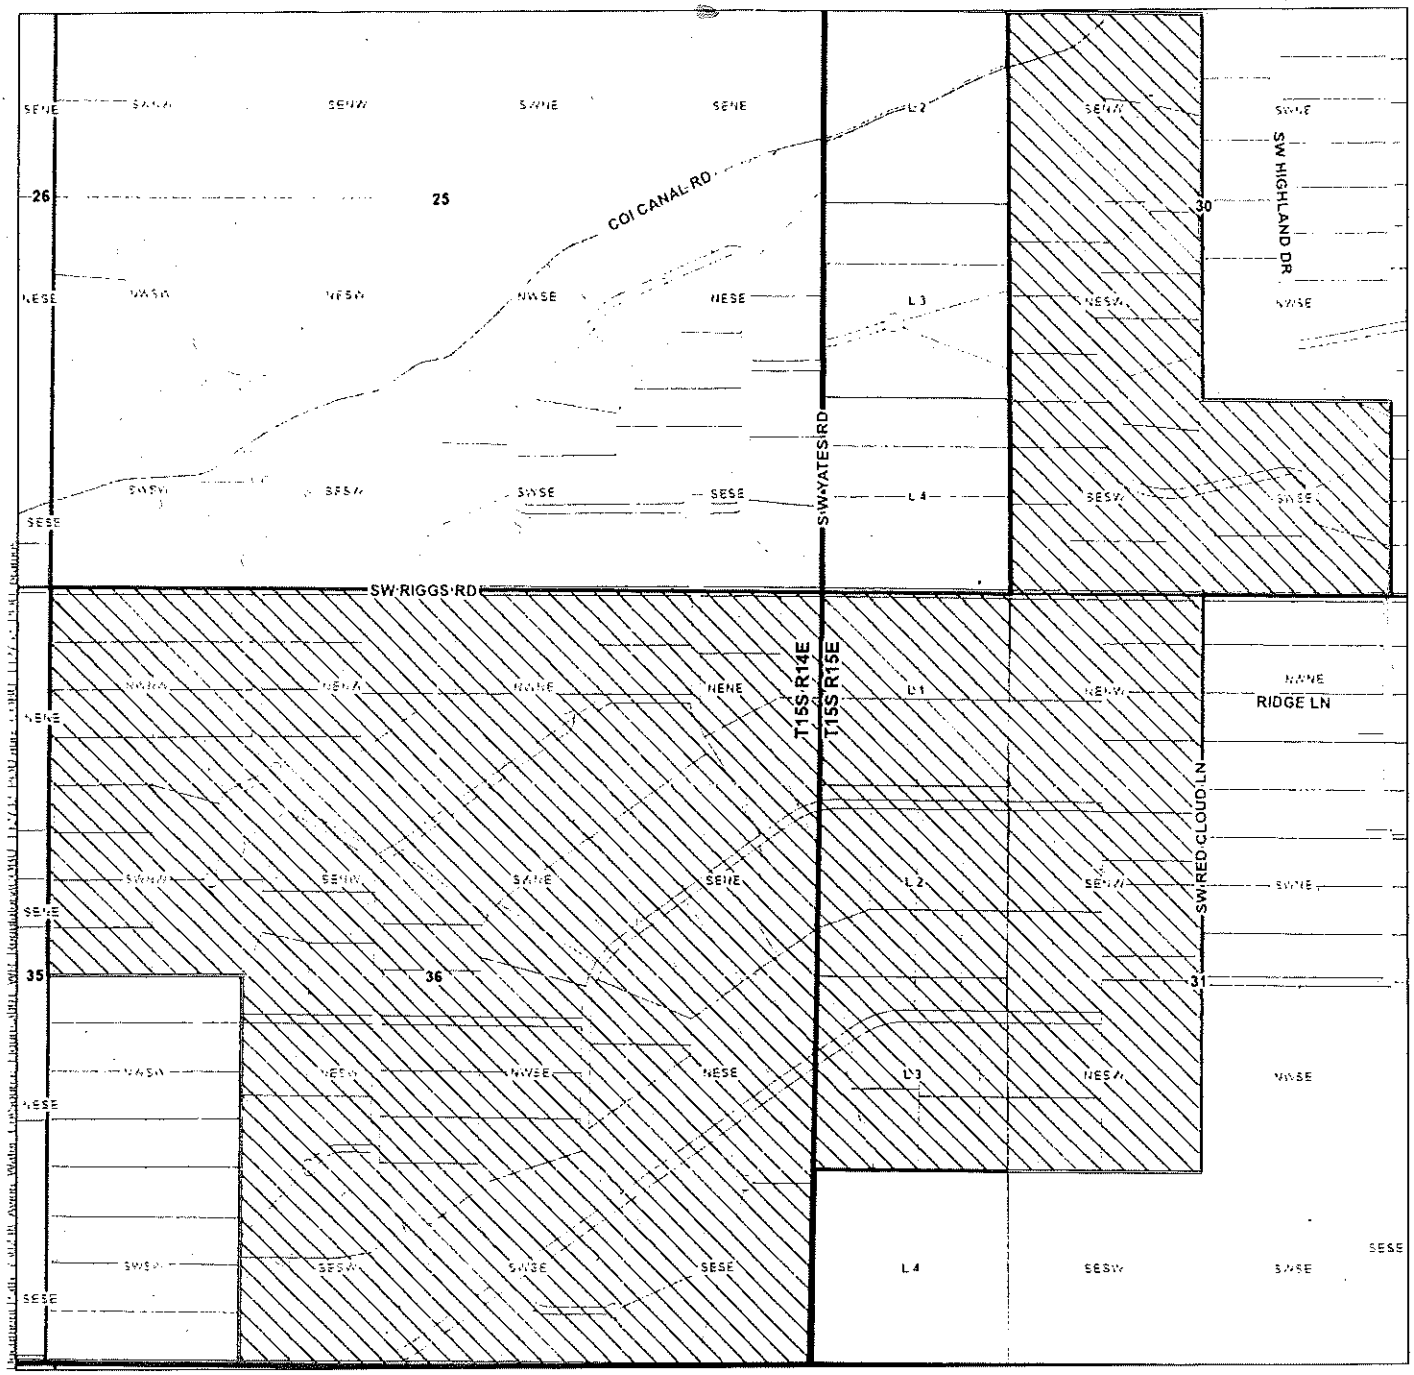

LEGEND

- Permit G-12936 POU
- Tax Lot
- Government Lot (GL)
- Watercourse

Claim of Beneficial Use
Avion Water Co. Inc.
Place of Use

Transfer T-12732, Permit G-12936

Township 15 South, Range 14/15 East (W.M.)

CERTIFIED WATER RIGHTS EXAMINER STAMP

Certified Water Right Examiner
102289CWRE
TREVOR GRANDY
JULY 11, 2023
STATE OF OREGON
Renews: 6/30/2025

Received
OCT 07 2024
OWRD

DISCLAIMER
This map was prepared for the purpose of identifying the location of a water right only and it is not intended to provide legal dimensions or location of property ownership lines.

Date: September 24, 2024
Data Sources: BLM, ESRI, OWRD, USGS

N
0 660 1,320
1 INCH = 1,320 FEET

GSI Water Solutions, Inc.

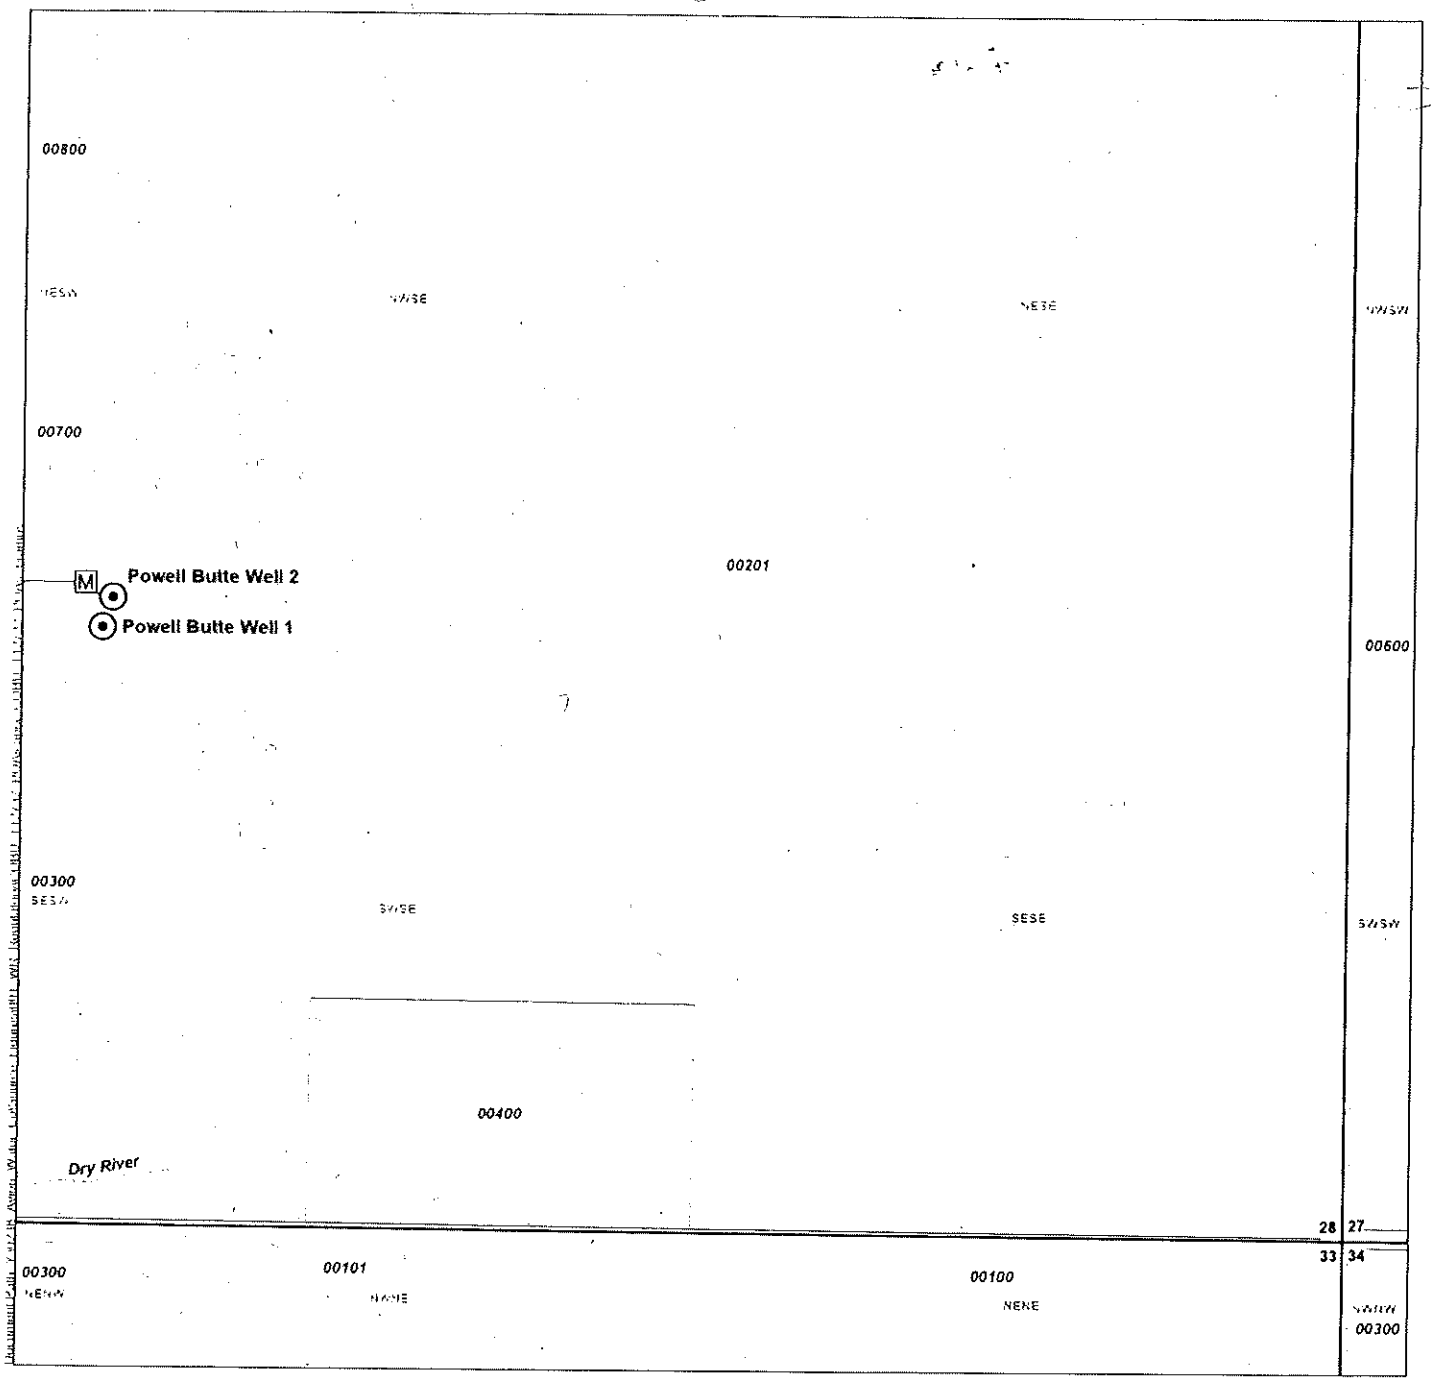

LEGEND

- Point of Appropriation (POA)
- Flow Meter
- Tax Lot
- Watercourse

Claim of Beneficial Use
Avion Water Co. Inc.
Points of Appropriation Map

Transfer T-12732, Permit G-9398 and G-12936

Township 15 South, Range 14 East (W.M.)

CERTIFIED WATER RIGHTS EXAMINER STAMP

Certified Water Right Examiner
102269CWRE
TREVOR GRANDY
JULY 11, 2023
STATE OF OREGON
Renews 6/30/2025

Received
OCT 07 2024
OWRD

LOCATION DESCRIPTION

Powell Butte Well 1
SW ¼, SE ¼ of Section 28, T 15 S, R 14 E, WM 88.95 Feet South and 38.27 Feet East from the NW corner of the SW ¼ of the SE ¼ of Section 28

Powell Butte Well 2
SW ¼, SE ¼ of Section 28, T 15 S, R 14 E, WM 23.33 Feet South and 62.6 Feet East from the NW corner of the SW ¼ of the SE ¼ of Section 28

DISCLAIMER
This map was prepared for the purpose of identifying the location of a water right only and it is not intended to provide legal dimensions or location of property ownership lines.

Date: September 26, 2024
Data Sources: BLM, ESRI, OWRD, USGS

N
0 200 400
1 INCH = 400 FEET

GSI Water Solutions, Inc.