


T.26S. R.14&15E. W.M.

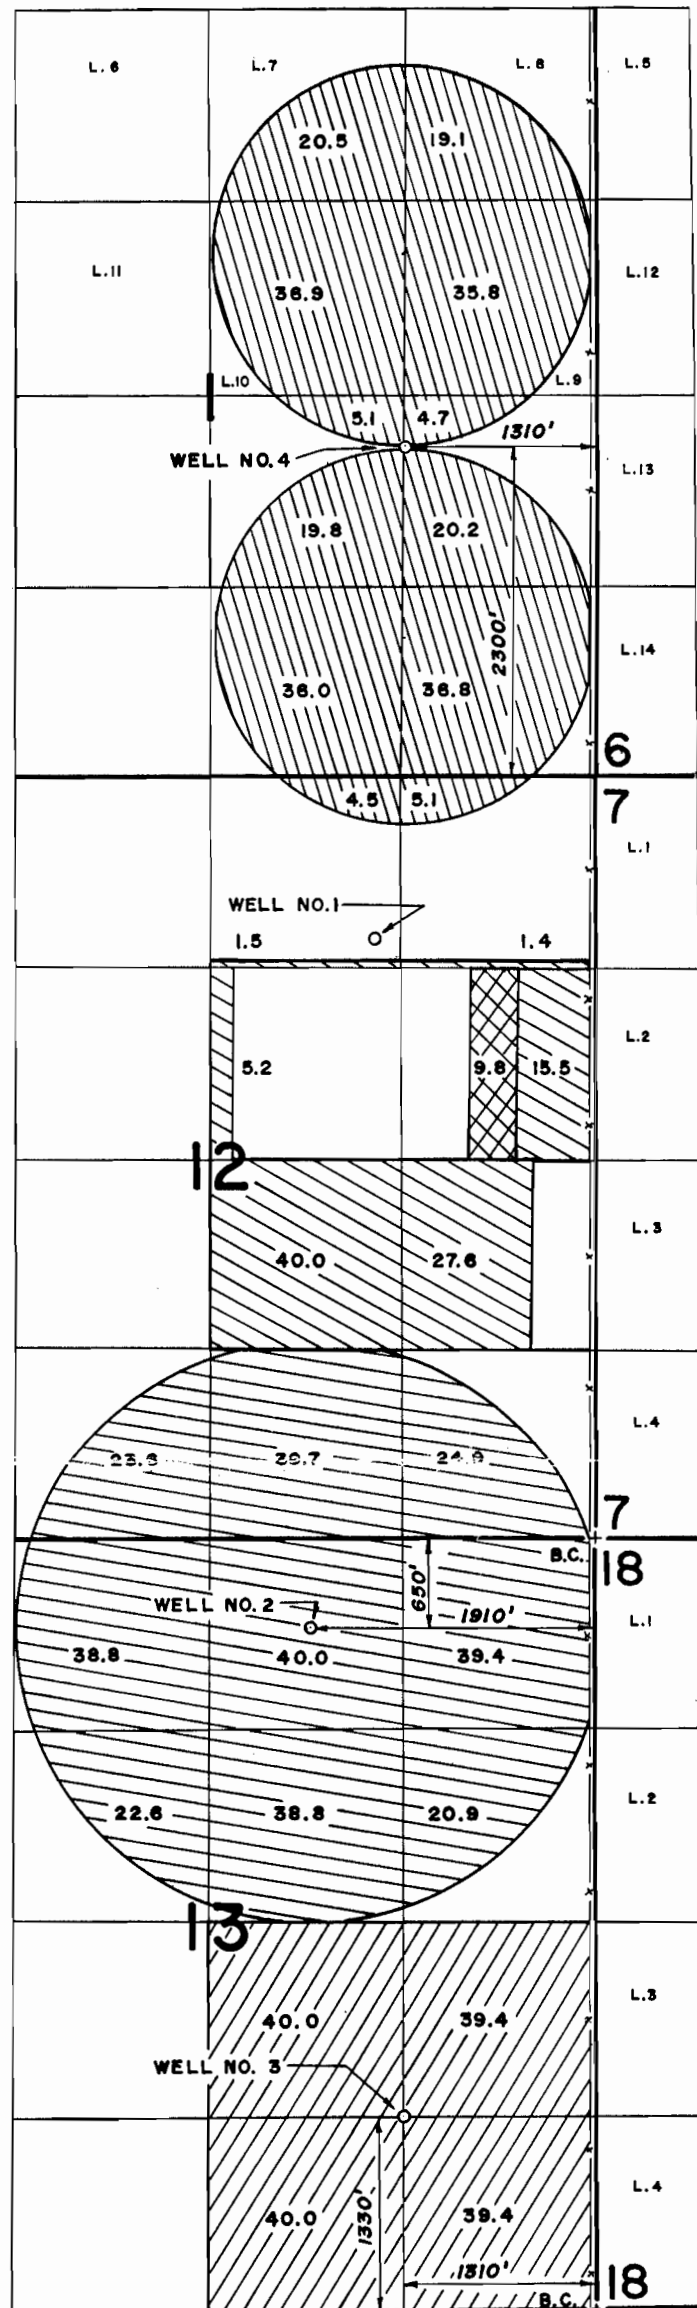

WELL NO. 1 IS LOCATED 17.1 CH. S. AND 22.8 CH. W. FROM THE N.E. COR. OF SECTION 12.

FINAL PROOF SURVEY UNDER

TRANSFER NO. 3510
AND
APPLICATION NO. G-7651 PERMIT NO. G-7361

IN NAME OF
KENNETH V. KRUSE & KATHLEEN G. KRUSE
SURVEYED OCT. 14, 1984 BY P. R. PAGTER

PERMIT G-7361



- WELL NO. 1
- WELL NO. 2
- WELL NO. 3
- WELL NO. 4

TRANSFER 3510



SCALE: 4" = 1 MILE

**T26S R14E, WM,
LAKE COUNTY, OR**

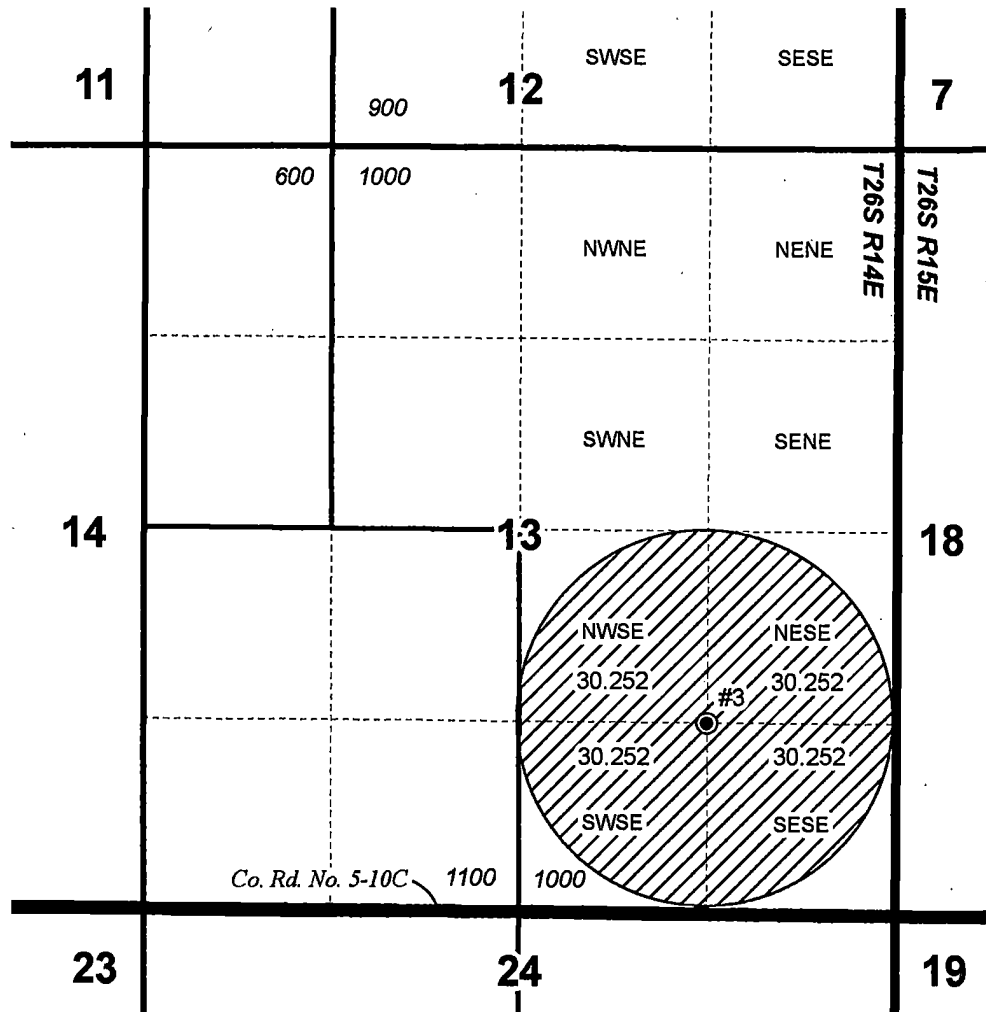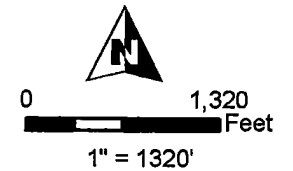

- Well
- Pipeline
- Township
- Section
- Quarter Quarter
- POU IR "OFF" C-80626 4/29/1977 Priority

Well #3 (LAKE 341) Location:
1330' N, 1310' W of SE Cor Sec 13

RECEIVED
NOV 15 2023

OWRD



RENEWAL DATE 12/31/2024

**PERMANENT TRANSFER "OFF" MAP
KRUSE RANCH**

Date: 10/23/2023

C-80626 4/29/1977 Priority

This map is not intended
to provide legal dimensions
or locations of property
ownership lines.

WATER RIGHT SERVICES, LLC

PO BOX 1830, BEND, OR 97709



WWW.OREGONWATER.US 541-389-2837

johnshort@usa.com

CCB # 197121

14353 -

T26S R14E, WM, LAKE COUNTY, OR

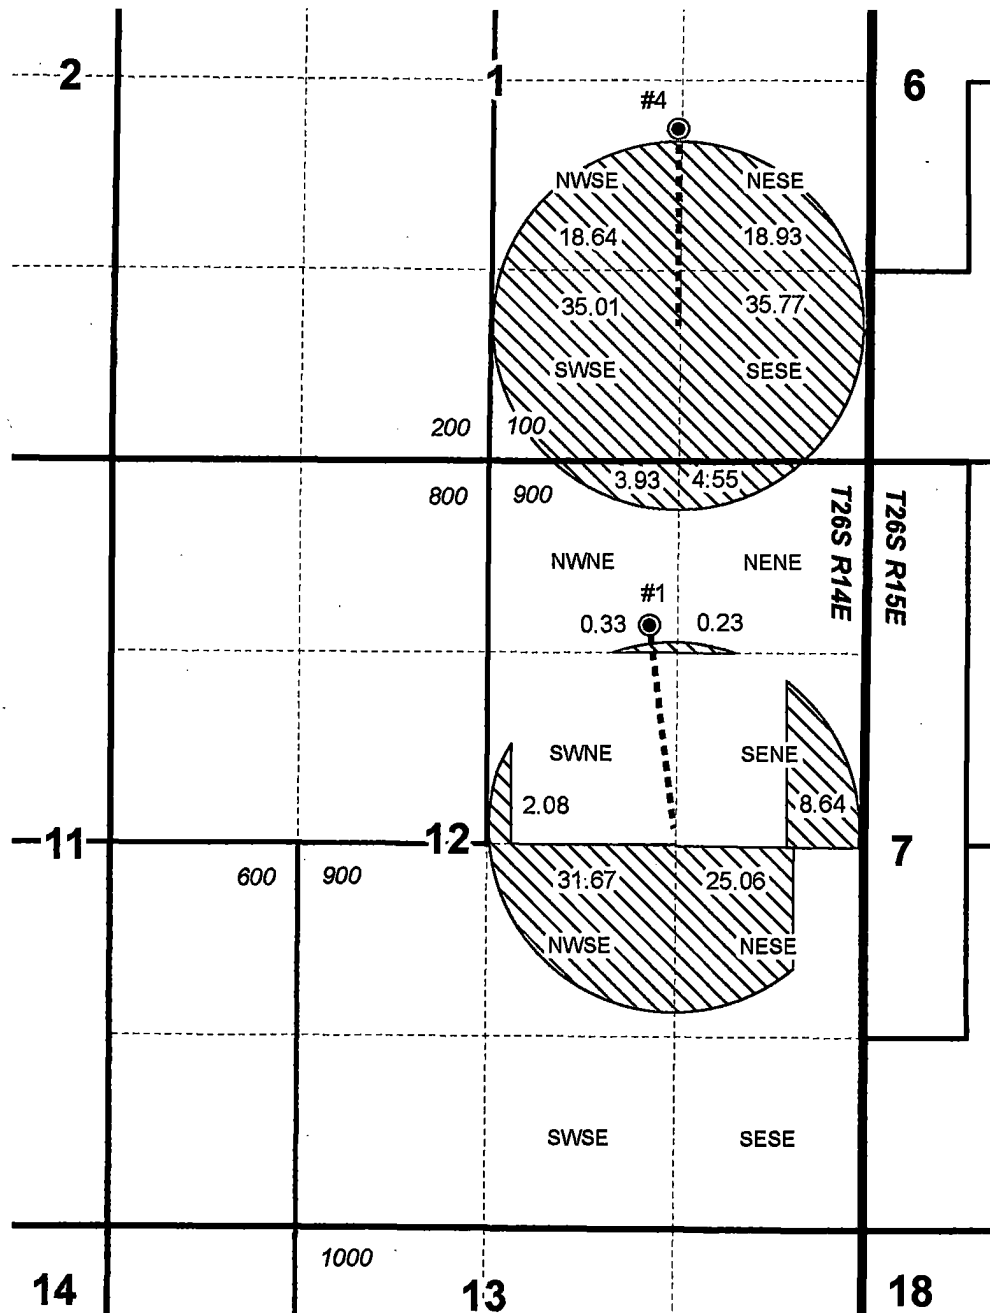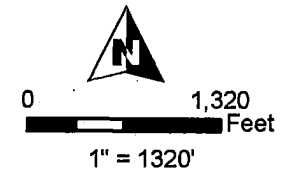

- Well
- Pipeline
- Township
- Section
- Quarter Quarter
- POU IR "NO CHANGE" C-80626 4/29/1977 Priority

Well #1 (LAKE 340) Location:
17.1 CH. S, 22.8 CH. W of NE Cor Sec 12

Well #4 (LAKE 309/310) Location:
2300' N, 1310' W of SE Cor Sec 1

RECEIVED
NOV 15 2023
OWRD



RENEWAL DATE 12/31/2024

PERMANENT TRANSFER "REMAINING RIGHT" MAP KRUSE RANCH

Date: 10/23/2023

C-80626 4/29/1977 Priority

This map is not intended
to provide legal dimensions
or locations of property
ownership lines.

WATER RIGHT SERVICES, LLC



PO BOX 1830, BEND, OR 97709

WWW.OREGONWATER.US 541-389-2837

johnshort@usa.com

CCB # 197121

**T25S R14E, WM,
LAKE COUNTY, OR**

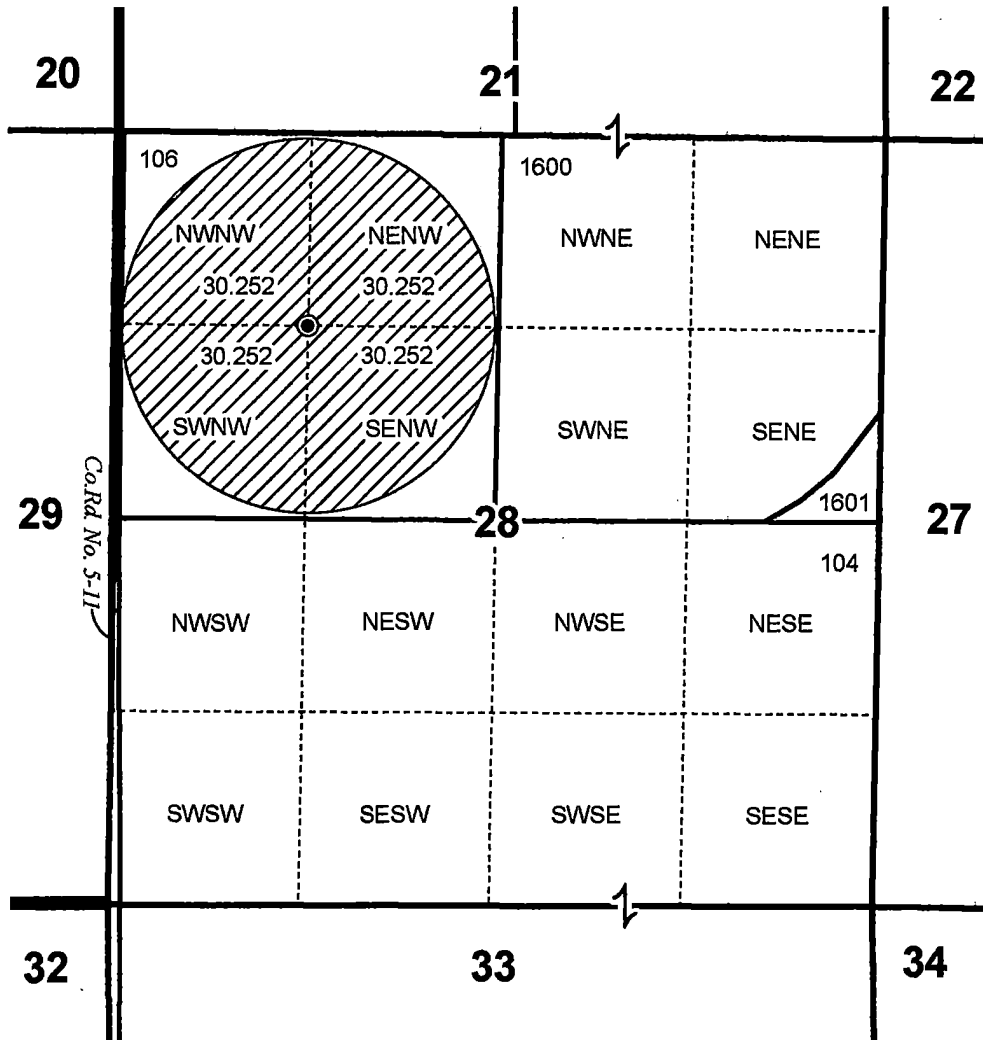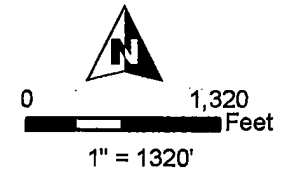

- Well "ON"
- POU IR "ON" C-80626 4/29/1977 Priority
- Section
- Quarter Quarter
- Tax Lot

Well "ON" (Proposed) Location:
1350' S, 1290' E of NW Cor Sec 28

RECEIVED
NOV 15 2023
OWRD



RENEWAL DATE 12/31/2024

**PERMANENT TRANSFER "ON" MAP
KRUSE RANCH**

Date: 10/23/2023

C-80626 4/29/1977 Priority

This map is not intended
to provide legal dimensions
or locations of property
ownership lines.

WATER RIGHT SERVICES, LLC

PO BOX 1830, BEND, OR 97709

WWW.OREGONWATER.US 541-389-2837

johnshort@usa.com

CCB # 197121