


Transfer Application - Latimer Certificate 86446

Township 12S, Range 4W, Section 8, W.M.

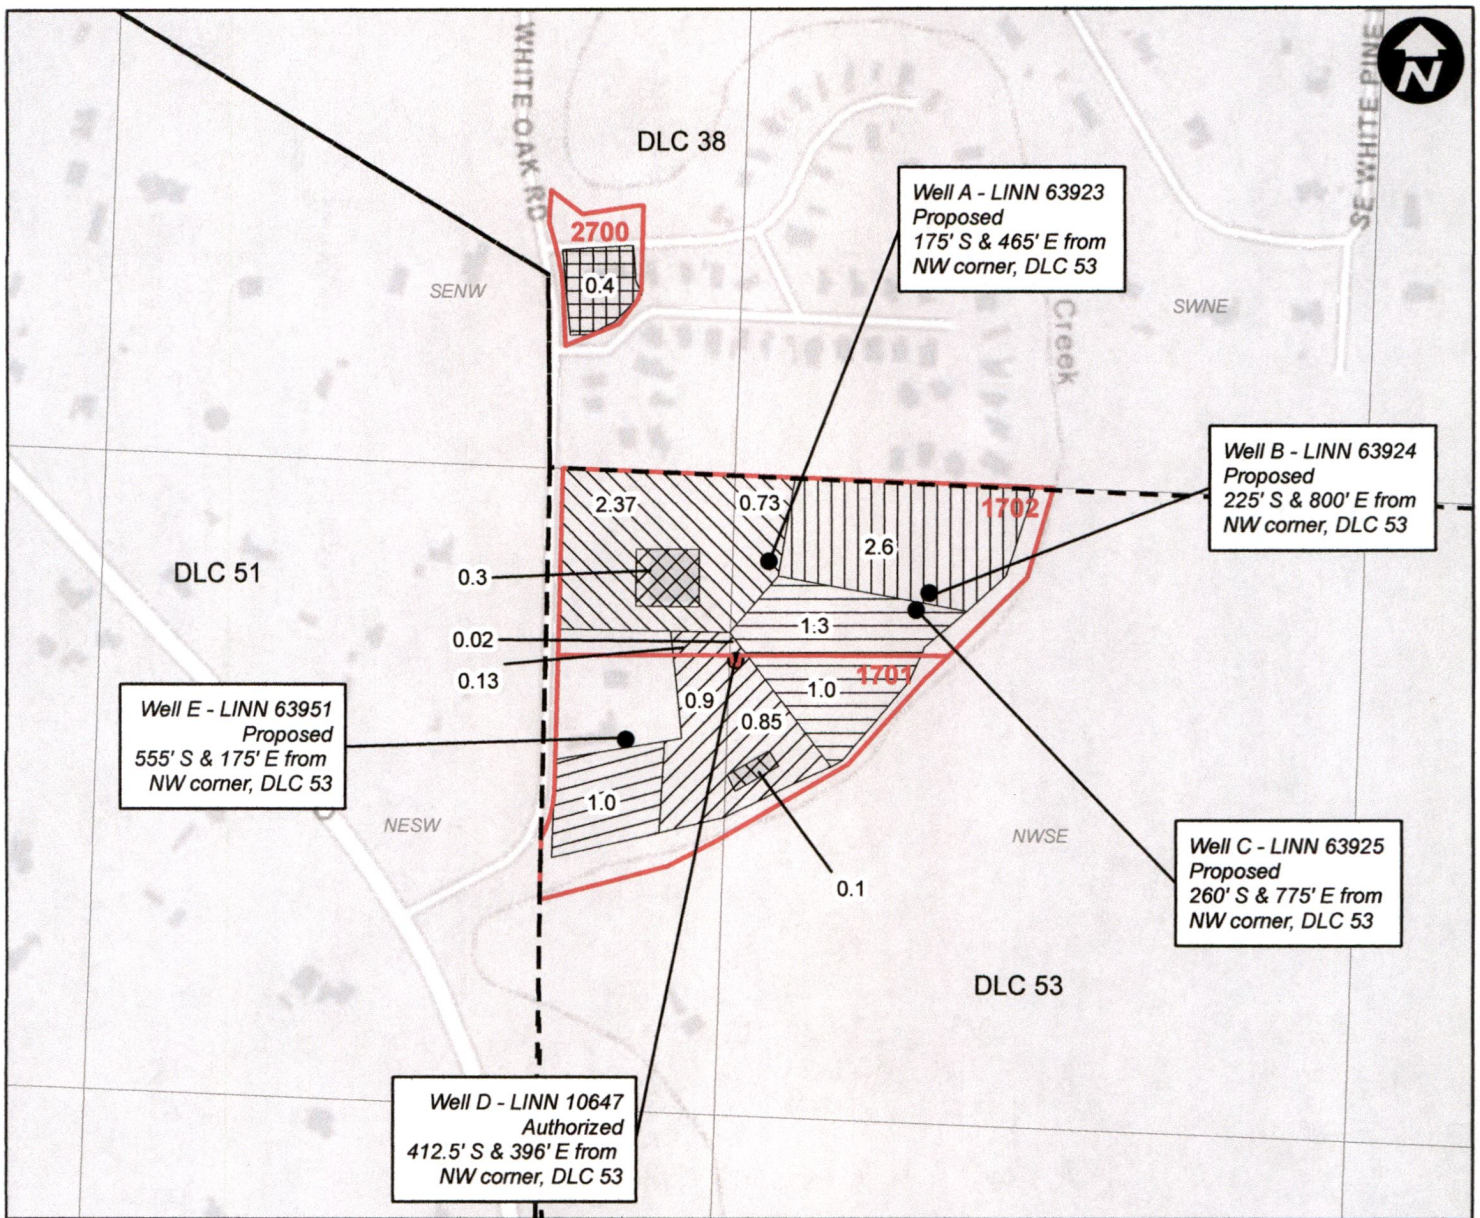

Legend

- | | | | |
|--|-------------|--|----------------------|
| | Lot A - POU | | No Change |
| | Lot B - POU | | Pending Cancellation |
| | Lot C - POU | | Taxlot |
| | Lot D - POU | | DLC |
| | Lot E - POU | | |

0 200 400 800 Feet




EXPIRES: 12-31-2022

RECEIVED
NOV 07 2022
OWRD

14118

T.12S.R.4W.W.M.

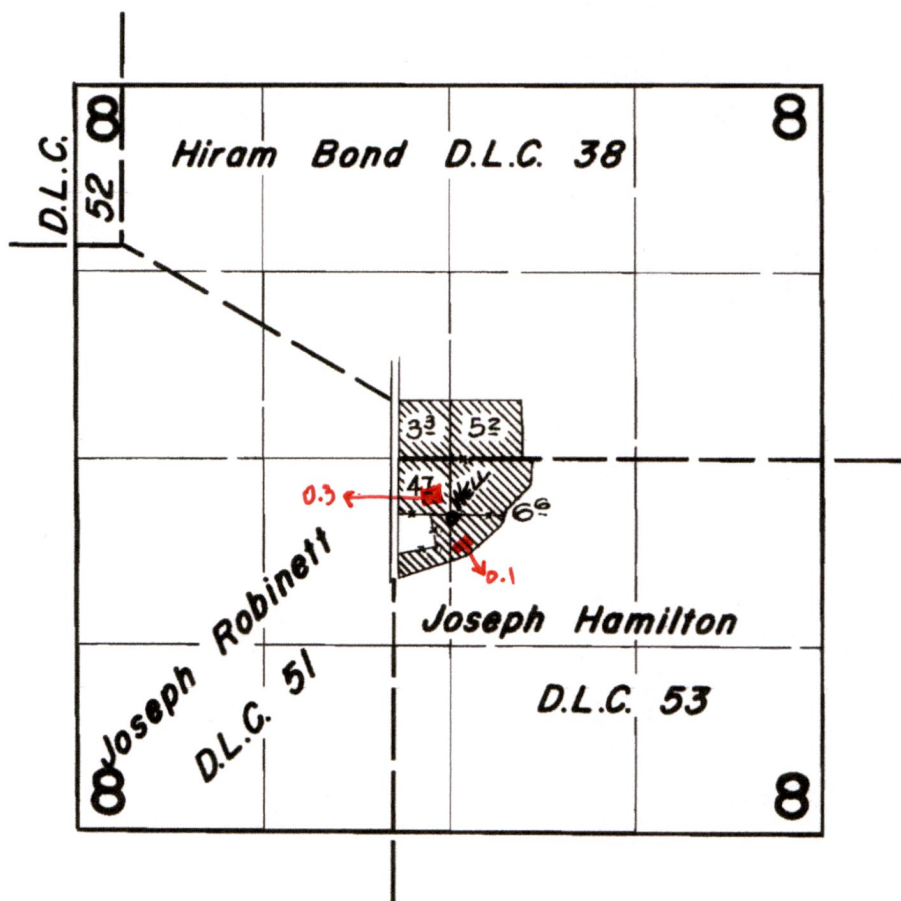

FINAL PROOF SURVEY
UNDER

Application No. G-1715... Permit No. G-1573...
IN NAME OF

R. G. GATES

Surveyed July 1, 1963, by C. Baker

RECEIVED
NOV 07 2022
OWRD

14118

1963-11

RT