


T.3S. R.1E. Sect. 29, 30, & 31, W.M.

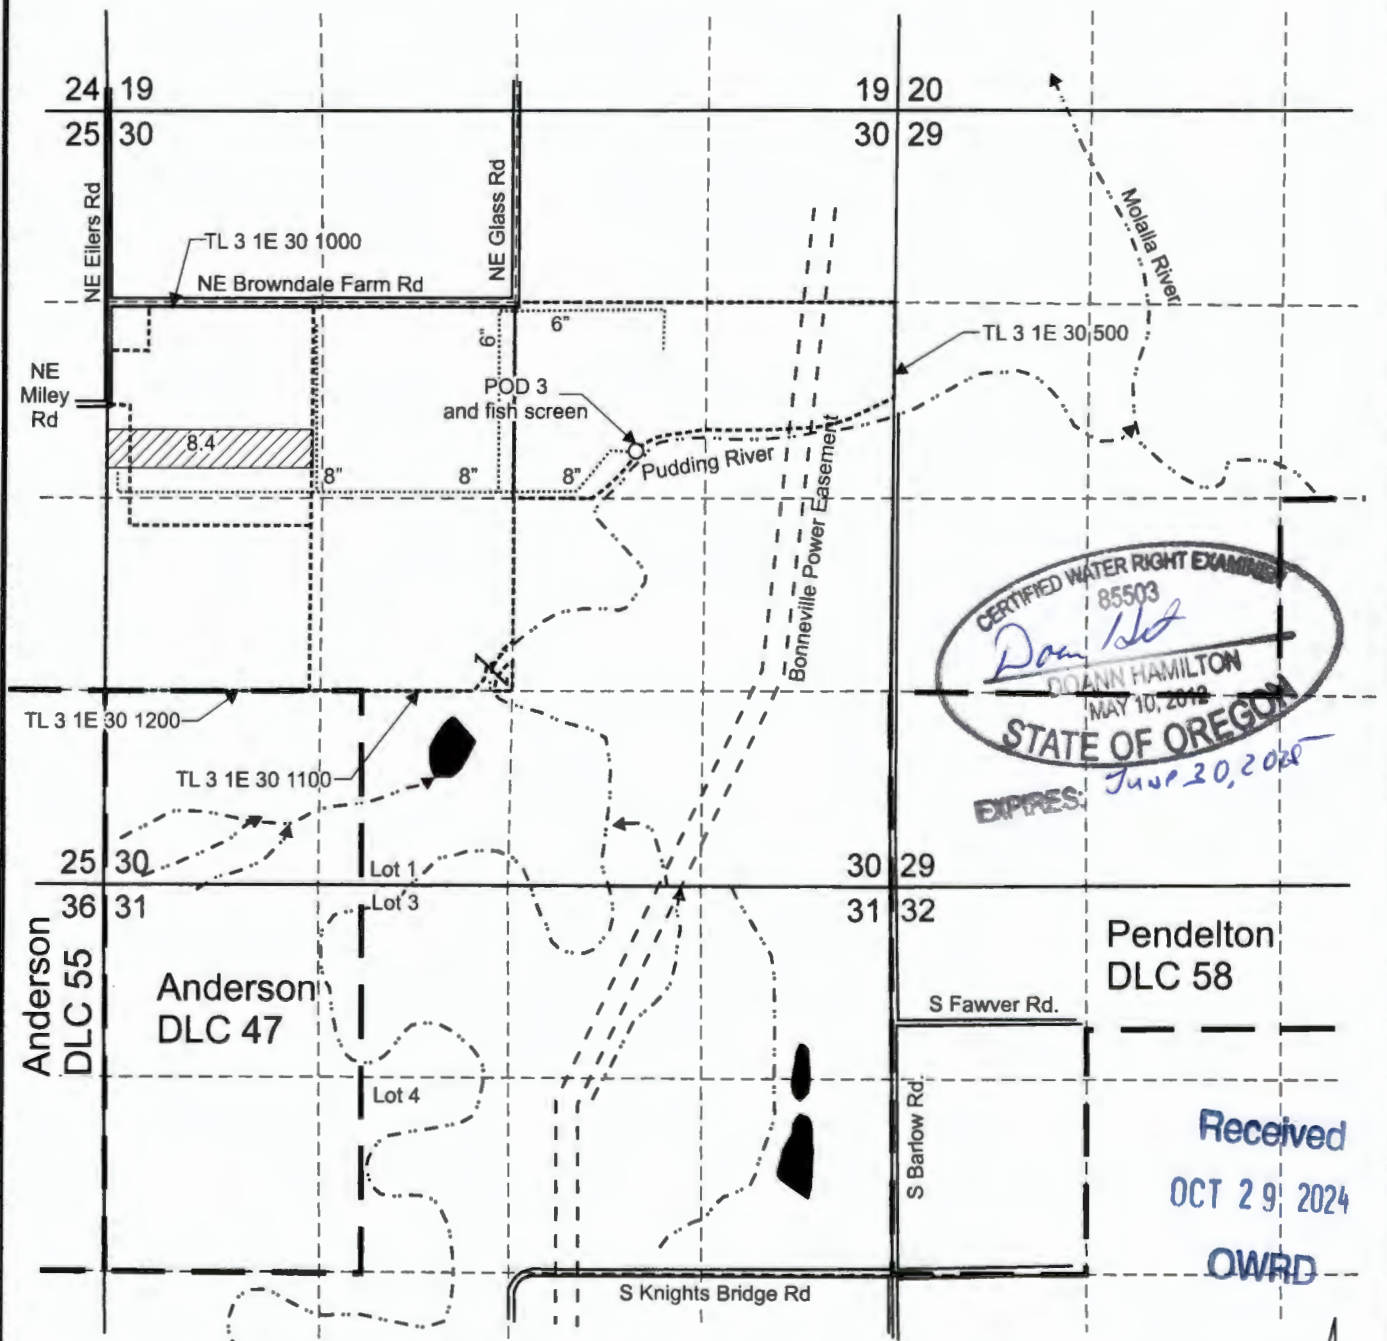

POD 3 is located 2,330 feet south and 1,790 feet west from NE corner, Section 30.

 Area (8.4 Acres) of primary irrigation under T-13112, formerly Certificate 15413, priority date: 8-15-1939.

----- Tax lot boundary — • — Donation Land Claim boundary Water main line

Scale: 1" = 1,320'



0 1,320 Feet

This map was prepared for the purpose of identifying the location of a water right only and is not intended to provide legal dimensions or location of property ownership lines.

Pacific Hydro-Geology Inc.

Claim of Beneficial Use Map
T-13112, formerly Certificate 15413

10/2024

Bob Gabriel
T.3S. R.1E. Sect 29, 30, & 31 W.M.