
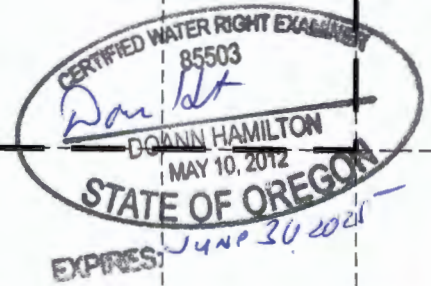


T.3S. R.1E. Sect. 29, 30, & 31, W.M.

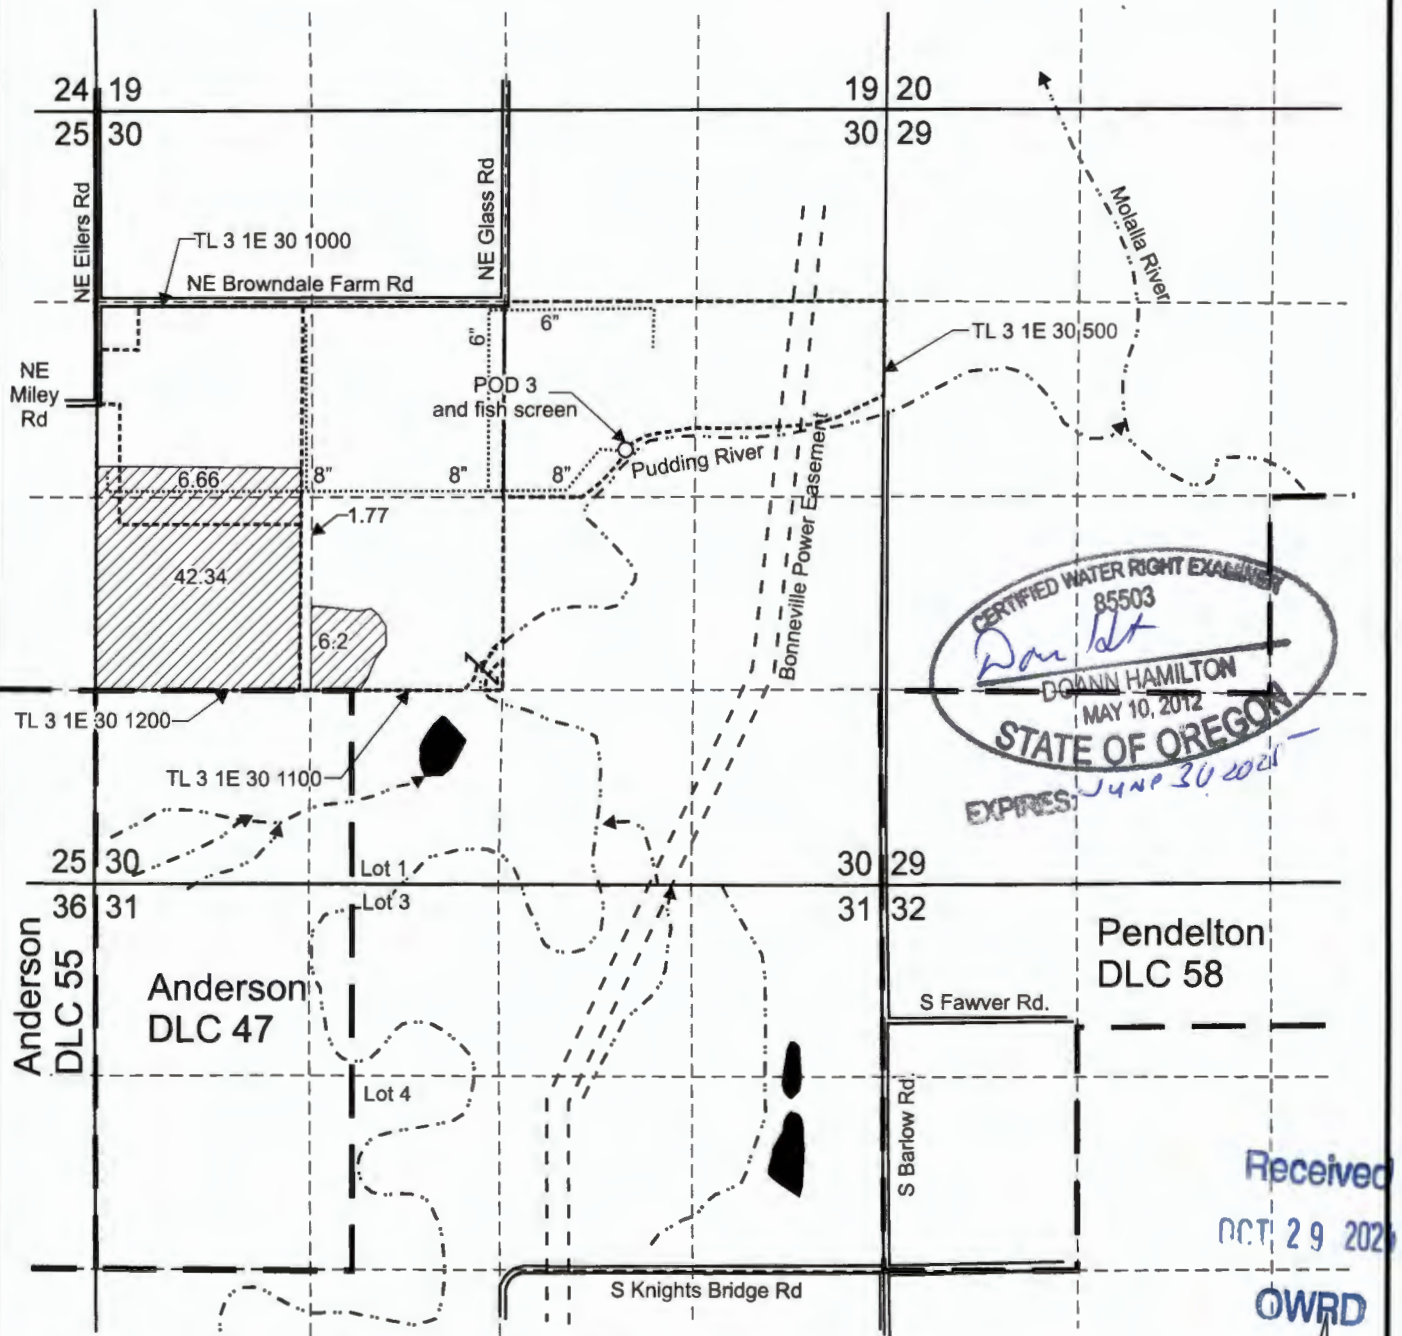

Received
OCT 29 2020
OWRD

POD 3 is located 2,330 feet south and 1,790 feet west from NE corner, Section 30.

 Area (55.2 Acres) of primary irrigation under T-13112, formerly Certificate 54224, priority date: 4-11-1974.

----- Tax lot boundary — ■ — Donation Land Claim boundary Water main line

Scale: 1" = 1,320'



This map was prepared for the purpose of identifying the location of a water right only and is not intended to provide legal dimensions or location of property ownership lines.

Pacific Hydro-Geology Inc.

Claim of Beneficial Use Map
T-13112, formerly Certificate 54224

10/2024

Bob Gabriel
T.3S. R.1E. Sect 29, 30, & 31 W.M.