

U.S. Geological Survey
Quadrangle Location
Painted Hills &
Lawson Mountain

Received by OWRD

OCT 01 2024


Salem, OR

NOTES

1. This map was prepared for the purpose of identifying the location of water rights only and is not intended to provide legal dimensions or locations of property ownership lines.



EXPIRES:
RENEWS: 1/1/2025

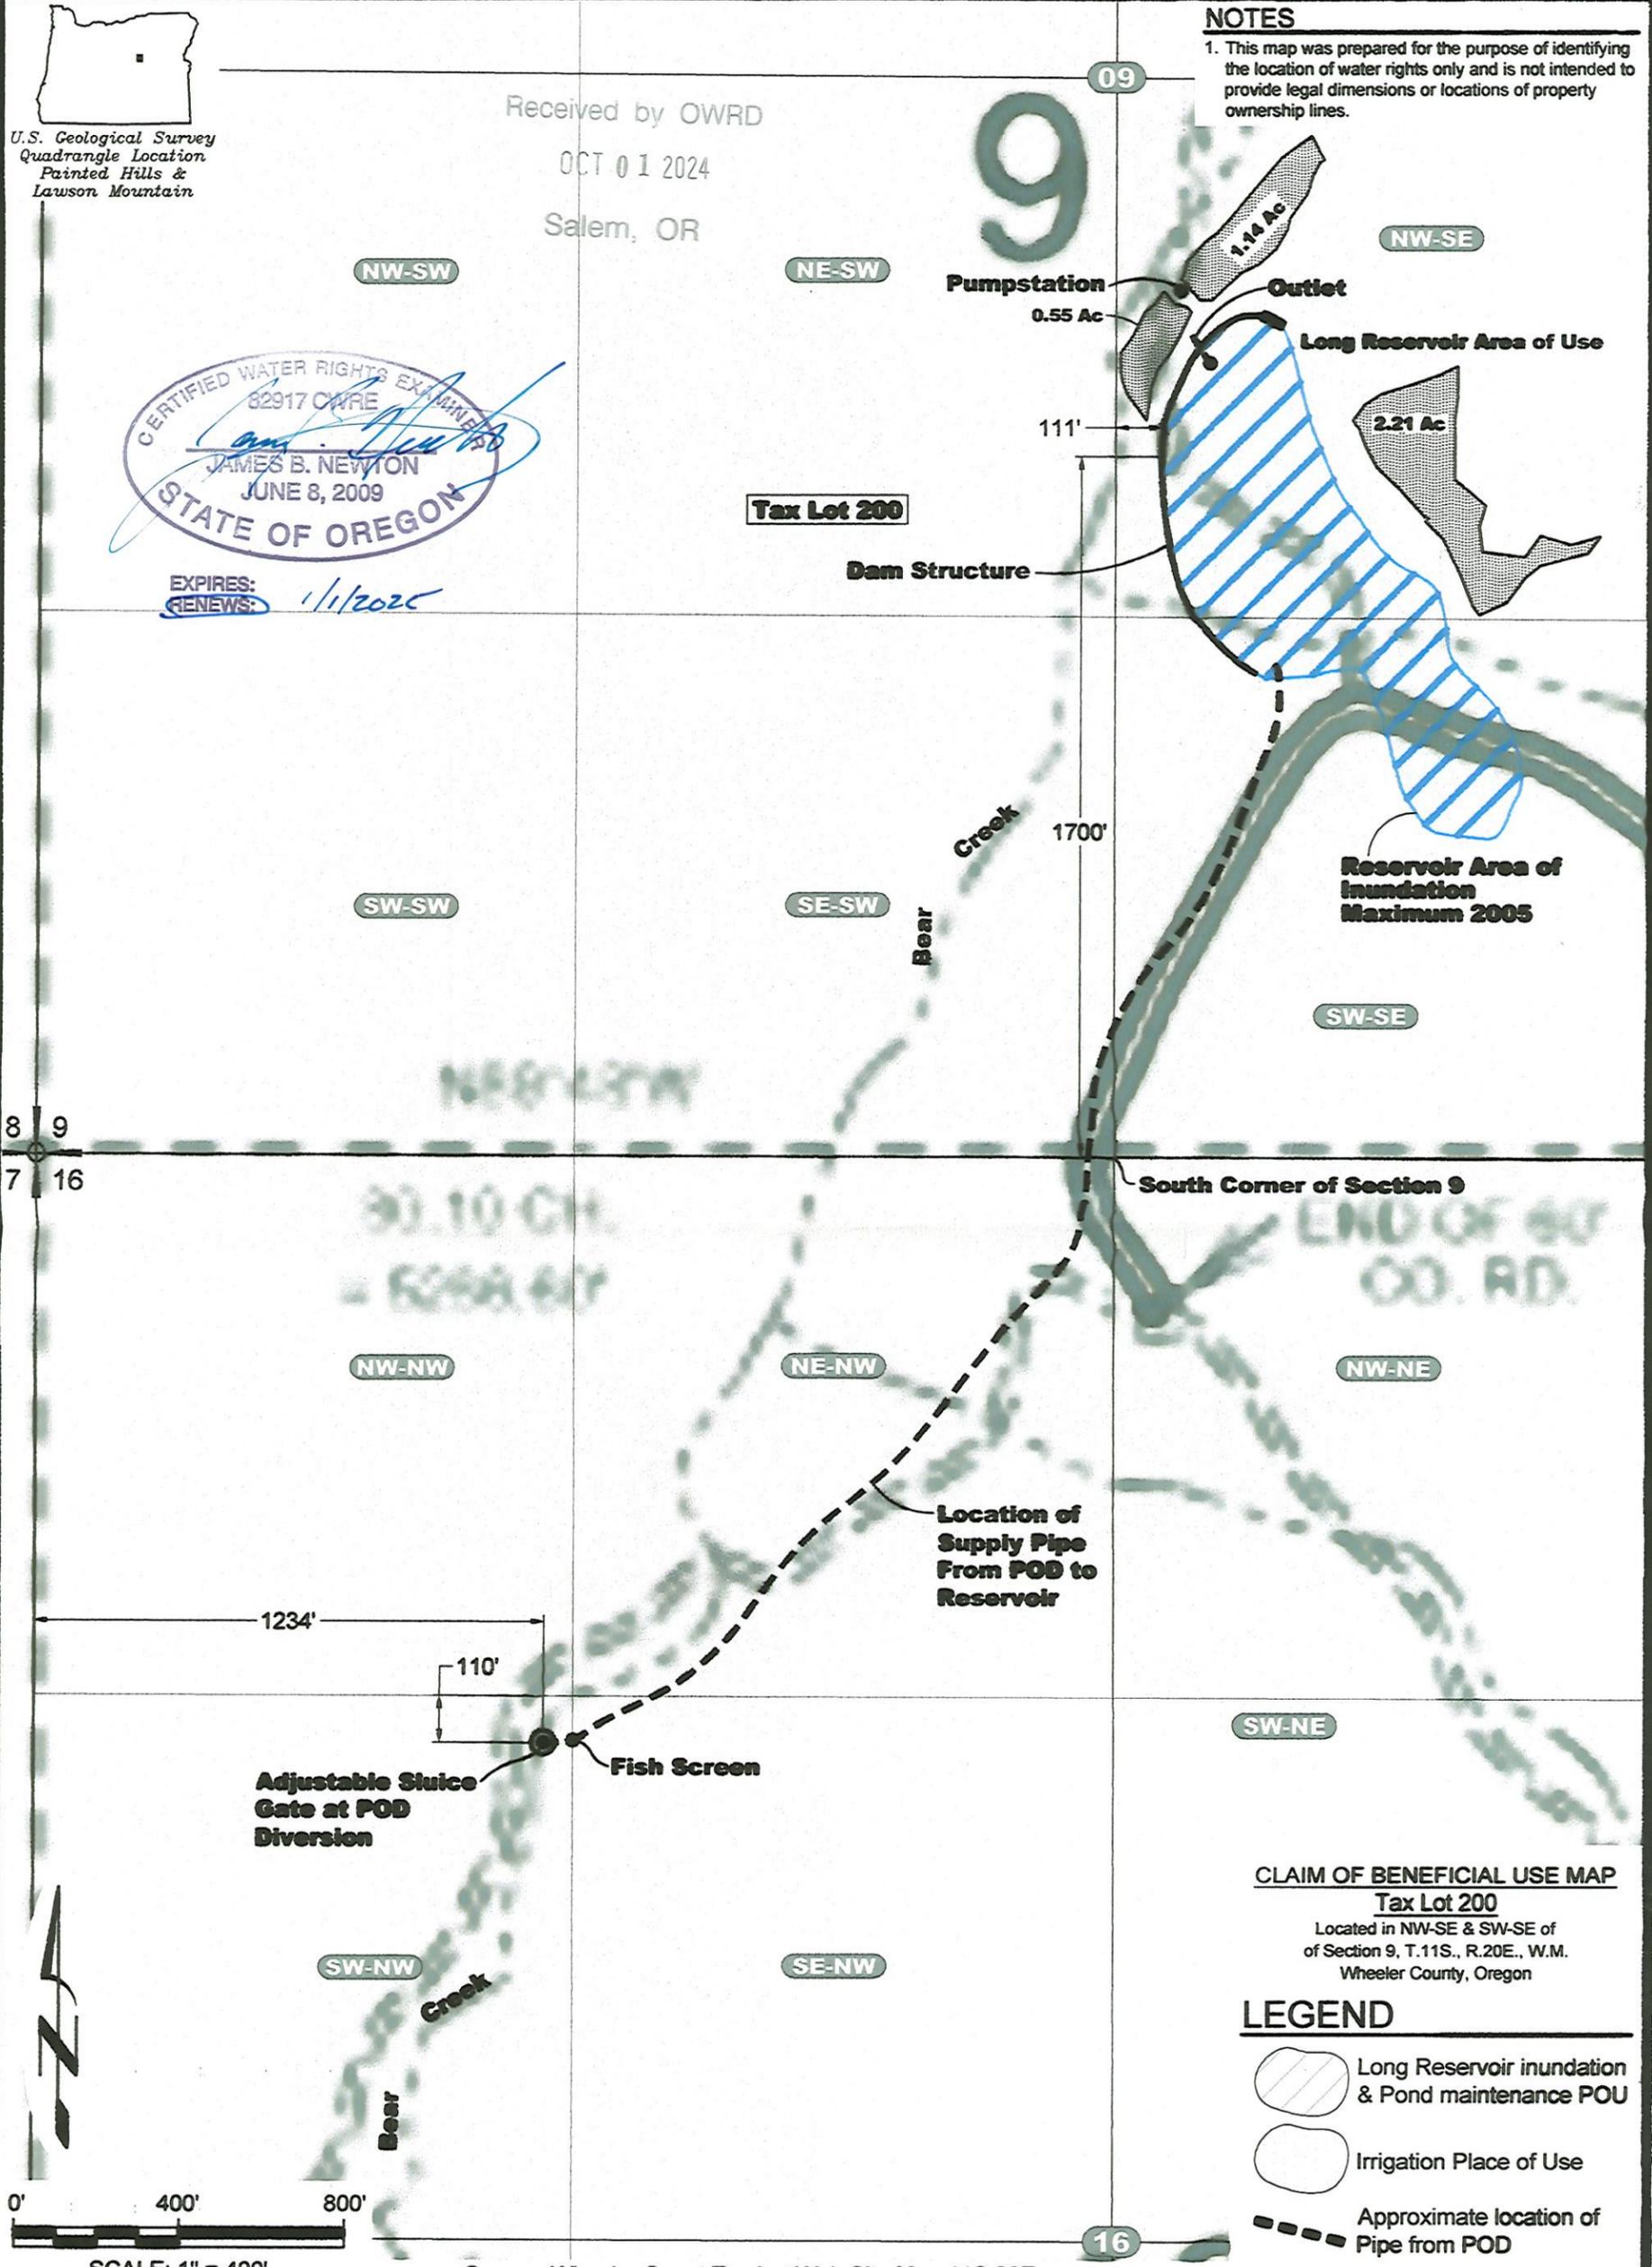


CLAIM OF BENEFICIAL USE MAP

Tax Lot 200

Located in NW-SE & SW-SE of
of Section 9, T.11S., R.20E., W.M.
Wheeler County, Oregon

LEGEND

- Long Reservoir inundation & Pond maintenance POU
- Irrigation Place of Use
- Approximate location of Pipe from POD

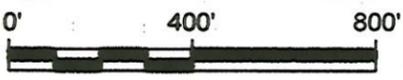

SCALE: 1" = 400'

Source: Wheeler County Tax Lot Web Site Map 11S 20E

CASCADE
GEOENGINEERING
360.907.4162
cascadageoengineering.com

Claim of Beneficial Use Map - T-8691
Long Reservoir Pond Maintenance & Irrigation
Wheeler County, Oregon

DESIGNED BY: J. Newton	DRAWN BY: R2D	DATE: SEPT 2024	PROJECT NO. CG 1000-101	FIGURE 1
----------------------------------	-------------------------	---------------------------	-----------------------------------	--------------------