


Township 4S, Range 1W, W.M.

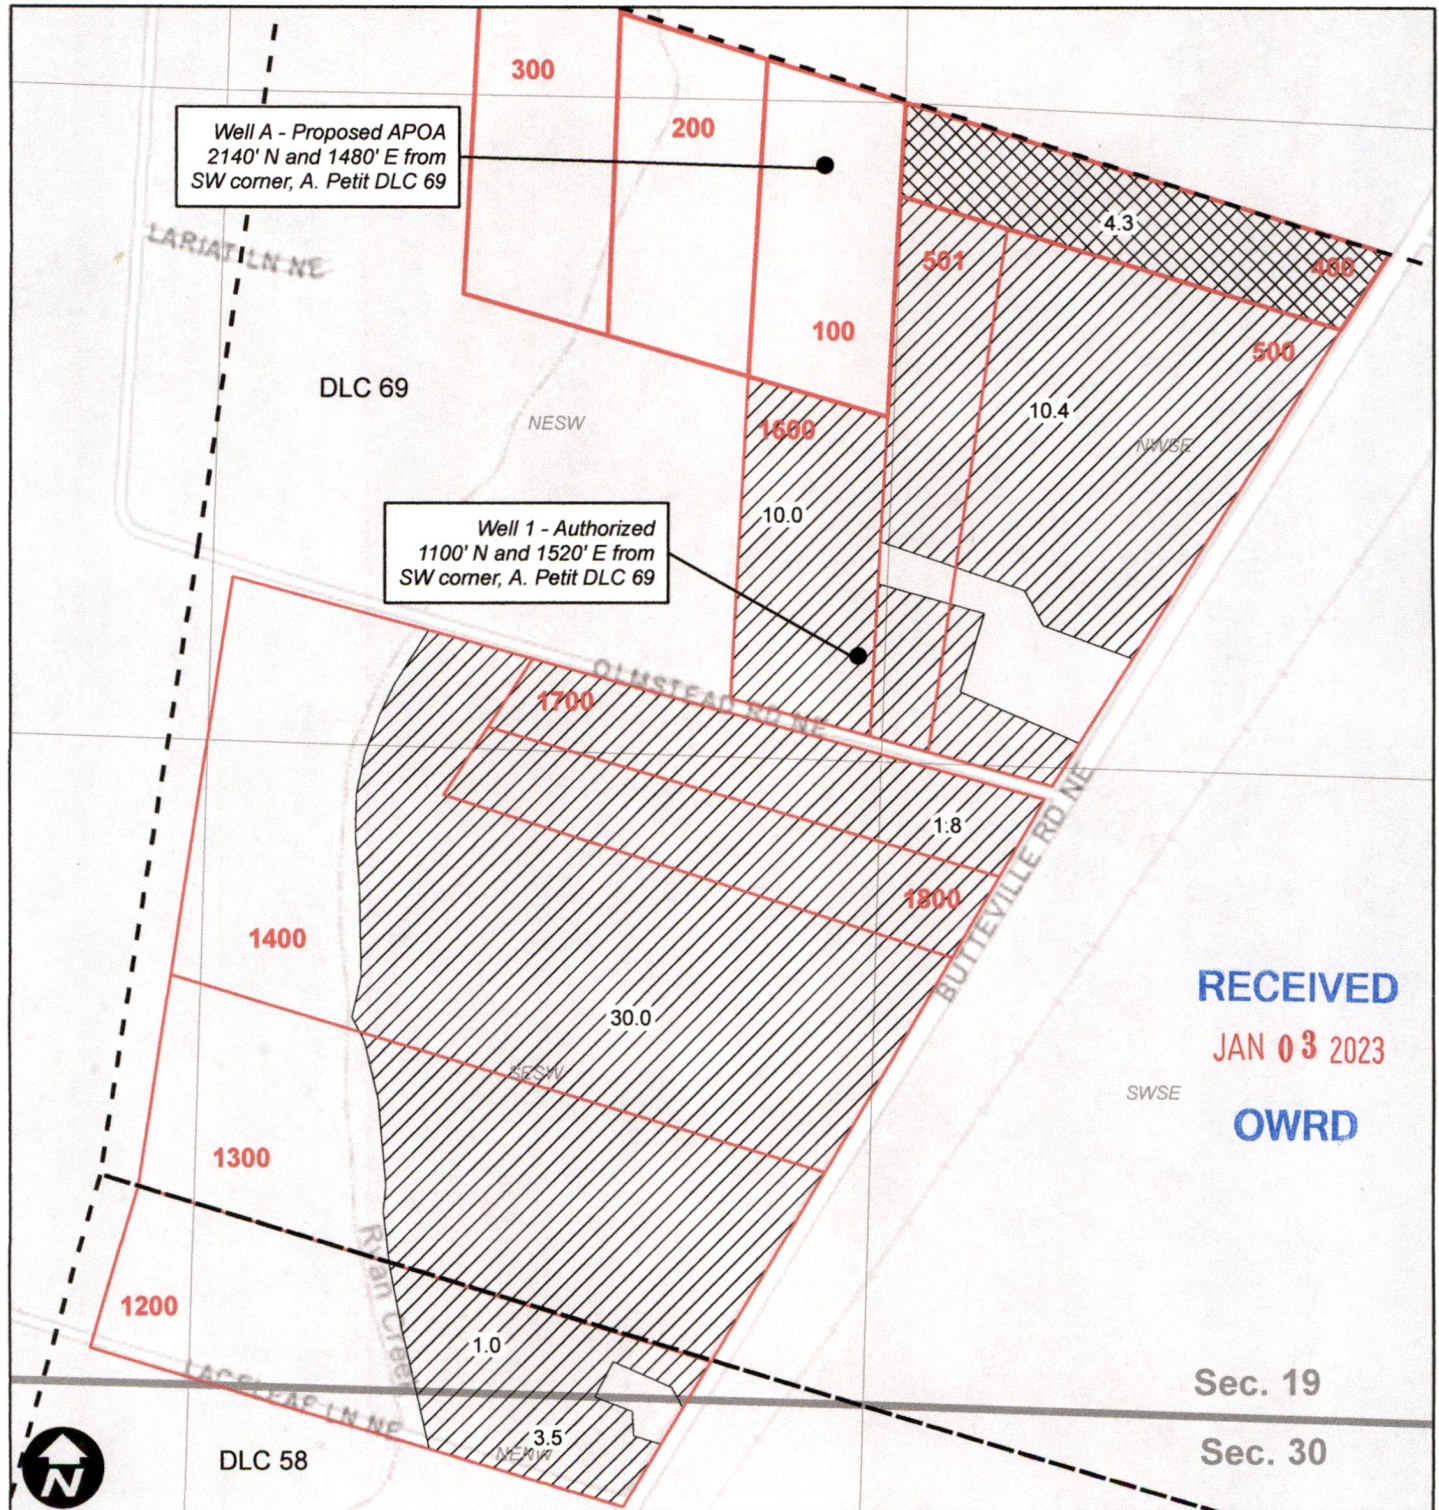

RECEIVED


JAN 03 2023

OWRD


Sec. 19

Sec. 30

Legend

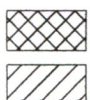

Cert. 56530 APOA Change

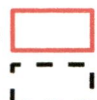

Taxlot


Cert. 56530 No Change

DLC



EXPIRES: 12-31-2022

T. 4 S. R. 1 W., W.M.

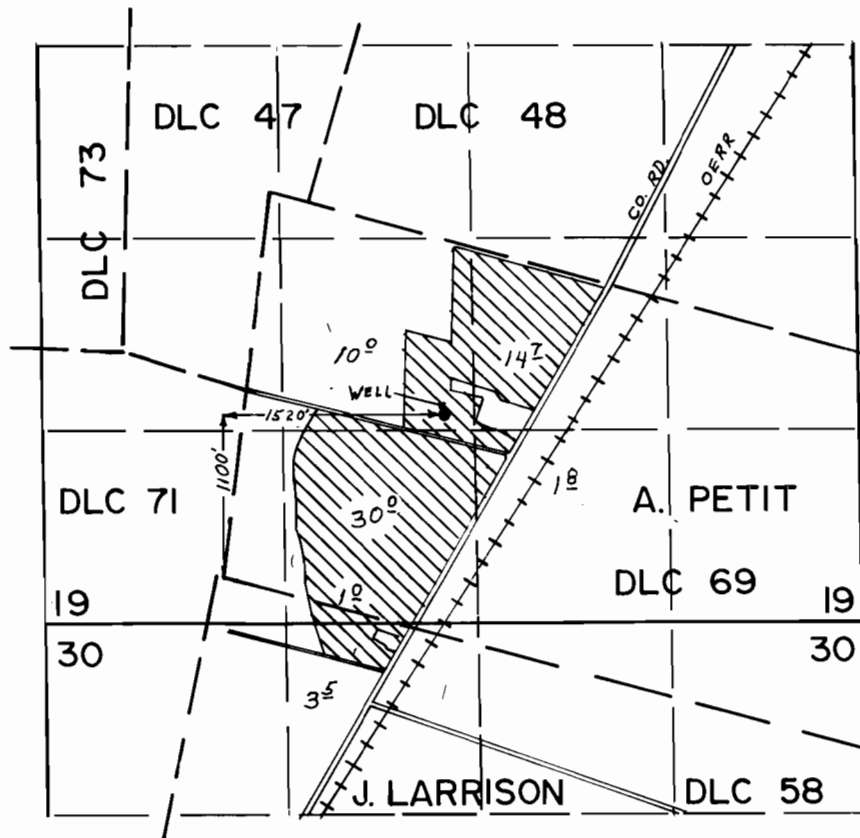

FINAL PROOF SURVEY UNDER

Application No. G-7242.. Permit No. G-6647..
IN NAME OF

.....NORBERT H. GILLES.....

Surveyed SEP. 25. 1978., by S. P. APPLEGATE.