


Claim of Beneficial Use
Permit S-55080, Application S-88396

A Water Right held by Lee Bischoff
Polk County

RECEIVED

JUL 26 2023

OWRD

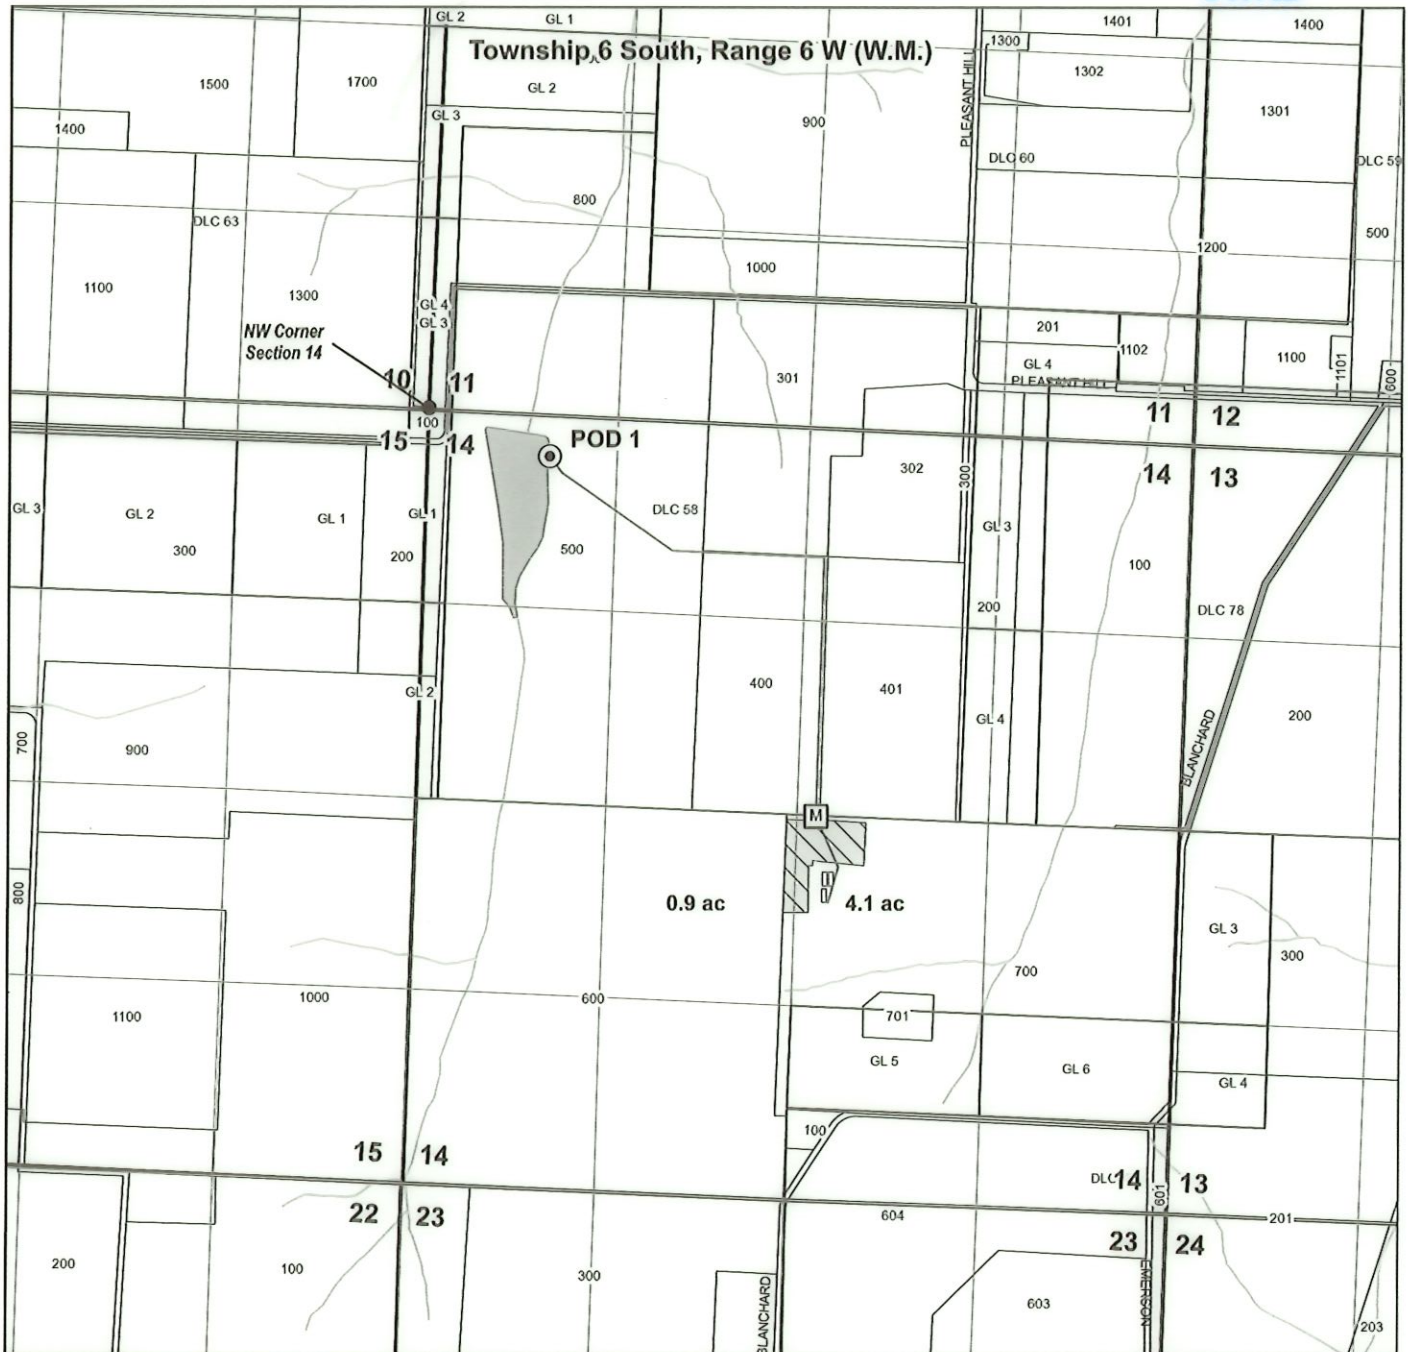

LEGEND

- ⊙ Point of Diversion (POD)
- ▨ Place of Use (POU)
- - - Property Lines
- Donation Land Claim
- Government Lot
- ~ Streams
- ~ Conveyance Mains


POA Location Description

POD 1
Located 310 feet South and 845 feet East from NW corner of
Section 14 (NWNW), Township 6 South, Range 6 West, W.M.



RENEWES: 12.31.2024

CWRE Seal and Signature

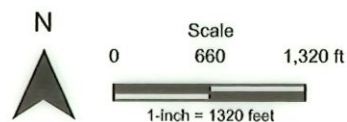

Date: 6/24/2023
Data Sources: BLM, OWRD, USGS, Polk Co.
Disclaimer: This map is not intended to provide legal dimensions
or property ownership lines.

