


Claim of Beneficial Use Map

Section 29 & 32, T4S, R1W, Marion County
Transfer T-13493 (Cert. 85763)

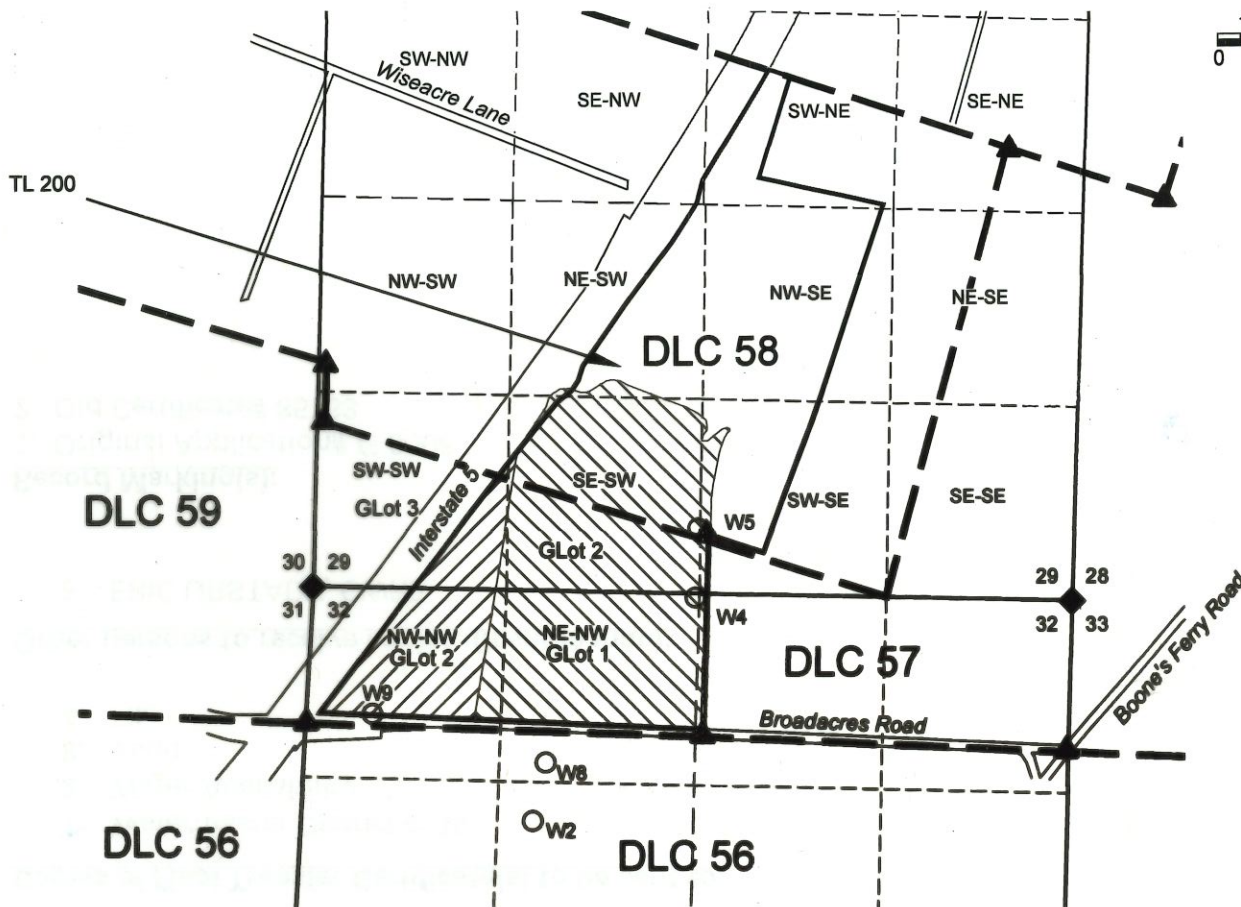

1 IN = 1320 FT
0 660 1320



NOTES:

THIS MAP IS NOT INTENDED TO PROVIDE LEGAL DIMENSIONS OR LOCATIONS OF PROPERTY OWNERSHIP LINES.

-PROPERTY LINES, QUARTER-QUARTER AND DONATION LAND CLAIM (DLC) LINES ARE BASED ON THE TAX ASSESSOR MAP FOR SECTION 29, T4S, R1W.

-WATER CONVEYANCE LINES SHALL BE ALL WITHIN THE PROPERTY AND THEREFORE ARE NOT SHOWN.

LOCATIONS OF POA'S:

WELL #4 70' S & 2750' E of SW S29*
WELL #5 370' N & 2750' E of SW S29*
WELL #8 1380' N & 920' W of C1/4 S32*
WELL #9 875' S & 405' E of NW S32.

* PER CERTIFICATE


LEGEND



▲ DONATION LAND CLAIM (DLC) CORN
◆ SECTION CORNER
○ POINT OF APPROPRIATION (WELL)
--- STREAM OR SURFACE DRAINAGE
=== TAX LOT LINE
--- SECTION LINE
--- QUARTER-QUARTER LINE
--- DLC LINES



IRRIG (85763 PRIMARY)
SUPPL (TO 85761)

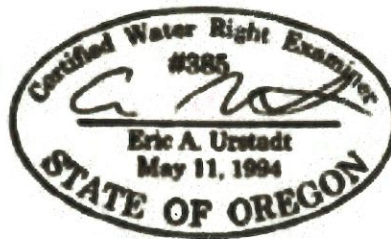

RECEIVED

SEP 25 2003

OWRD

MAP BY:
ASPEN RURAL LAND CONSULTING
ERIC URSTADT, PE, PLS
971-250-1520
Jun2020
OT&T-Triangle3A

RECEIVED

SEP 25 2003

OWRD