


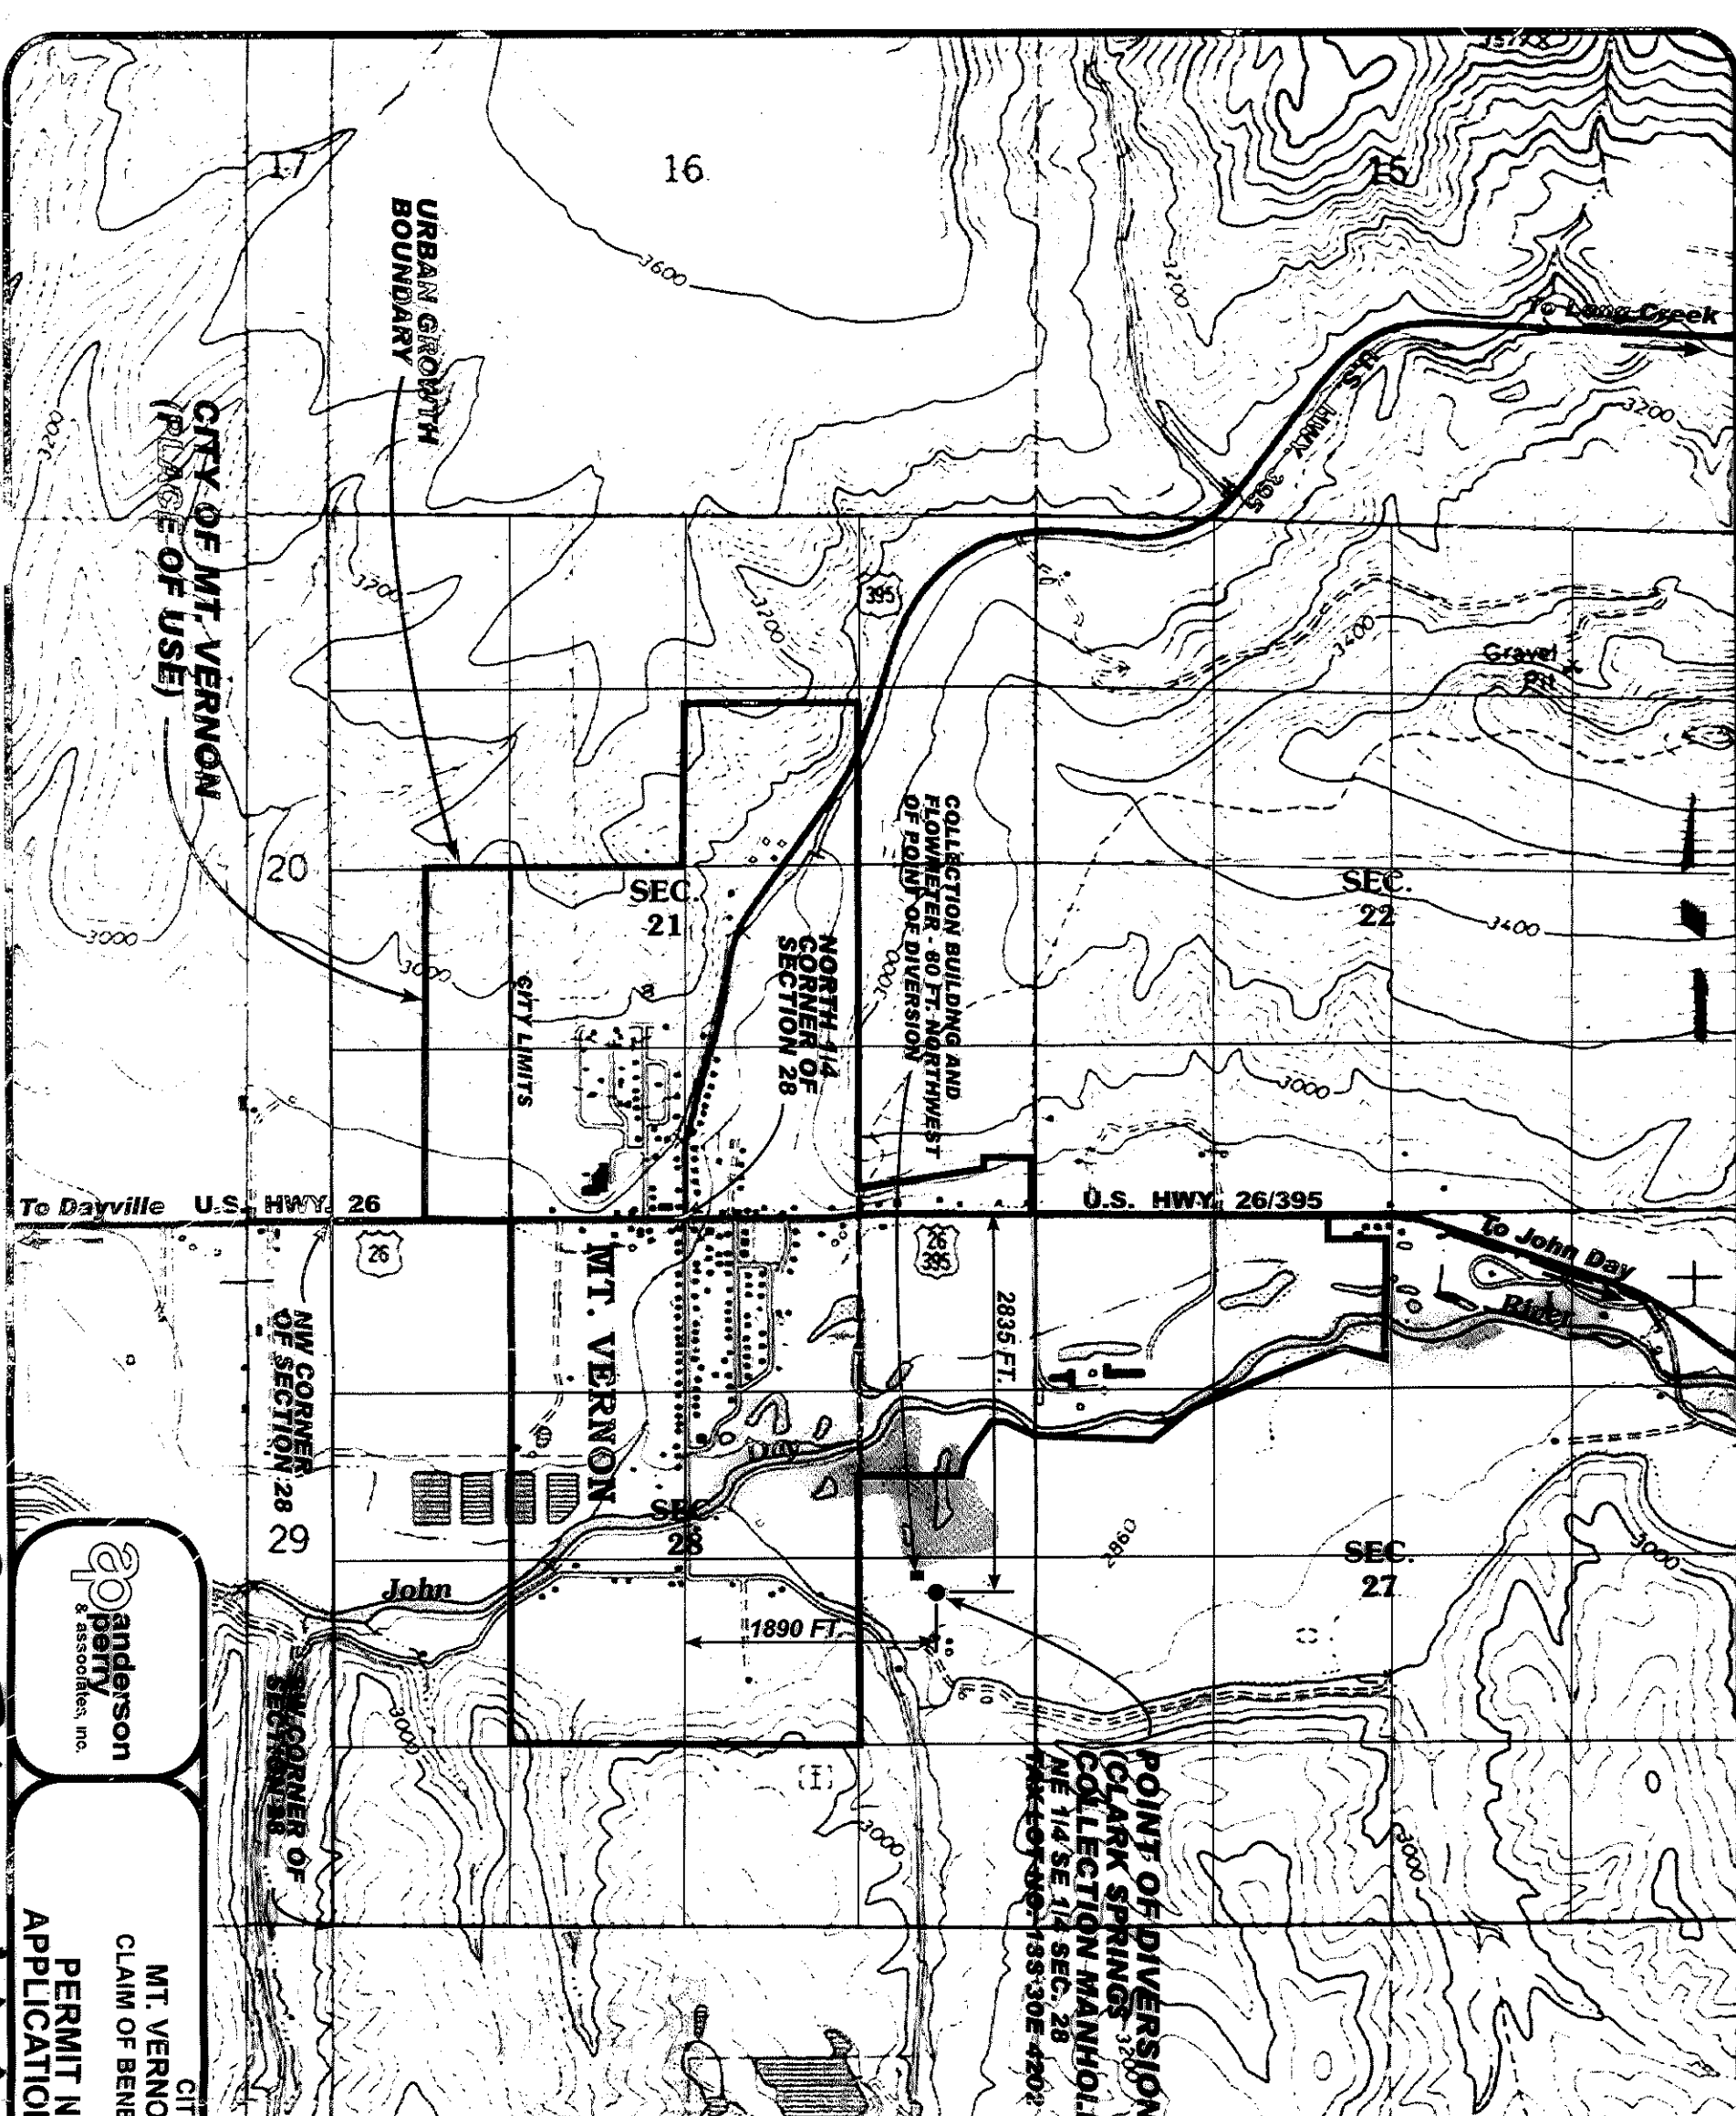

T.13 S., R.30 E., W.M.
GRANT COUNTY
1"= 1320'

PLACE OF USE

SECTION 21
SW 1/4, NE 1/4
SW 1/4 (INCLUSIVE)
NW 1/4, SE 1/4


SECTION 27
NW 1/4 (INCLUSIVE)

SECTION 28
NE 1/4 (INCLUSIVE)
NE 1/4, NW 1/4
SE 1/4, NW 1/4

LEGEND

● POINT OF DIVERSION
— SECTION LINE
— 1/4 OR 1/16 SECTION LINE

THE POINT OF DIVERSION, CLARK SPRING COLLECTION MANHOLE, IS LOCATED 1890 FEET EAST AND 2835 FEET SOUTH OF THE NORTH 1/4 CORNER OF SECTION 28.

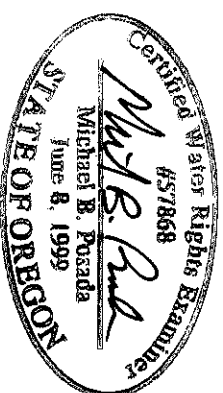

EXPIRATION DATE: 12-31-08
DATED: 03-21-08

NOTE:
THIS MAP IS FOR THE PURPOSE OF LOCATING A WATER RIGHT ONLY AND IS NOT INTENDED TO PROVIDE LEGAL DIMENSIONS OR LOCATIONS OF PROPERTY LINES.

CITY OF
MT. VERNON, OREGON
CLAIM OF BENEFICIAL USE MAP

PERMIT NO. G-12560
APPLICATION NO. G-11679

FIGURE
1

anderson
berry
& associates, inc.

COBU MAP #0340