


T.13S.,R.3W.,W.M.

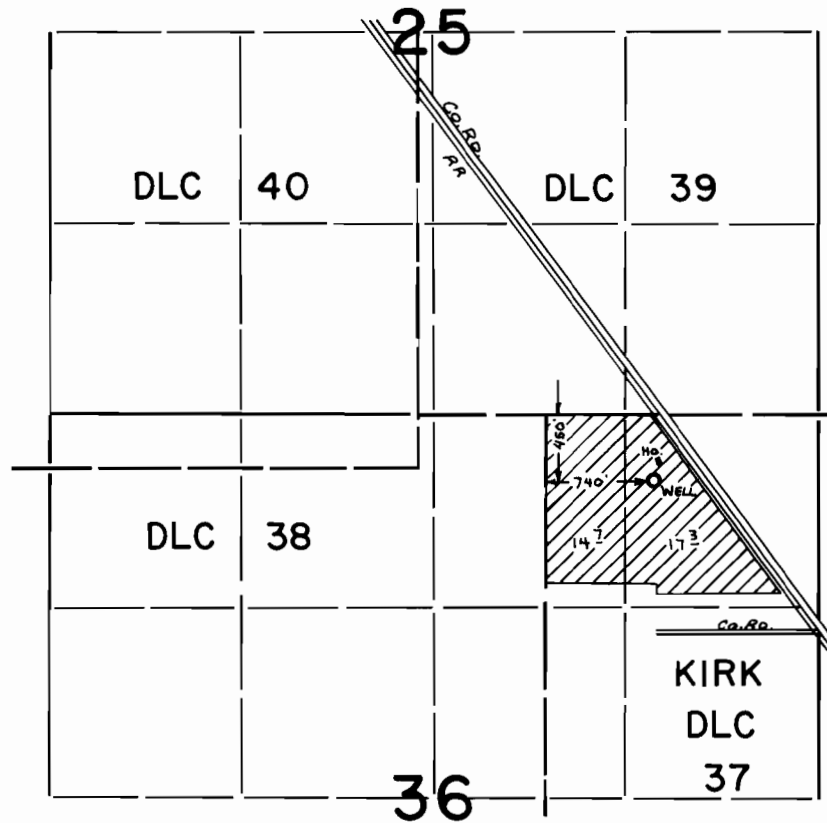

FINAL PROOF SURVEY
UNDER


Application No. ..G-6718. Permit No. ...G-6256..
IN NAME OF

GENE E. & ROSEMARY THORNTON

Surveyed April 23, 1982, by L.M. TOLL.....

Spurlin Farm Inc. - Transfer Application Certificate 56982

Township 13S, Range 3W, W.M.

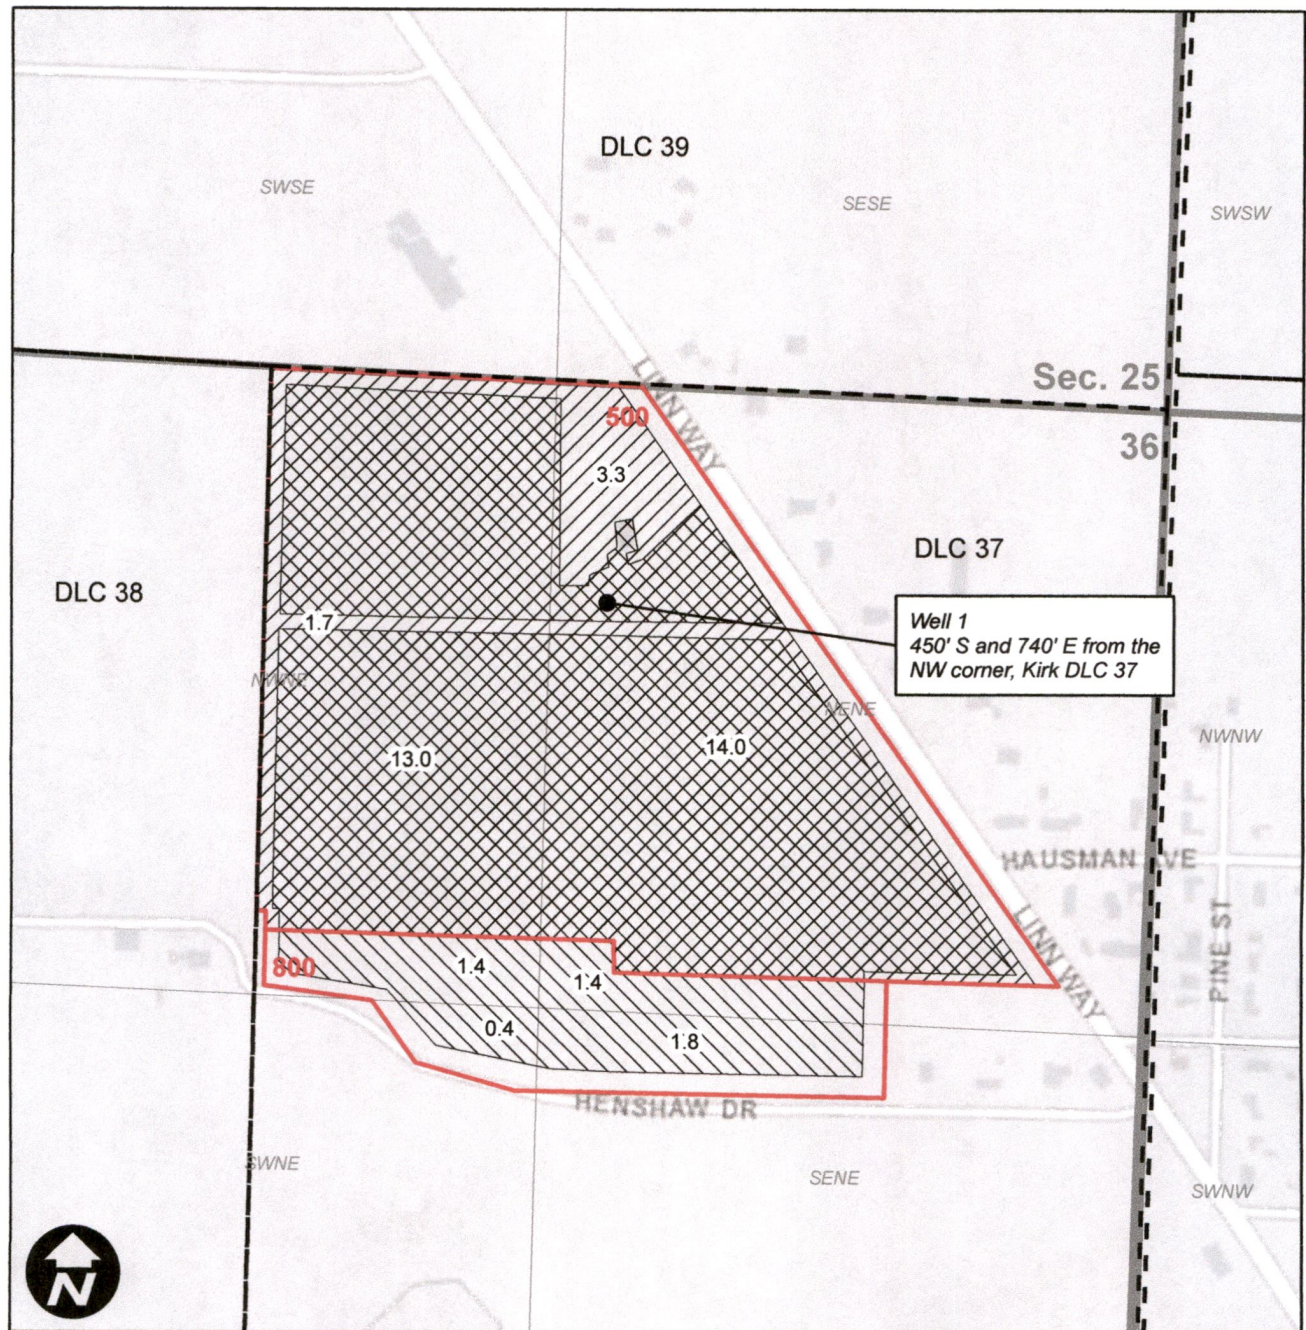

0 200 400 800 Feet

Legend

- Cert. 56982 From
- Transfer To
- Cert. 56982 No Change
- Tax Lot
- DLC



RECEIVED

DEC 01 2023

EXPIRES: 12-31-2024