



T.5S. R.1E. Section 21, W.M.

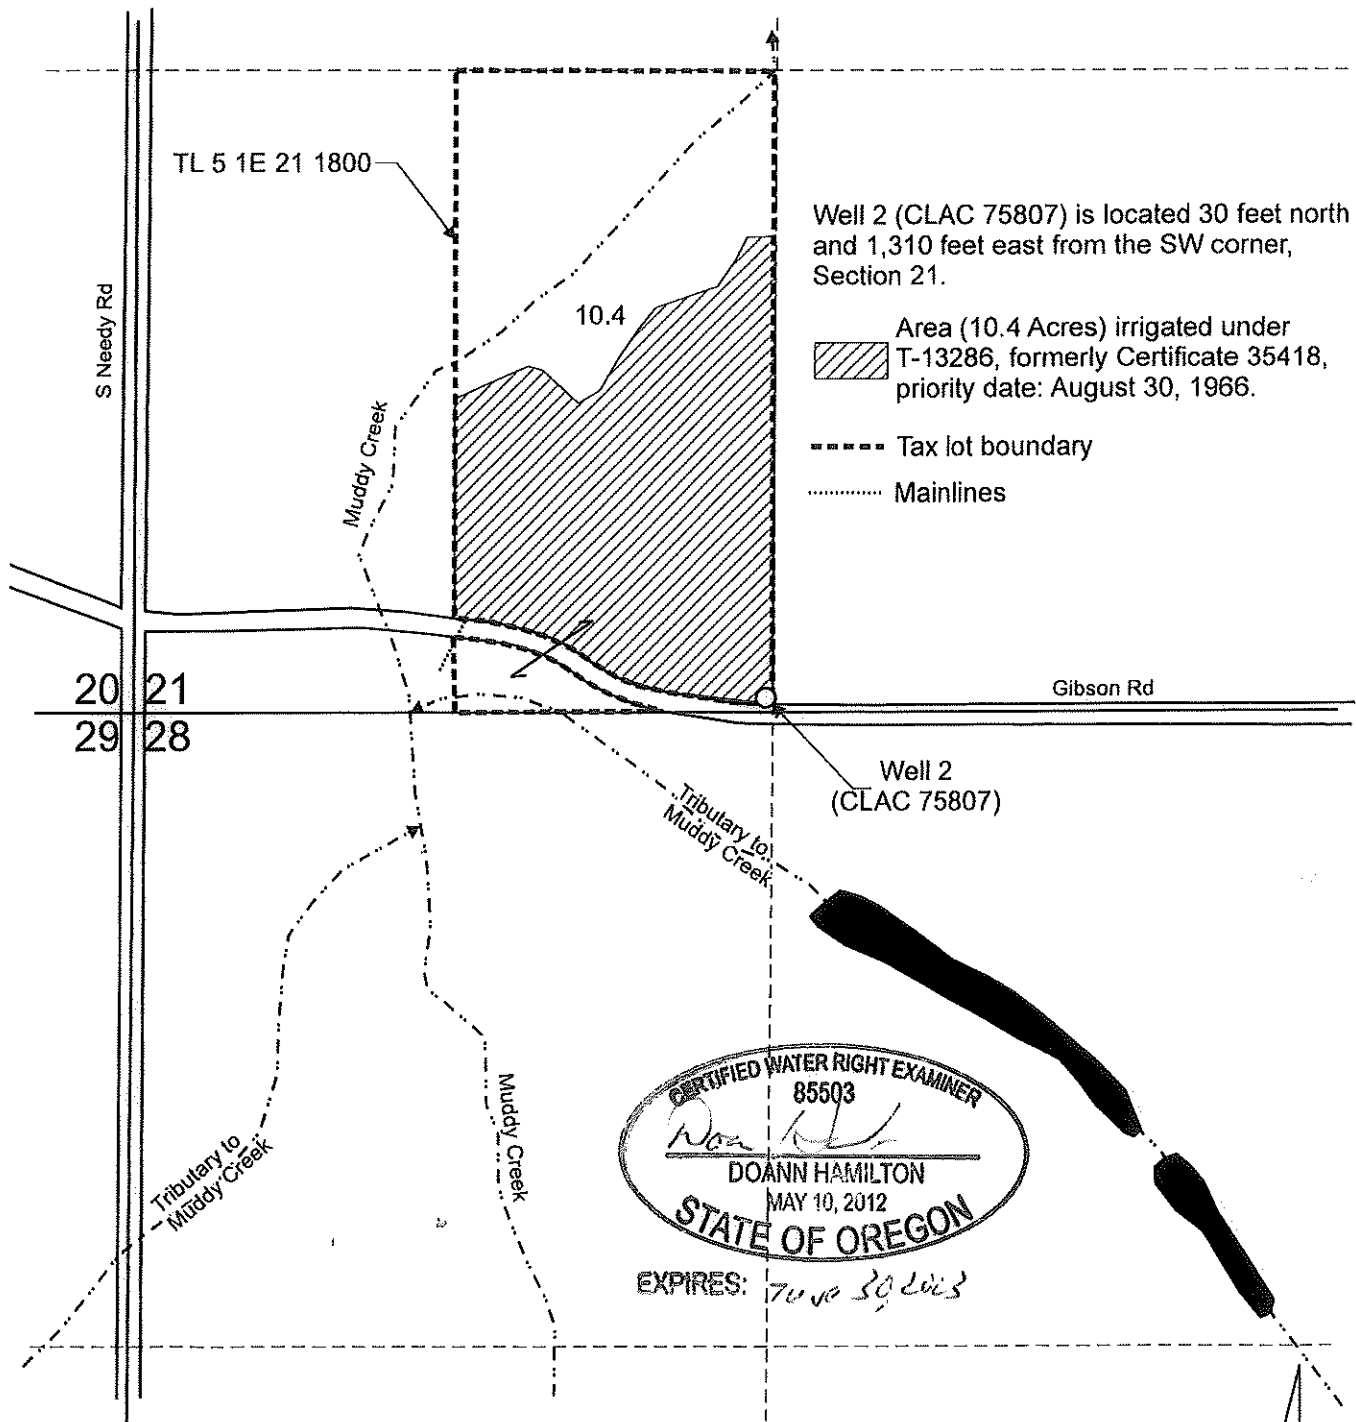

Scale: 1" = 400'

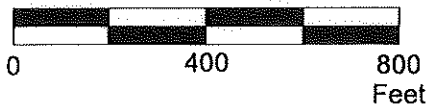

This map was prepared for the purpose of identifying the location of a water right only and is not intended to provide legal dimensions or location of property ownership lines.

Claim of Beneficial Use Map
T-13286, formerly Certificate 35418

Ivan Snegirev
T.5S. R.1E. Section 21, W.M.

12/2022

Pacific Hydro-Geology Inc.