


Claim of Beneficial Use - Transfer T-13212

Quiet Meadow Farms

Township 10S, Range 2W, W.M.

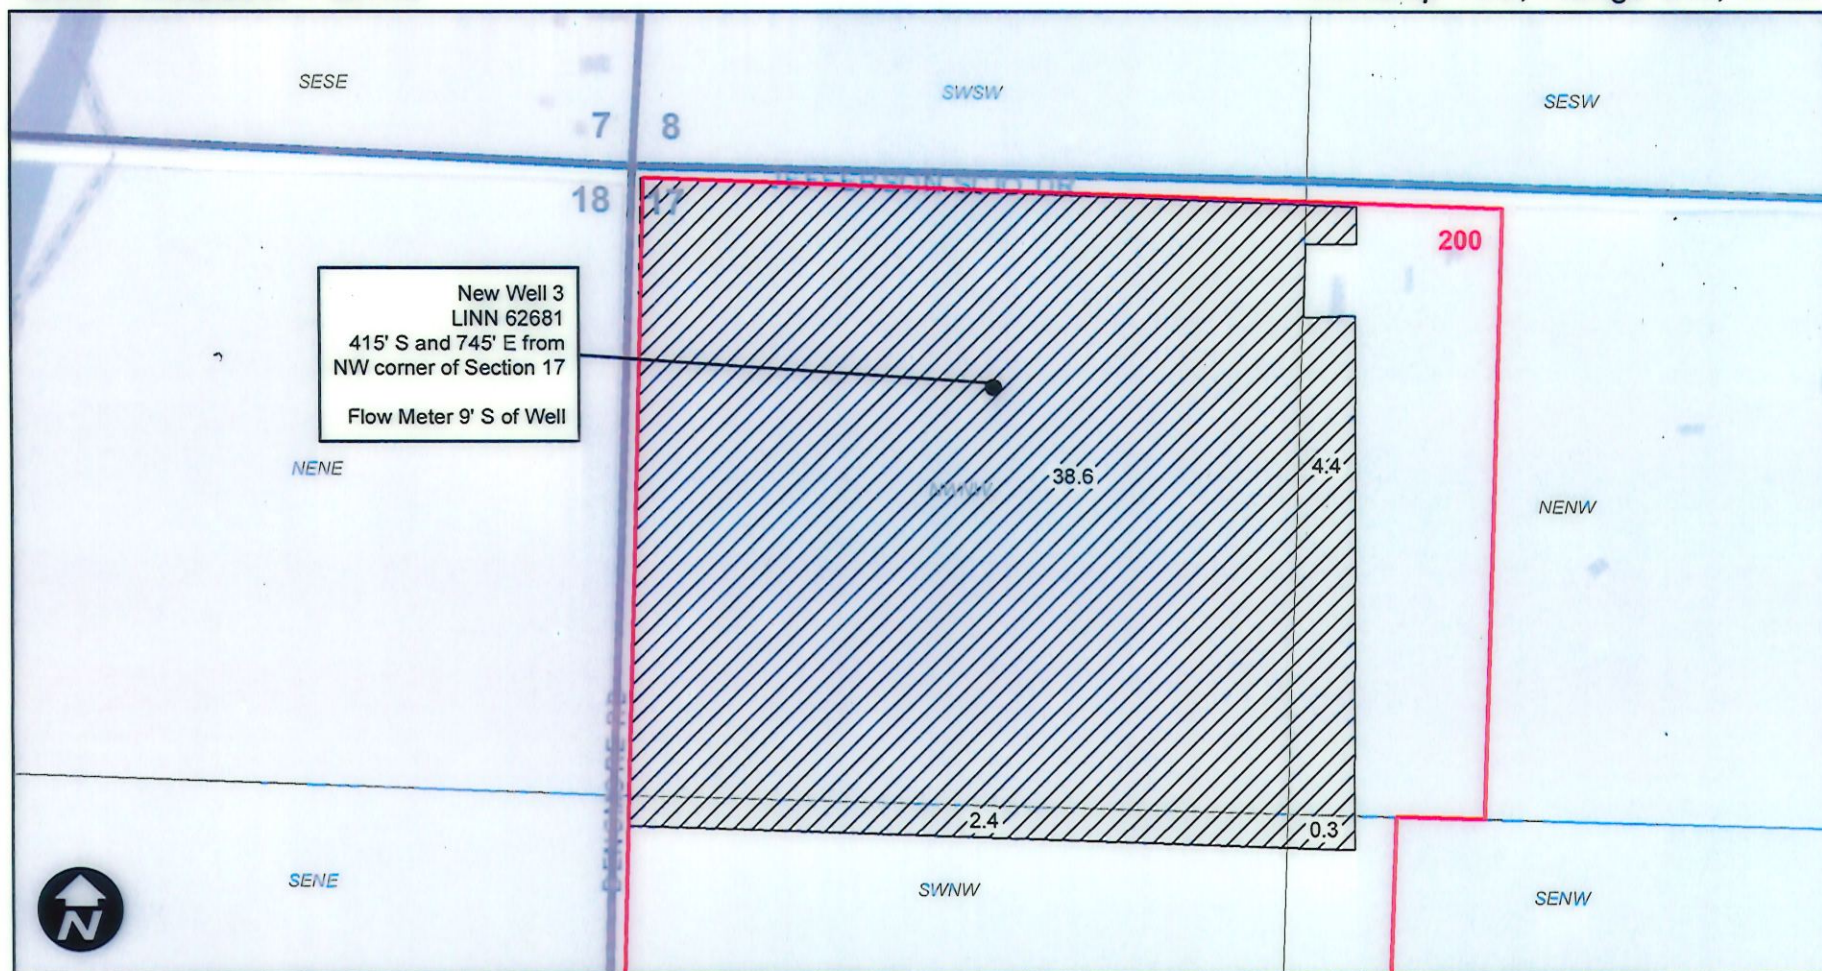

This map is not intended to provide legal dimensions or locations of property ownership lines.

Legend

-  T-13212 POU
-  Taxlot

0 200 400 800 Feet

RECEIVED
SEP 22 2011
OWRD



EXPIRES: 12-31-2024