

● Well

□ Meter

----- Pipeline

 Bulge-in-System


 POU IR

 Section

----- Quarter Quarter


 Tax Lot

Well (DESC 3414 / L-139235) Location:
810' S, 500' E of N 1/4 Cor Sec 33

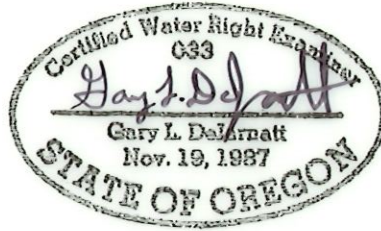


RENEWAL DATE 12/31/2023

T15S R11E, WM
DESCHUTES COUNTY, OR

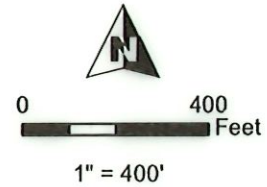

RECEIVED

JUN 06 2022

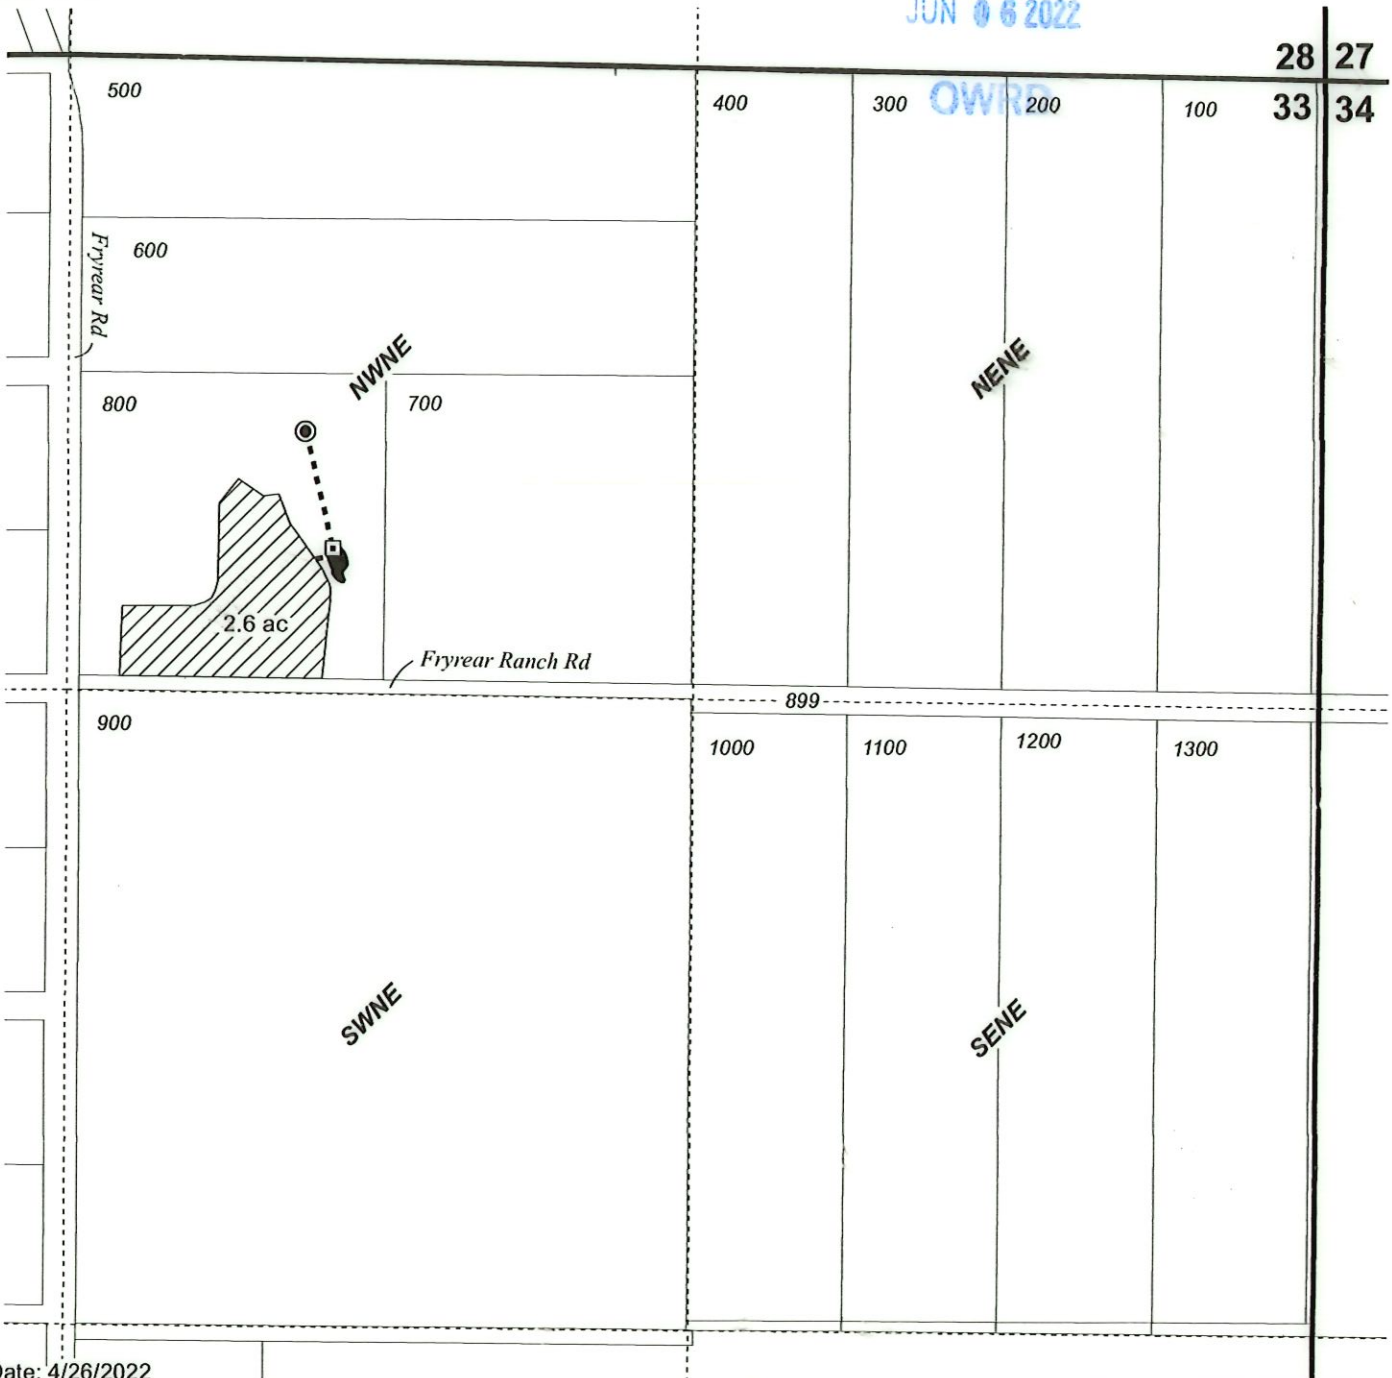

Date: 4/26/2022

CLAIM OF BENEFICIAL USE MAP
Nona Green

Ap G-18485 / Permit G-18299 Project #22015

This map is not intended
to provide legal dimensions
or locations of property
ownership lines.

WATER RIGHT SERVICES, LLC
PO BOX 1830, BEND, OR 97709
WWW.OREGONWATER.US CCB # 197121
johnshort@usa.com 541-389-2837