


Claim Map for Permit G 18514, Application G 18893, Township 15S Range 5W Sections 9
Benton County Tax Lot 155080000700

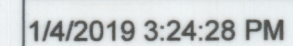

Benton County, Oregon
This product is for informational purposes
and may not have been prepared for,
or be suitable for legal, engineering, or surveying purposes.

Benton County, Oregon - Assessor's Department
Esri, HERE, Garmin, © OpenStreetMap contributors, and the GIS
user community
Source: Esri, DigitalGlobe, GeoEye, Earthstar Geographics,
CNES/Airbus DS, USDA, USGS, AeroGRID, IGN, and the GIS User

AREA OF USE BY QTR-QTR				
TAX LOT	ACRES	40	160	SECTION
700	6.34	NW	NE	9

Irrigation
Risers/Valves

Buried
2"
Water
Supply
Line

Tax Lot
Boundaries


Section
Lines



Quarter
Section
Lines



Quarter
Quarter
Lines

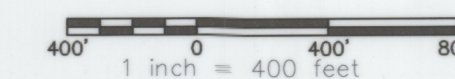

EXPIRATION DATE:12/31/22

RECEIVED
SEP 15 2022
OWRD