


CLAIM OF BENEFICIAL USE

APPLICATION S-89246 PERMIT S-55478

TOWNSHIP 35 SOUTH RANGE 4 WEST, W.M.

JACKSON COUNTY OREGON

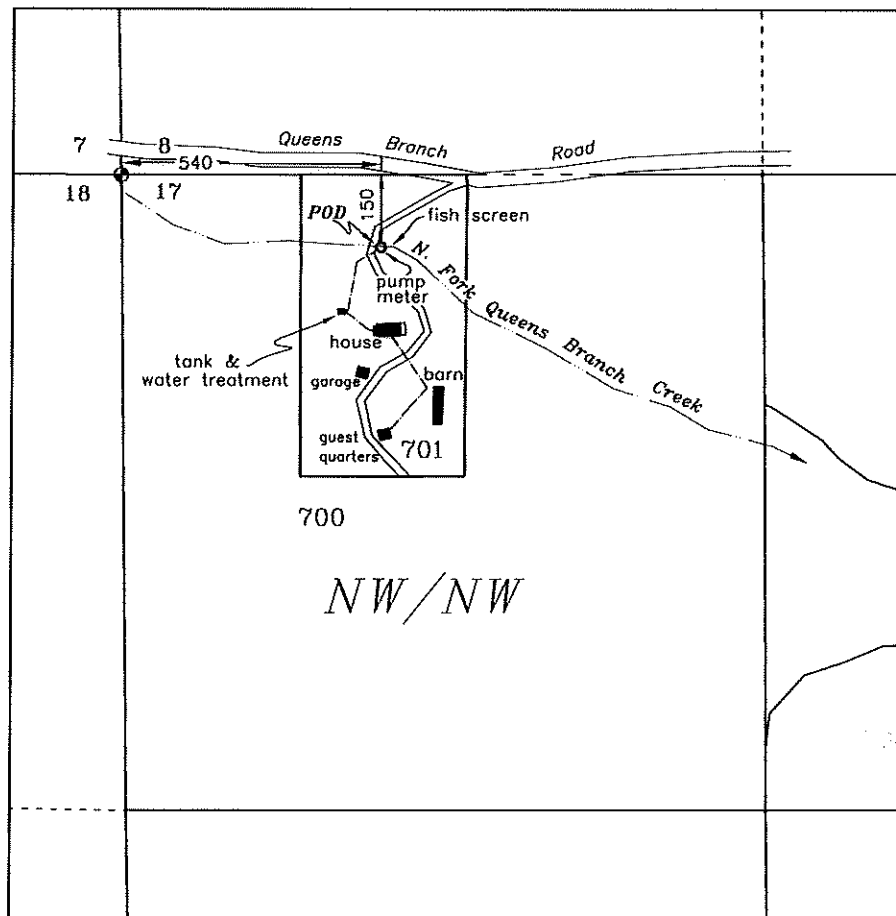


Legend

POINT OF DIVERSION: NW/NW Section 17, 150 feet south & 540 feet east from the NW corner section 17, T35S, R4W, W.M.

Scale
1 inch = 400 feet

USE OF WATER:
Human Consumption
TL-701

PREPARED FOR:
TERRY D. AND TAMARA K. SHORES
P.O. Box 2022
Rogue River, OR 97537-2022

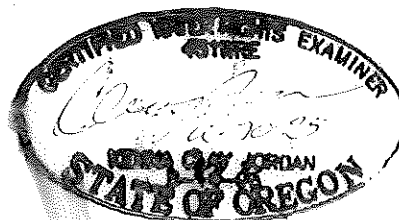

JORDAN ENGINEERING
460 JORDAN LANE
ROSEBURG, OREGON 97471
(541) 673-1931

This map is not intended to provide legal dimensions or locations of property ownership lines

Base map: Jackson Co. GIS Tax Lots over ORmap & 6/29/2018 Google aerial photos for assumed best fit. Partition Plot P-35-2016 used for scale & orientation

4/19/2024 n.e.d.