

CLAIM of BENEFICIAL USE FOR: WILLIAM & ELIZABETH RUEGG BY NATHAN REED PE CWRE T26S, R5W, W.M. SECTION 14 APPLICATION NO.: S-89200 PERMIT NO.: S-55450

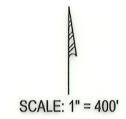

DATE OF SURVEY: JUNE 11, 2024

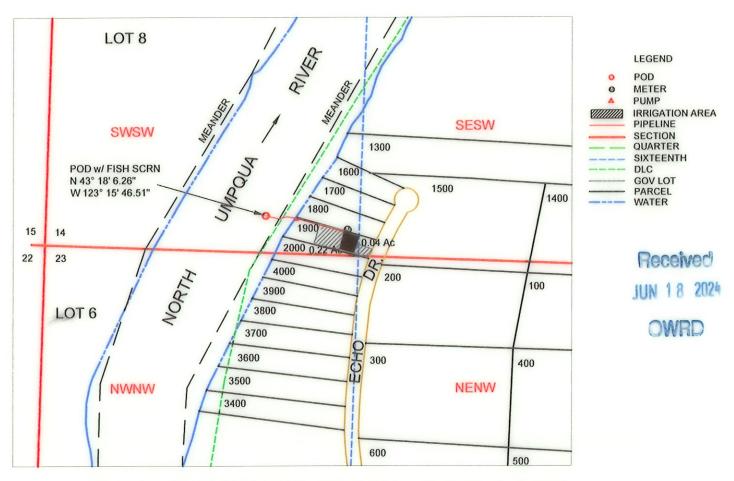

POD IS LOCATED 120 FEET NORTH AND 920 FEET EAST FROM SW CORNER, SECTION 14.



MAP PREPARED FOR: WILLIAM & ELIZABETH RUEGG 1524 ECHO DR. ROSEBURG, OR 97470

THE PURPOSE OF THIS MAP IS TO IDENTIFY THE LOCATION OF THE WATER RIGHT. IT IS NOT INTENDED TO PRVIDE INFORMATION RELATIVE TO THE LOCATION OF PROPERTY OWNERSHIP BOUNDARY LINES.

MAP PREPARED BY: NATHAN REED PE, CWRE 157 WEST BODIE STREET ROSEBURG, OR 97471