


T 18S R 46E WM

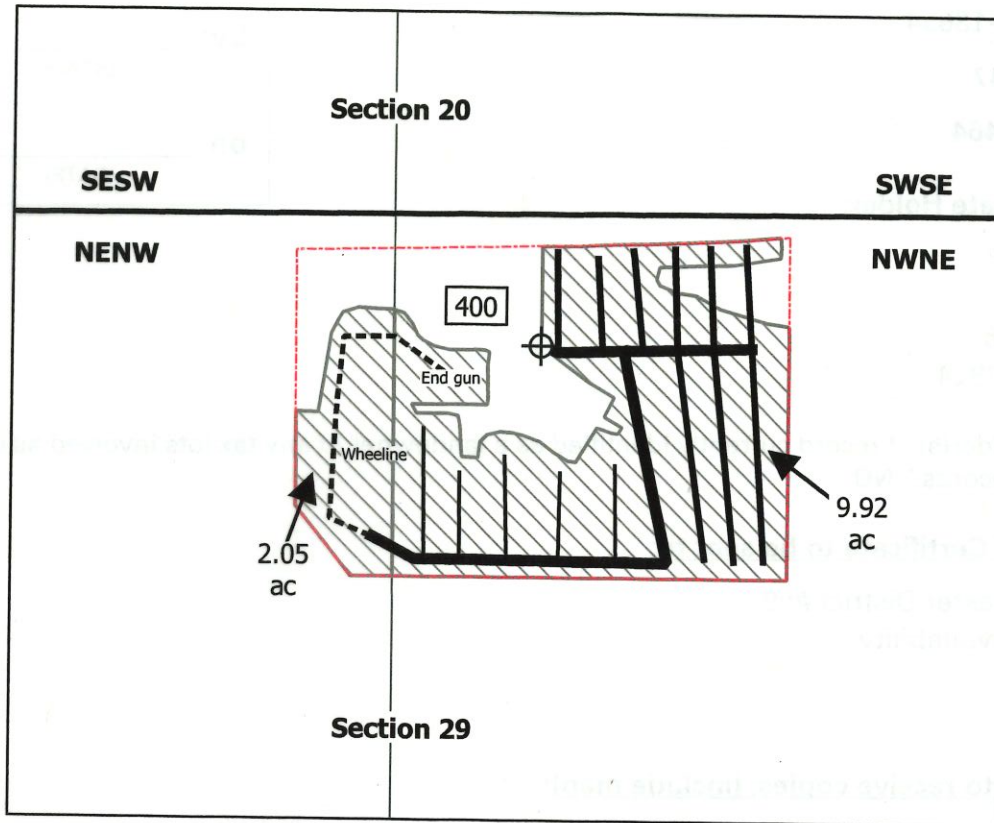


**LEGEND**

-  Well
  -  Place of Use
  -  Malheur County Property Boundary
  -  2" Lateral
  -  3" Handline
  -  3" Lateral
  -  4" Mainline
- 400

Received

OCT 15 2024

OWRD

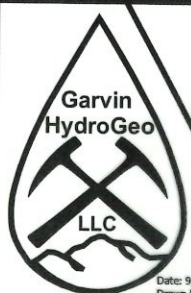

**Claim of Beneficial Use Map  
Application G-18654, Permit G-18247  
Malheur County, OR**

Prepared on behalf of Vern and Amelia Keffer

1 inch = 400 feet



**Notes:**

Well 2 (L-126977): 330' South and 2,226' west from the NE corner of Section 29

Flow measurement device located within a 5 foot radius of Well 2

This map is not intended to provide legal dimensions or locations of property ownership lines.