

Claim of Beneficial Use
VFO Independence, LLC
Transfer T-13366
Benton County, Oregon
Township 12 South, Range 5 West (W.M.)

RECEIVED


MAY 12 2023

OWRD
SALEM, OREGON

POA LOCATION DESCRIPTION

Well 1


Located 1140 feet South and 1410 feet West from the NE corner of DLC 66, Section 31, Township 12 South, Range 5 West (W.M.)

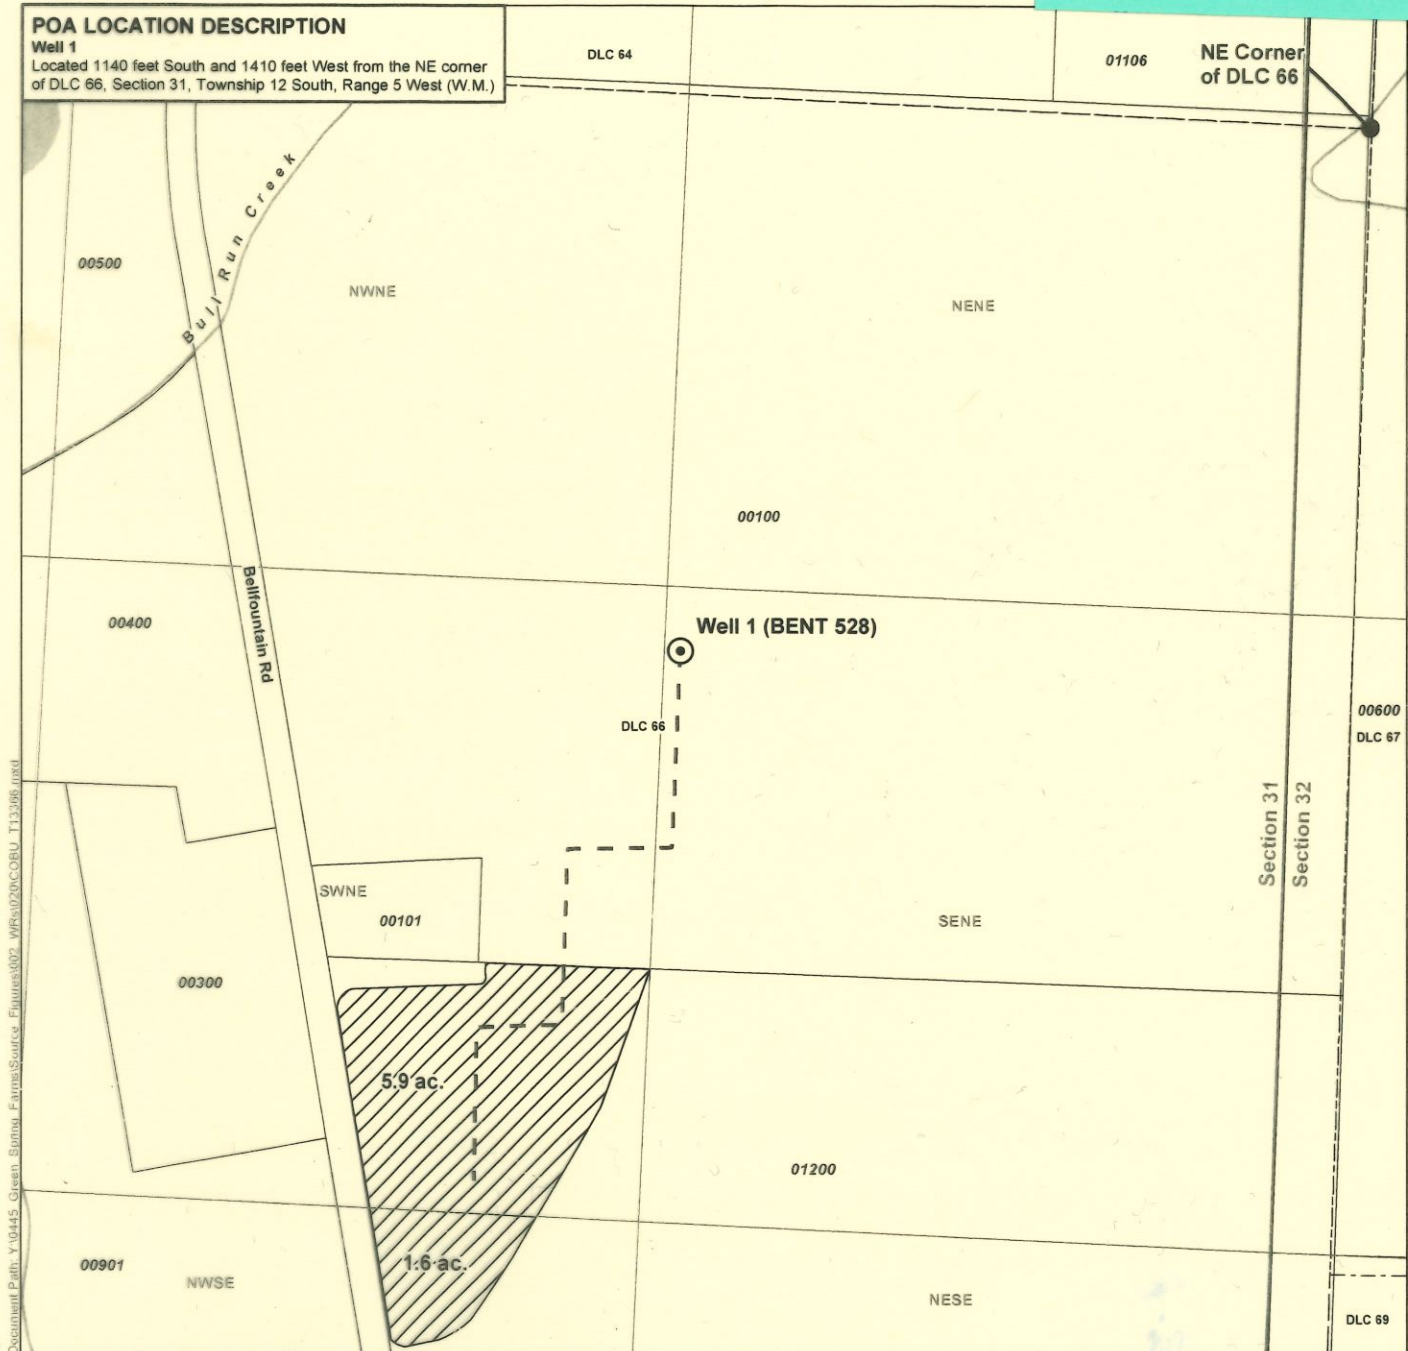

LEGEND

- ⊙ Authorized Point of Appropriation (POA)
- Mainline
- ▨ Place Of Use (POU)
- All Other Features
 - Donation Land Claim (DLC)
 - ⊞ Tax Lot
 - ~ Watercourse

Certified Water Rights Examiner Stamp

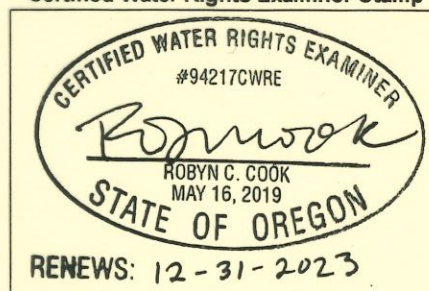

DISCLAIMER

This map was prepared for the purpose of identifying the location of a water right only and it is not intended to provide legal dimensions or location of property ownership lines.

MAP NOTES

Date: April 18, 2023
Data Sources: USGS, BLM, ESRI, Benton Co.

