

Claim Map for Transfer Order T-13390 Lane County Tax Lots
200 and 301 in Township 18S Range 2W Section 9
of the Willamette Meridian


Point of Diversion, Pump, Meter, and Fish
Screen 1183 Ft. S and 706 Ft. W of
NE Corner of Section 9

THIS MAP IS NOT INTENDED TO PROVIDE
LEGAL DIMENSIONS OR LOCATIONS OF
PROPERTY OWNERSHIP LINES.

AUG 18 2023

OWRD

Legend

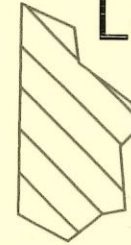

Irrigation Areas



Property Boundary

Section Lines

Quarter Section Lines

Quarter Quarter Lines




Tax Lot
Boundaries

Buried 4-Inch
PVC

Proposed Irrigation by 1/4 1/4, Glot, and DLC

Township	Range	Section	Qtr 40	Qtr 160	Tax Lot	Glot	DLC	Acerage
18S	2W	9	NW	NE	200	-	48	7.66
18S	2W	9	SW	NE	200	-	48	4.94
18S	2W	9	SE	NE	200	-	48	10.06
18S	2W	9	SE	NE	301	-	48	2.66
18S	2W	9	NE	NE	200	-	48	4.55
Total								29.87

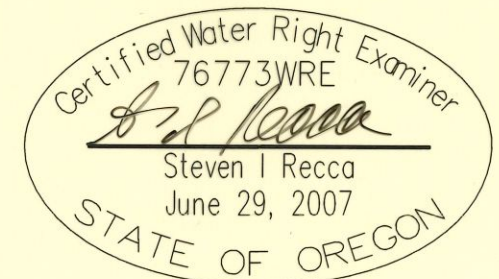

EXPIRATION DATE 12/31/24

