


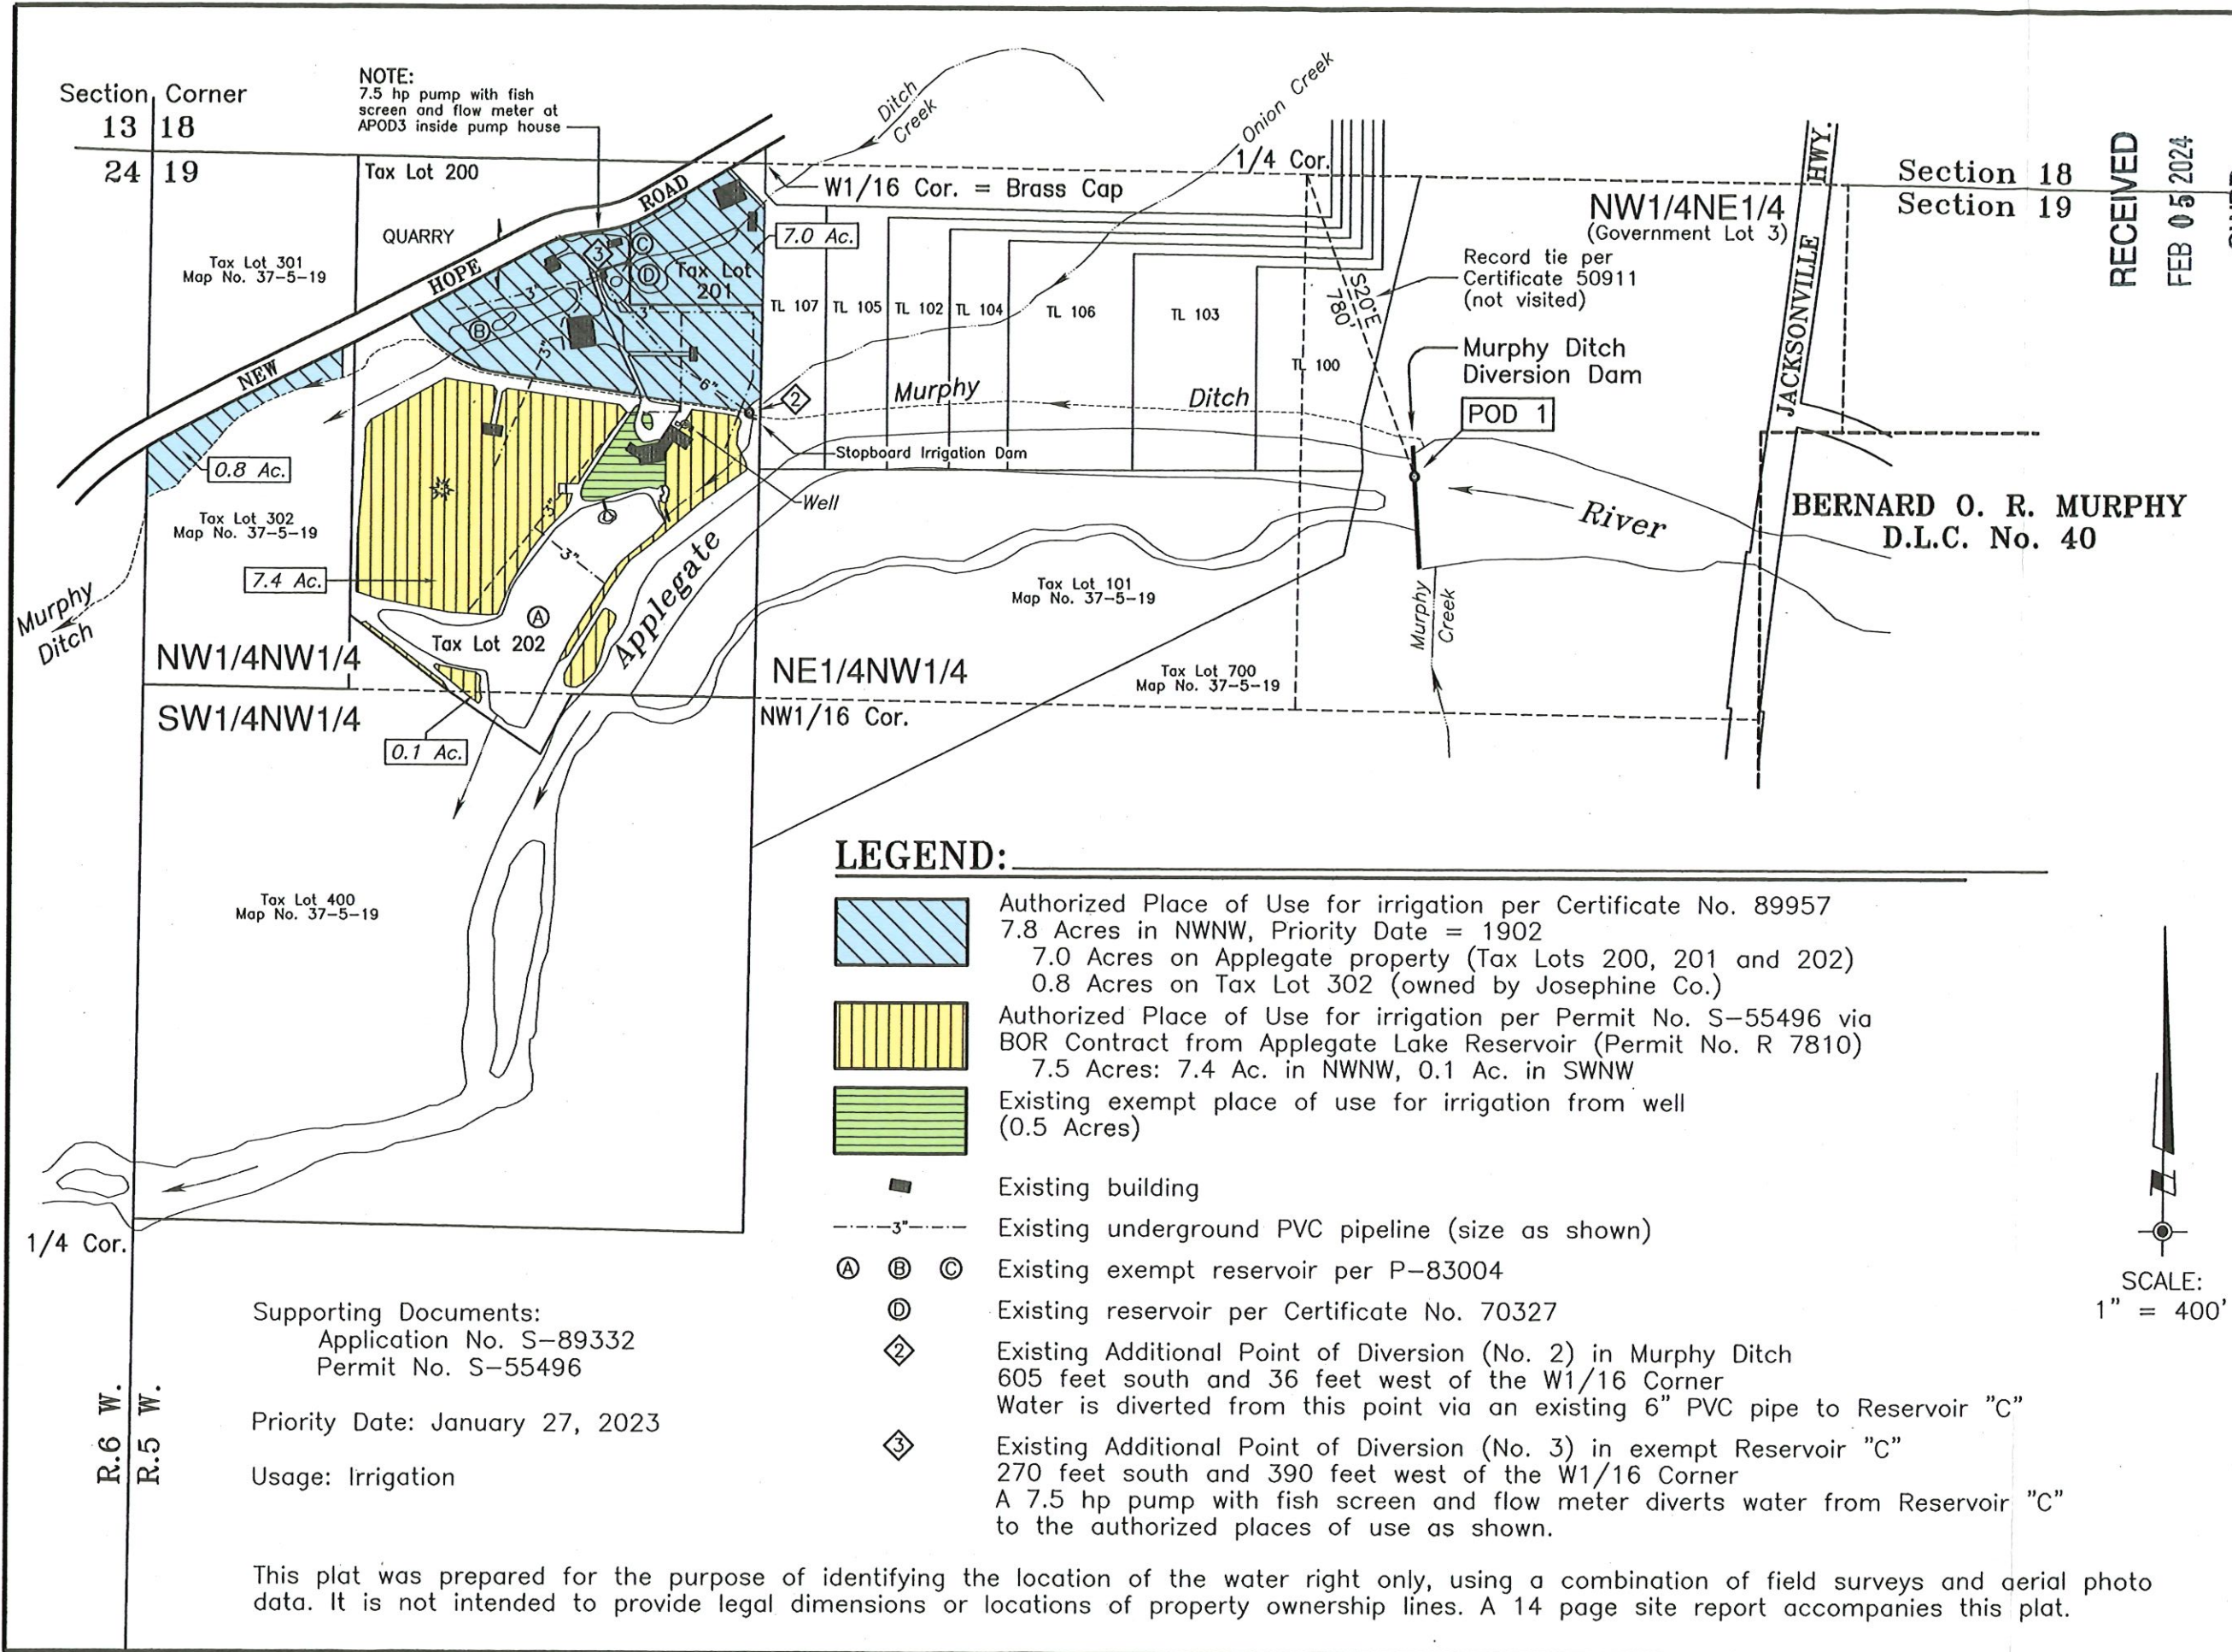

NOTE:
7.5 hp pump with fish
screen and flow meter at
APOD3 inside pump house

LEGEND:

- Authorized Place of Use for irrigation per Certificate No. 89957
7.8 Acres in NWNW, Priority Date = 1902
7.0 Acres on Applegate property (Tax Lots 200, 201 and 202)
0.8 Acres on Tax Lot 302 (owned by Josephine Co.)
- Authorized Place of Use for irrigation per Permit No. S-55496 via
BOR Contract from Applegate Lake Reservoir (Permit No. R 7810)
7.5 Acres: 7.4 Ac. in NWNW, 0.1 Ac. in SWNW
- Existing exempt place of use for irrigation from well
(0.5 Acres)
- Existing building
- Existing underground PVC pipeline (size as shown)
- Existing exempt reservoir per P-83004
- Existing reservoir per Certificate No. 70327
- Existing Additional Point of Diversion (No. 2) in Murphy Ditch
605 feet south and 36 feet west of the W1/16 Corner
Water is diverted from this point via an existing 6" PVC pipe to Reservoir "C"
- Existing Additional Point of Diversion (No. 3) in exempt Reservoir "C"
270 feet south and 390 feet west of the W1/16 Corner
A 7.5 hp pump with fish screen and flow meter diverts water from Reservoir "C"
to the authorized places of use as shown.

Supporting Documents:
Application No. S-89332
Permit No. S-55496

Priority Date: January 27, 2023

Usage: Irrigation

This plat was prepared for the purpose of identifying the location of the water right only, using a combination of field surveys and aerial photo data. It is not intended to provide legal dimensions or locations of property ownership lines. A 14 page site report accompanies this plat.


RECEIVED
FEB 05 2024
OWRD

BERNARD O. R. MURPHY
D.L.C. No. 40

SCALE:
1" = 400'

CLAIM OF BENEFICIAL USE MAP FOR S-55496

LOCATED IN
W1/2NW1/4 of Section 19
Township 37 South, Range 5 West, W.M.
Josephine County, Oregon

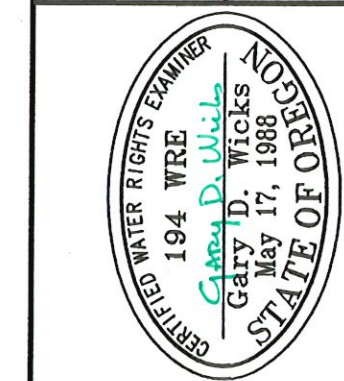

PROJECT NO.	1405-22-504
DRAWING NO.	196-11.17
DATE	1-31-24
SCALE	1" = 400'
SHEET NO	1 of 1

PREPARED FOR:
Andrea Applegate
7980 New Hope Road
Grants Pass, Oregon 97527
Tel. 541-291-8611

PREPARED BY:
WICKS ENGINEERING & SURVEYING
311 N.E. "D" Street
Grants Pass, Oregon 97526
Tel. 541-479-3436